




PLAT OF SURVEY

OUTLOT 52 OF THE ASSESSOR'S PLAT NO. 1 AMENDED
TO THE VILLAGE OF FONTANA, WALWORTH COUNTY,
WISCONSIN.

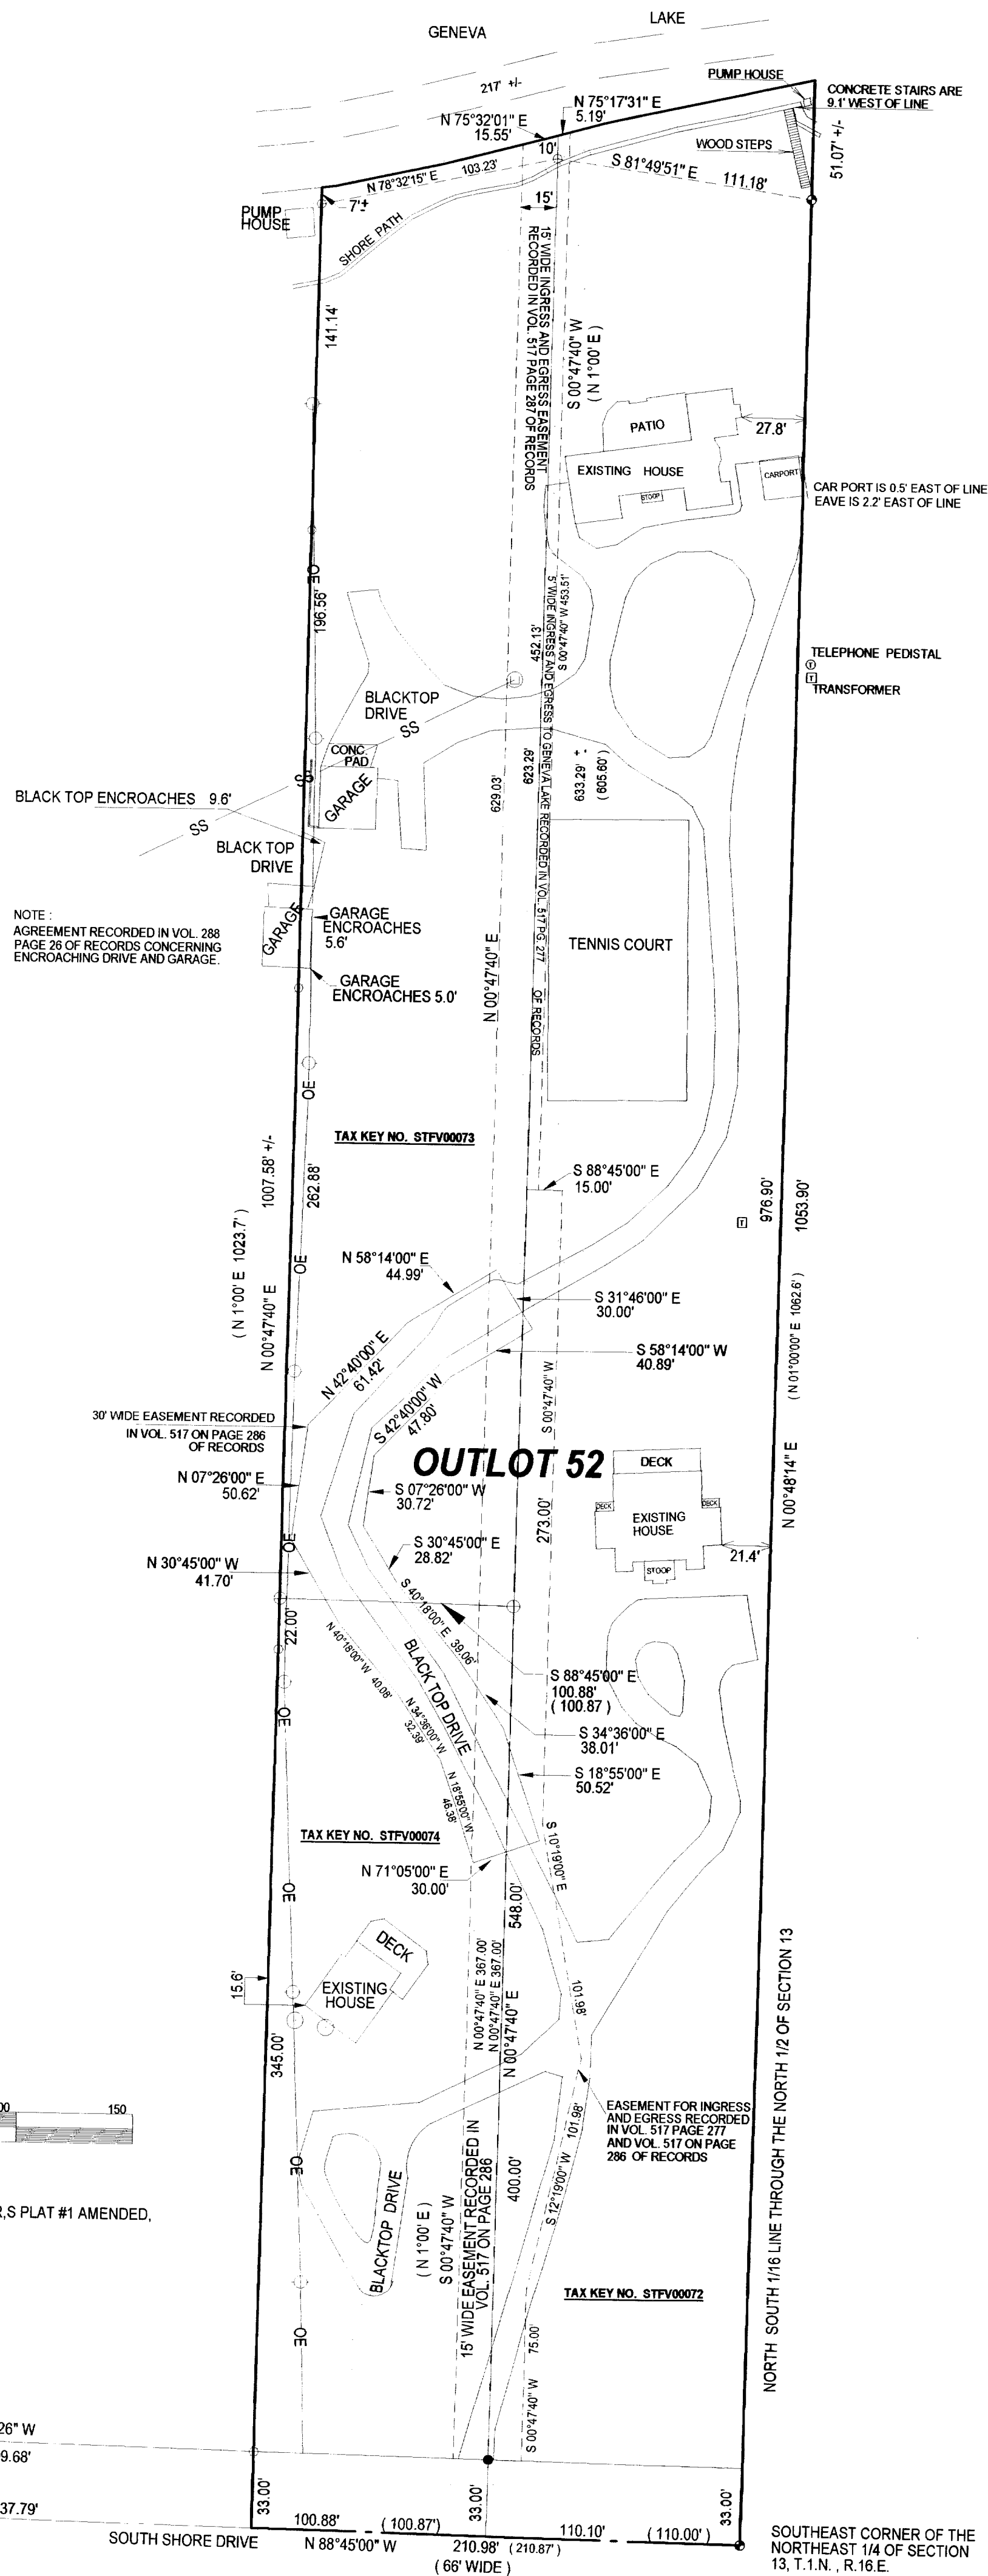

LEGEND

- FOUND 5" DIA CONCRETE MONUMENT WITH IRON ROD IN CENTER
- FOUND CONCRETE MONUMENT WITH BRASS CAP
- FOUND IRON PIPE
- SET IRON PIPE
- FOUND RAIL ROAD SPIKE IN BLACKTOP DRIVE
- UTILITY POLE
- OVER HEAD UTILITIES
- PRIVATE SEWAGE SYSTEM MANHOLE
- PUBLIC SANITARY SEWER MANHOLE
- RECORDED AS
- SANITARY SEWER LINE

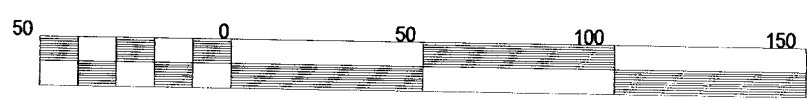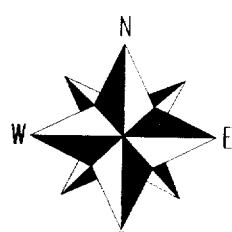

Scale 1" = 50'

BEARINGS ARE REFERENCED TO THE ASSESSOR'S PLAT #1 AMENDED,
VILLAGE OF FONTANA-ON-GENEVA LAKE

SOUTH WEST CORNER OF
THE NORTHEAST 1/4 OF
SECTION 13, T.1.N., R.16.E

SOUTHEAST CORNER OF THE
NORTHEAST 1/4 OF SECTION
13, T.1.N., R.16.E

THE ABOVE MAP IS A TRUE REPRESENTATION THEREOF AND
SHOWS THE SIZE AND LOCATION OF ALL THE PROPERTY,
EXTERIOR BOUNDARIES, THE LOCATION OF ALL VISIBLE
BOUNDARY FENCES, APPARENT EASEMENTS, ROADWAYS
AND VISIBLE ENCROACHMENTS, IF ANY.

THIS SURVEY IS MADE FOR THE USE OF THE PRESENT
OWNERS OF THE PROPERTY, AND ALSO THOSE WHO
PURCHASE, MORTGAGE OR GUARANTEE TITLE THERETO
WITHIN ONE (1) YEAR FROM DATE HERETO.

JOHN P. KROTT, R.L.S. 2258

DATE OF LAST REVISION 10-3-05
REVISED: 2/27/2001
DATE: 2/11/1999

JOB NUMBER: 99-017-FON-STFV00073 & 74

STFV-72

005 - 2346