

PREPARED FOR:
TOM McDONOUGH
7426 OXFORD GARDEN CIRCLE
APOLLO BEACH, FL. 33572



PLAT OF SURVEY

- OF -

LOT FIVE (5), BLOCK THREE (3), ASSESSOR'S PLAT NUMBER ONE (1),
C. L. DOUGLASS ADDITION TO THE VILLAGE OF FONTANA, WALWORTH
COUNTY, WISCONSIN. EXCEPTING THE NORTH 20 FEET OF SAID LOT 5.

RECEIVED
MAY - 4 2006
SMF

PATHFINDER SURVEYING, INC.
N3705 WILLOWBEND LANE
LAKE GENEVA, WI, 53147
262-248-3697

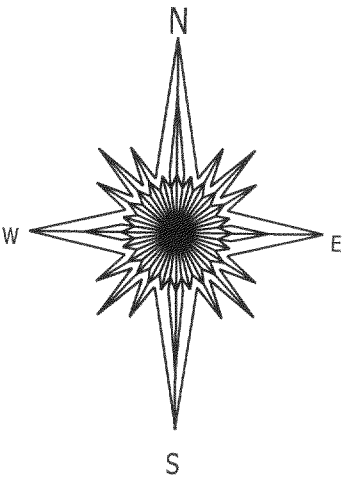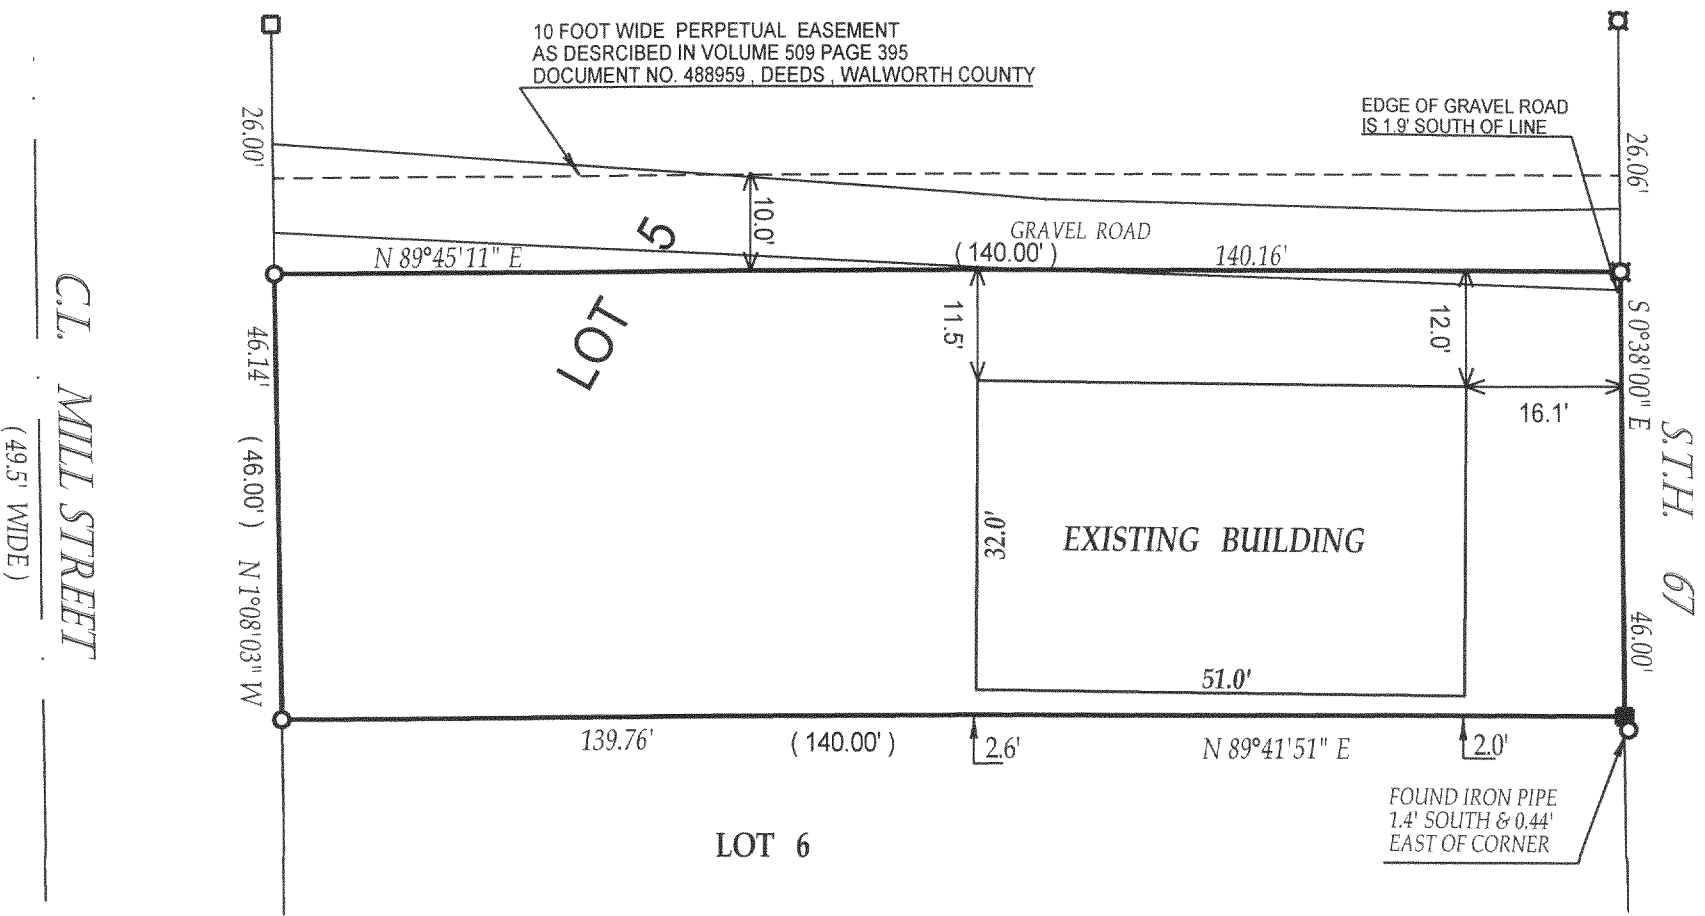

- () = recorded as
- = found iron bar
- = found iron pipe
- = set iron pipe
- = set iron bar
- ∅ = power pole

SCALE 1" = 20'

JOB # 05-642

TAX ID # STFV00199A

COMPARE LEGAL DESCRIPTION ABOVE AND DRAWING WITH DEED. FOR BUILDING RESTRICTIONS AND
EASEMENTS NOT SHOWN, REFER TO DEED, ABSTRACT SOURCES AND LOCAL MUNICIPAL CODES. NOTIFY
THE SURVEYOR IMMEDIATELY OF ANY DISCREPANCY.

"I hereby certify that I have surveyed the above described property and that
the above map is a true representation thereof and shows the size and
location of all visible structures, apparent easements and encroachments
if any."
This survey is made for the present owners of the property, and those who
purchase, mortgage, or guarantee the title thereto, within one year from
the date hereof.

DATED THIS 16th, DAY OF DECEMBER, 2005



John P. Krott

JOHN KROTT S - 2258
Wisconsin Registered Land Surveyor
(original if signed in red)

STFV - 199A

005-2376