
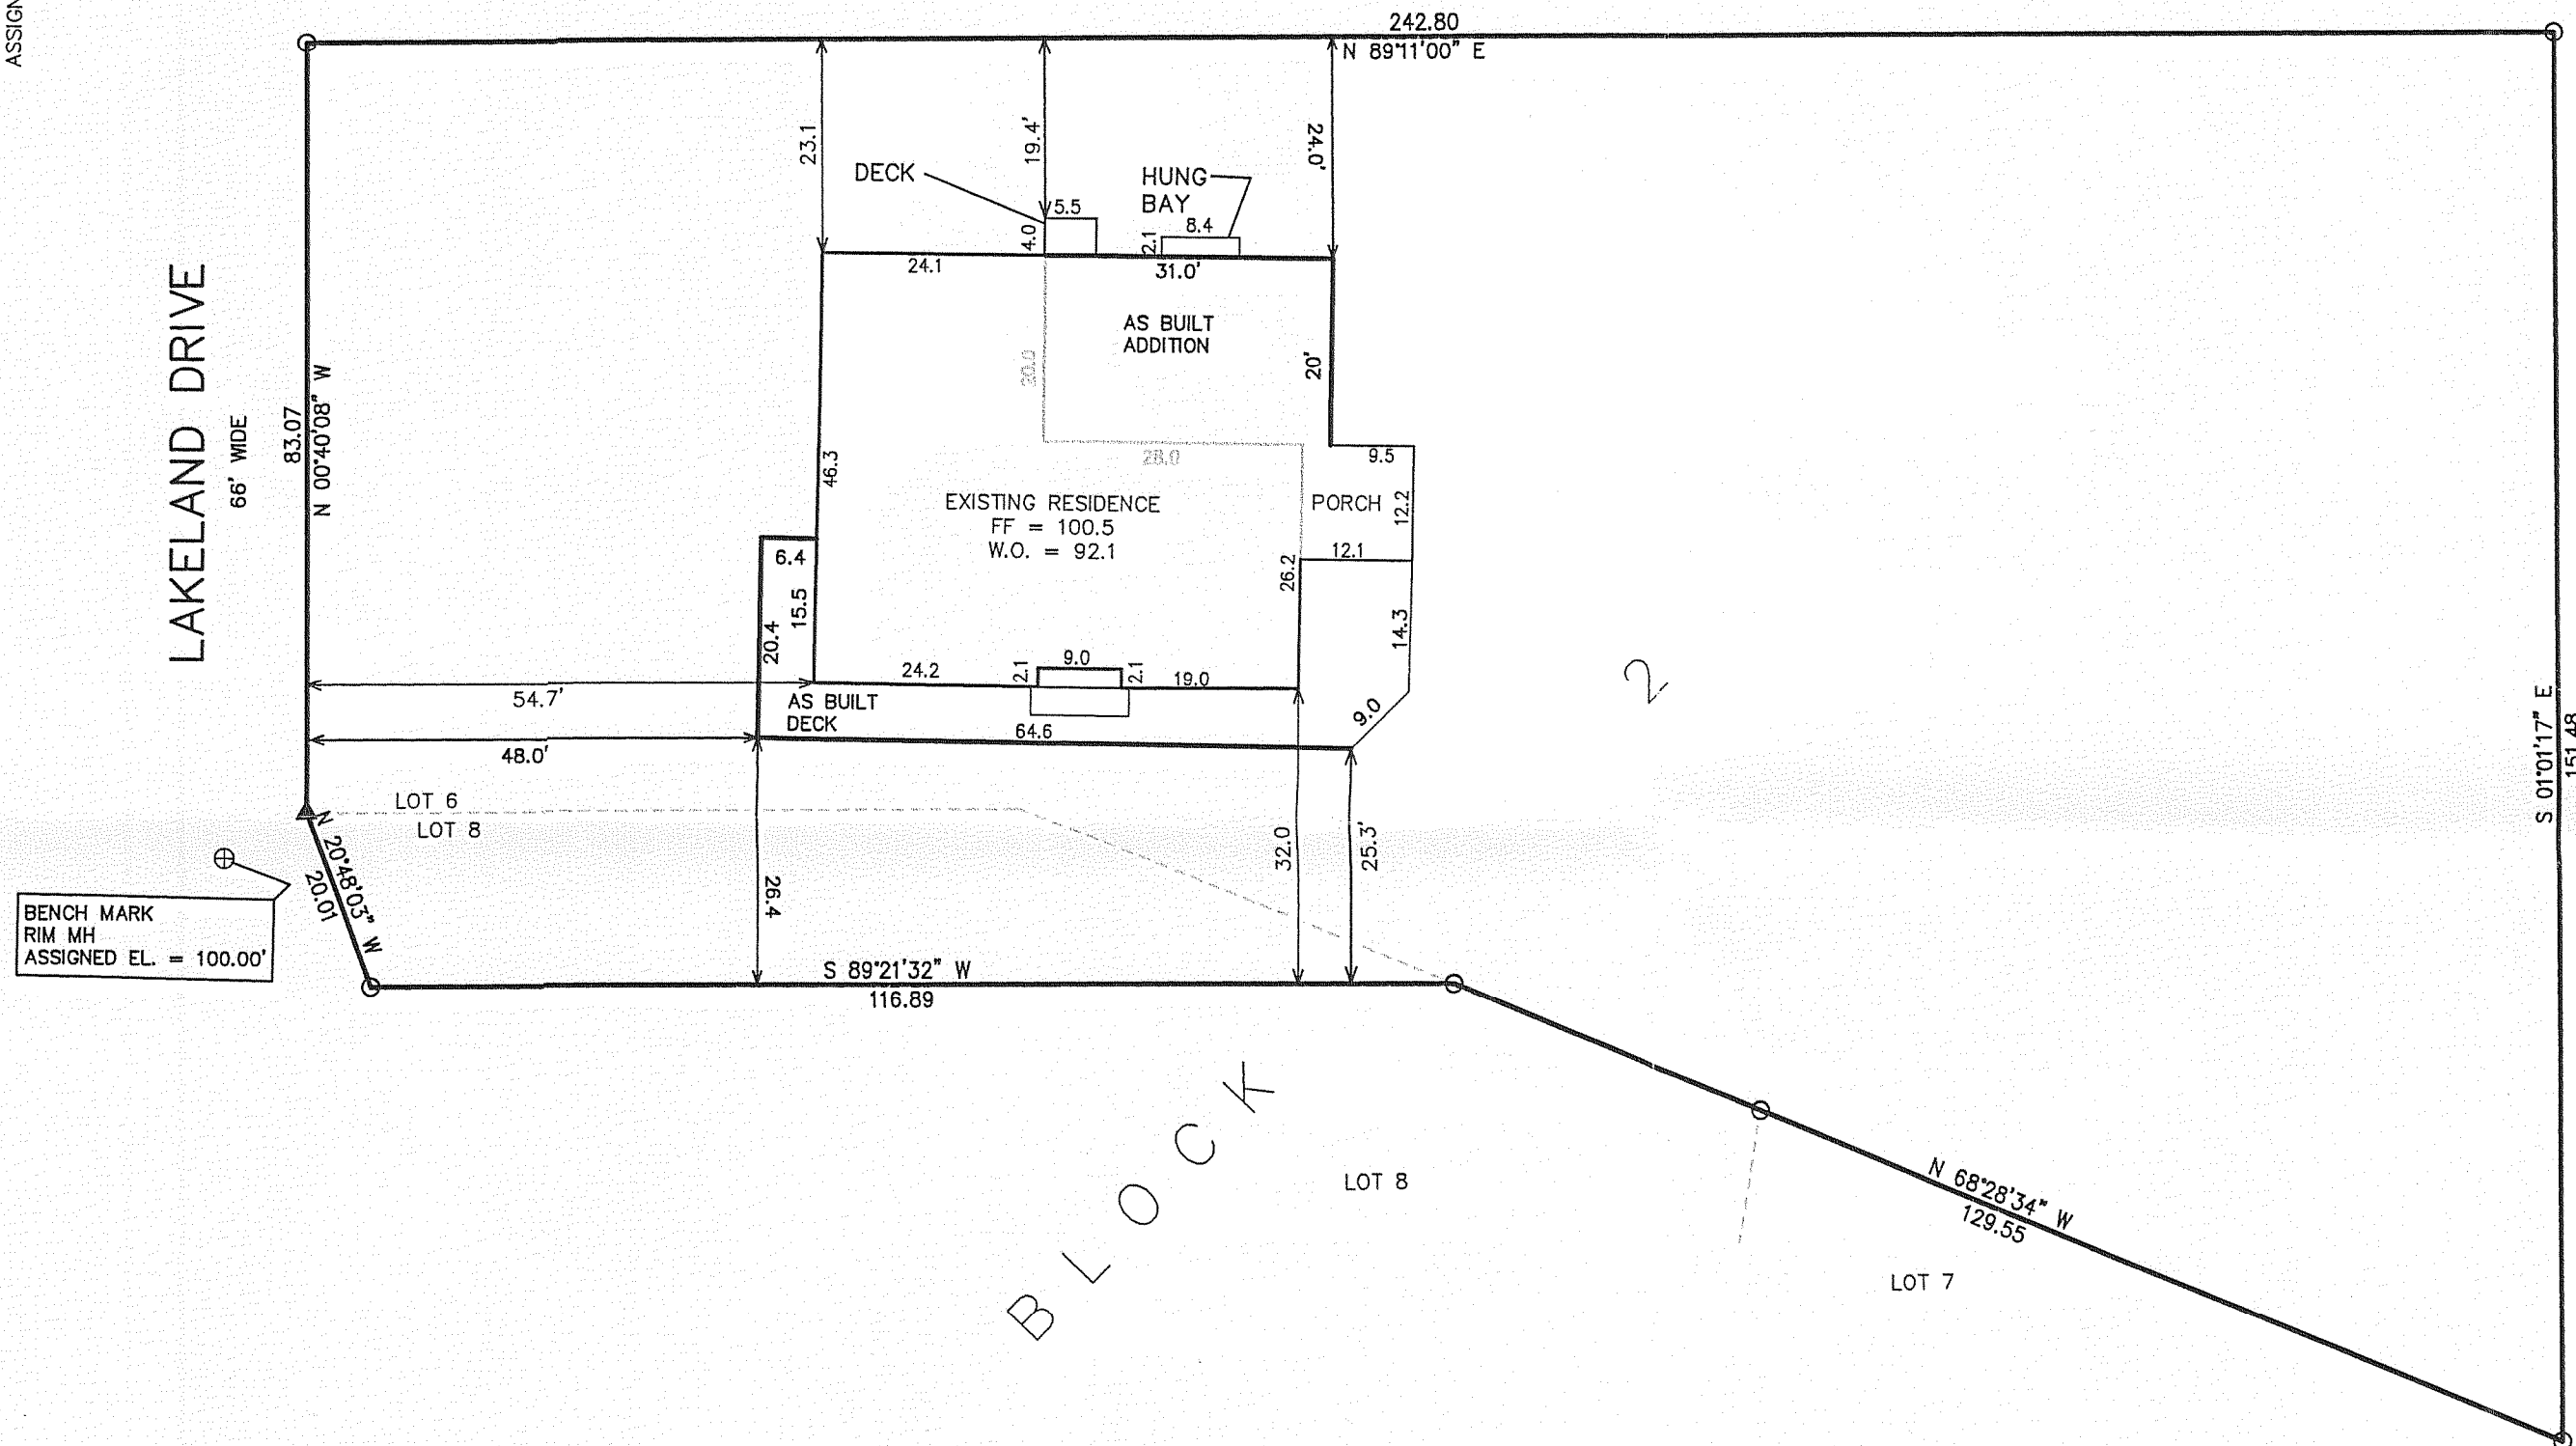


PLAT OF SURVEY PART OF BLOCK 2 OF BROOKWOOD SUBDIVISION

LOCATED IN THE NW 1/4 SECTION 18, T1N, R17 E.
VILLAGE OF FONTANA-ON-GENEVA LAKE
WALWORTH COUNTY, WISCONSIN

LOT 6, BLOCK 2, BROOKWOOD SUBDIVISION, VILLAGE OF FONTANA, IN THE NORTHWEST 1/4 OF SECTION 18, T 1 N, R 17 E OF WALWORTH COUNTY, WISCONSIN.

ALSO, A PART OF LOT 8, BLOCK 2 OF BROOKWOOD SUBDIVISION, LOCATED IN THE VILLAGE OF FONTANA-ON-GENEVA LAKE, WALWORTH COUNTY, WISCONSIN, DESCRIBED AS FOLLOWS: BEGINNING THE THE NORTHWEST CORNER OF SAID LOT 8, THENCE N89°09'E ALONG THE NORTH LINE OF SAID LOT 8, 78.17 FEET (RECORDED AS 78.36 FEET; THENCE S68°30'E ALONG THE NORTHERLY LINE OF SAID LOT 8, 49.41 FEET; THENCE S89°09'W 117.01 FEET TO THE WESTERLY LINE OF SAID LOT 8; THENCE N20°53'W ALONG SAID WESTERLY LINE 20.00 FEET TO THE PLACE OF BEGINNING.

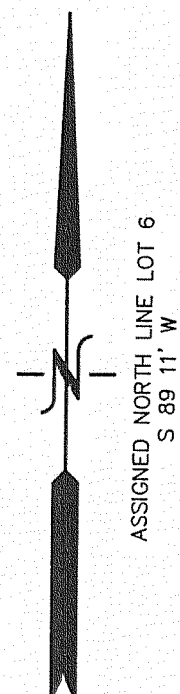

BENCH MARK
RIM MH
ASSIGNED EL. = 100.00'

BLOCK 2

LOT 8

LOT 7

Red
SMF
MAY 17 2006




NOTE: COPIES OF THIS MAP TO WHICH THE FOLLOWING CERTIFICATE WILL APPLY SHOW SURVEYOR'S ORIGINAL SEAL AND SIGNATURE IN RED INK. COPIES BY ANY OTHER MEANS MAY HAVE ALTERATIONS WHICH DO NOT REPRESENT THE SURVEYOR'S WORK PRODUCT.

I HEREBY CERTIFY THAT THE ABOVE DESCRIBED PROPERTY HAS BEEN SURVEYED UNDER MY DIRECTION AND THAT THE ABOVE MAP IS A TRUE REPRESENTATION THEREOF AND SHOWS THE SIZE AND LOCATION OF THE PROPERTY AND ITS EXTERIOR BOUNDARIES. THIS SURVEY IS MADE FOR THE USE OF THE PRESENT OWNERS OF THE PROPERTY, AND ALSO THOSE WHO PURCHASE, MORTGAGE, OR GUARANTEE THE TITLE THERETO WITHIN ONE YEAR FROM THE DATE HEREOF.

DATED: JULY 20, 2005

REVISED 05-08-2006
TO SHW SIZE & LOCATION OF
AS BUILT IMPROVEMENTS

Peter S. Gordon
PETER S. GORDON R.L.S. 2101

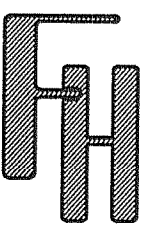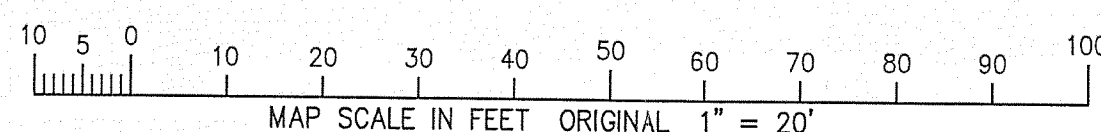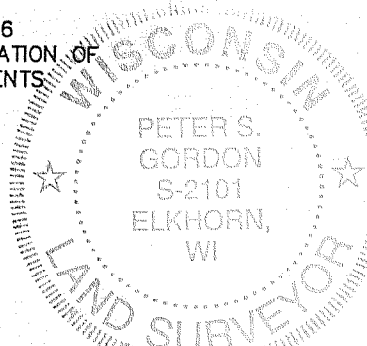

WORK ORDERED BY:
JORDNT BUILDERS
1916 HOBBS DRIVE
DELAVER, WI. 53115

FARRIS, HANSEN & ASSOCIATES, INC.
ENGINEERING - ARCHITECTURE - SURVEYING
7 RIDGWAY COURT P.O. BOX 437
ELKHORN, WISCONSIN 53121
OFFICE: (262) 723-2098 FAX: (262) 723-5886

REVISIONS

PROJECT NO.
6841
DATE:
07-20-05
SHEET NO.
1 OF 1

SBS - 19

005-2388