


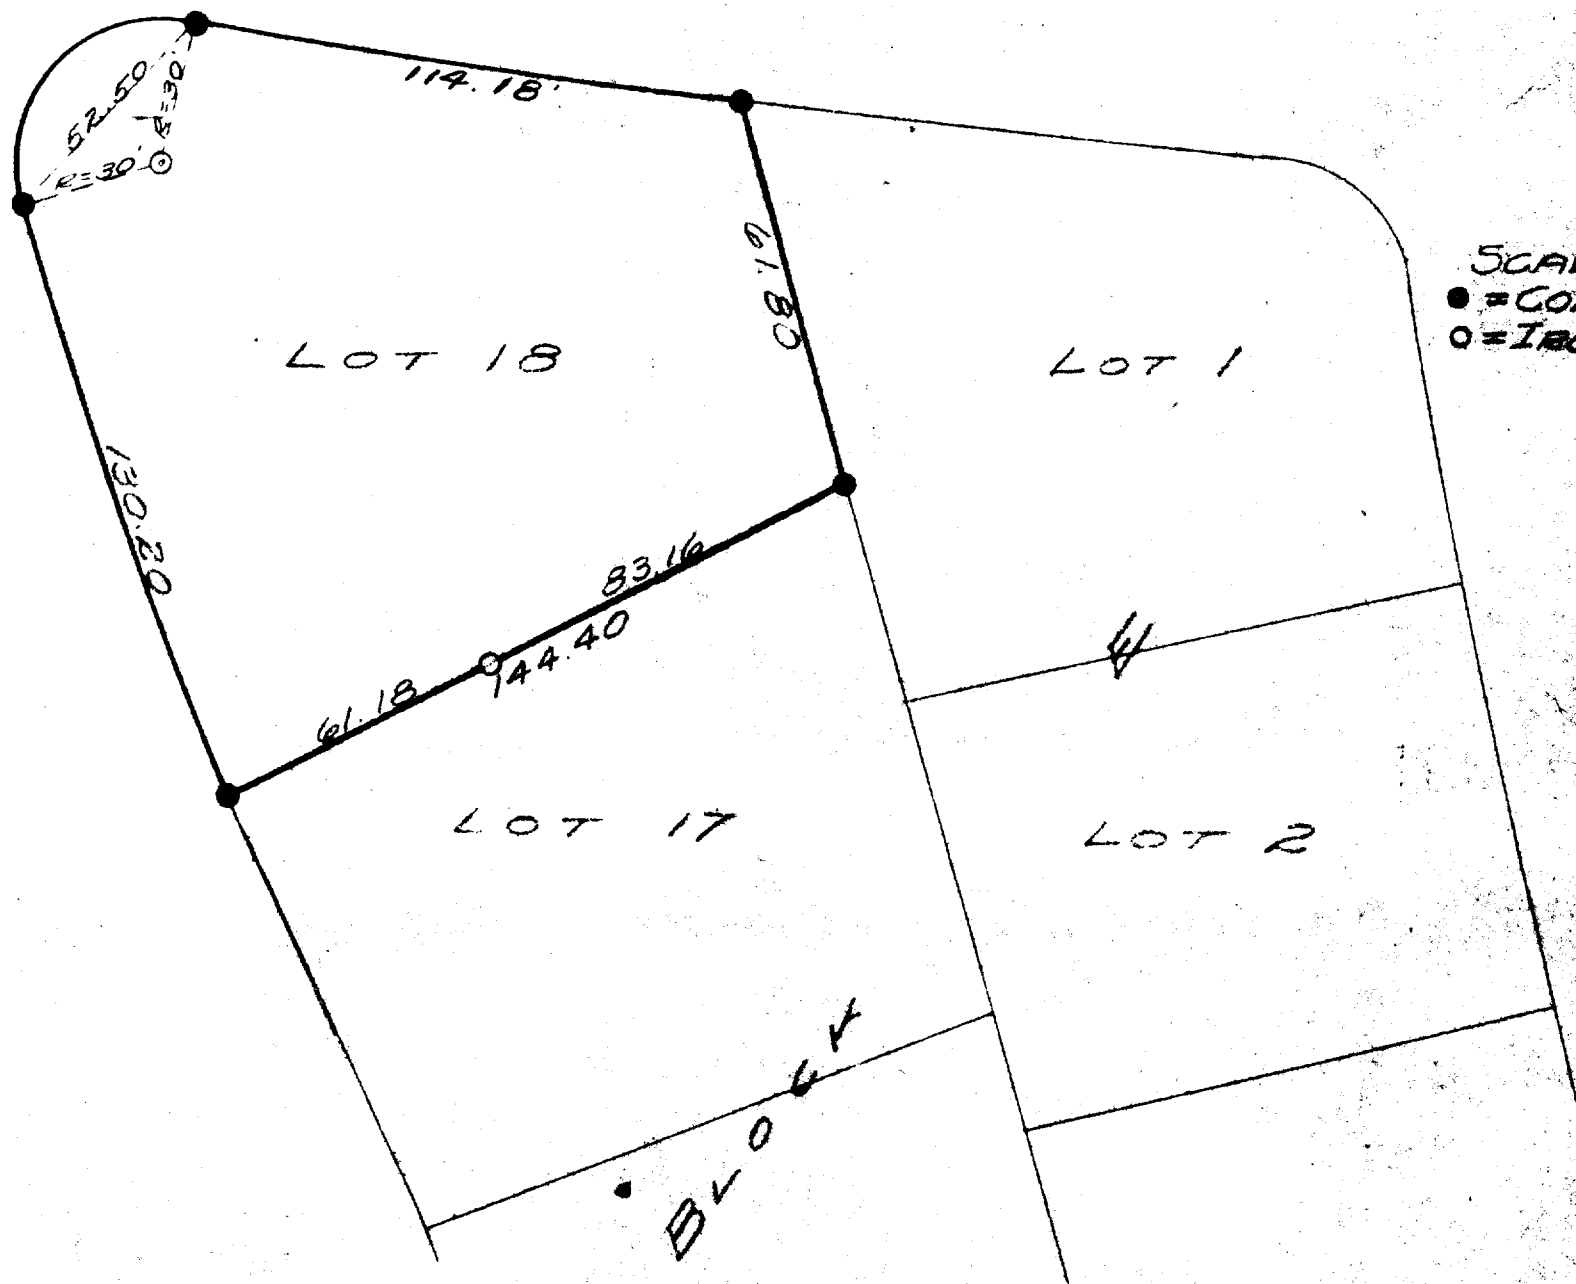

SCALE - 1" = 40'
 ● = CONC. MONUM.
 ○ = IRON PIPE

PLAT OF SURVEY OF LOT 18, BLOCK E OF UNIT 3, OF
 COUNTRY CLUB ESTATES, A SUBDIVISION LOCATED
 IN SECTIONS 14 AND 23, T1N, R1E OF WALWORTH COUNTY,
 WISCONSIN.
 Nov. 26, 1945

Sheldon L. Jensen
 COUNTY SURVEYOR