
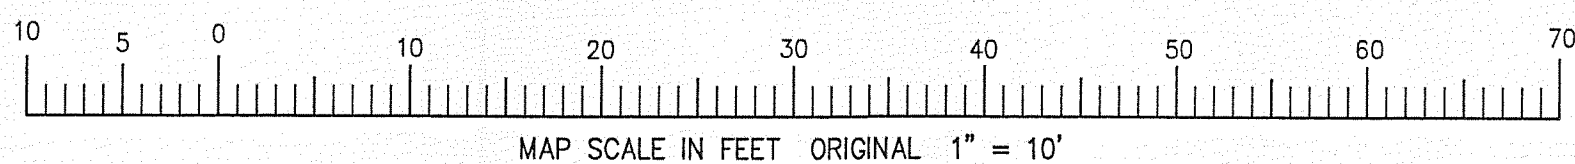


GENEVA LAKE
(115' +/- TO THE SHORE)
LAKE ELEV.=864.4'





NOTE: VERTICAL DATUM REFERENCED TO NATIONAL
GEODETIC VERTICAL DATUM OF 1929.

EXISTING RESIDENCE

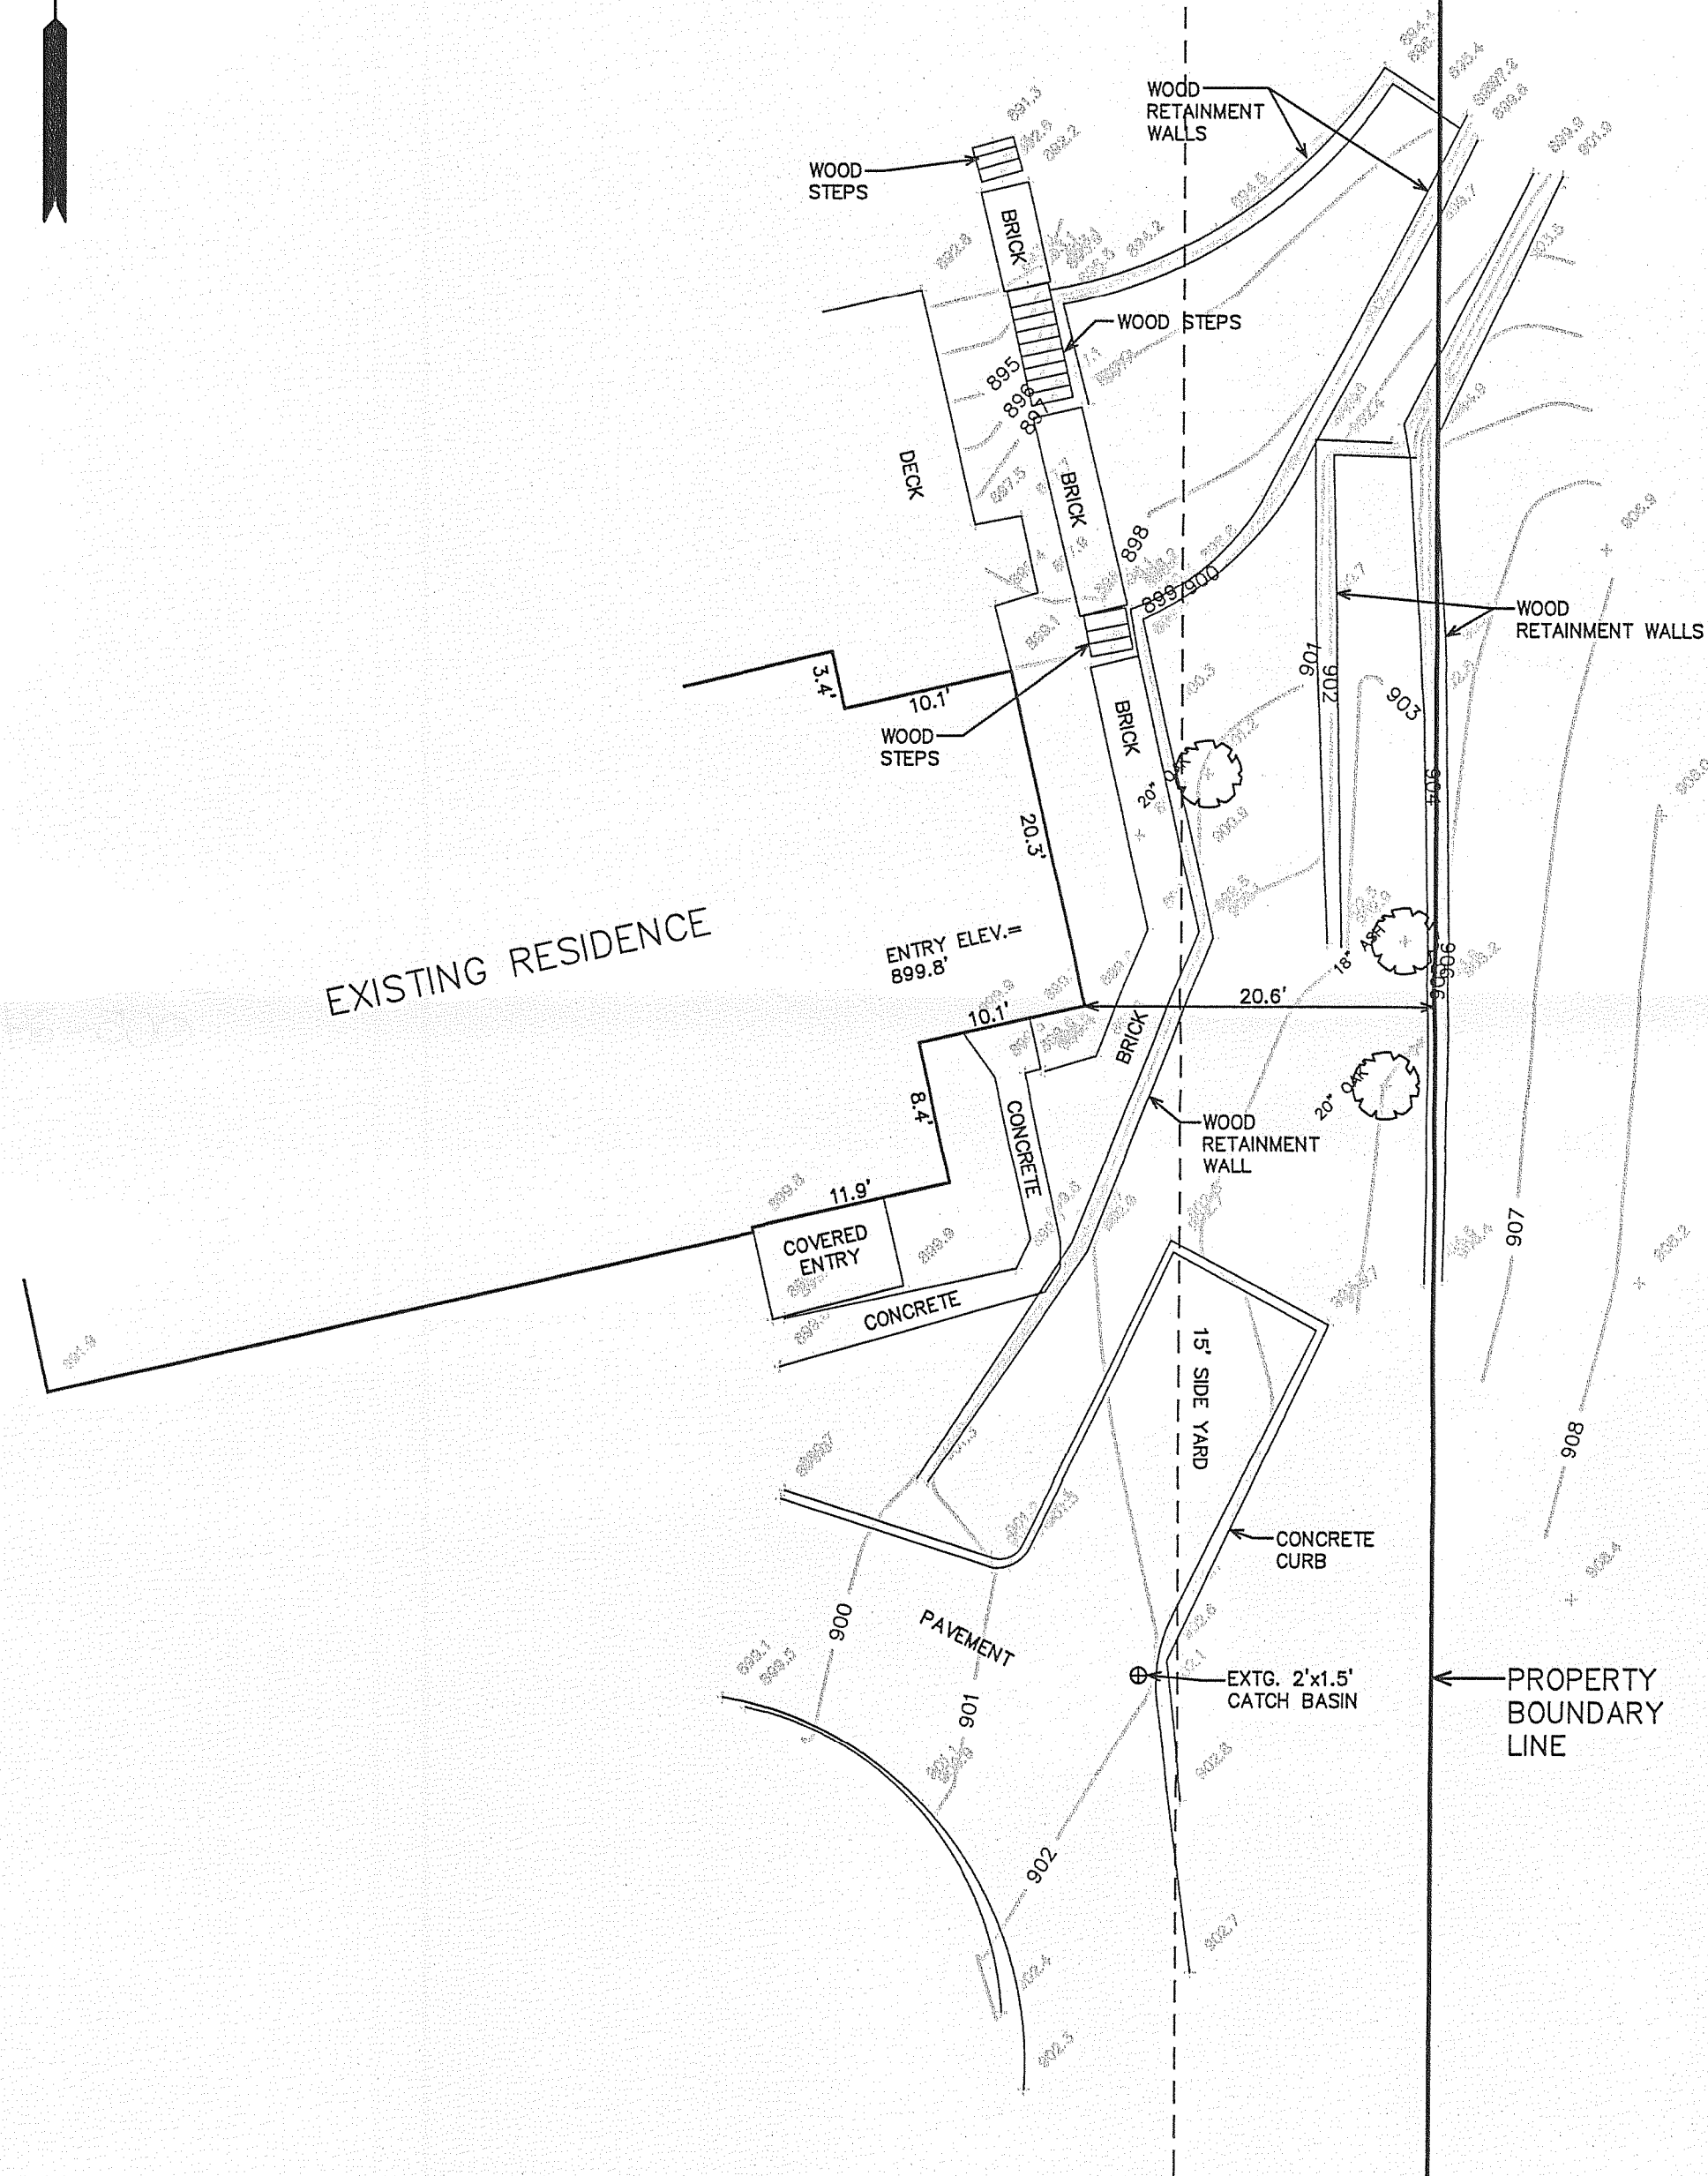

TOPOGRAPHICAL MAPPING

LOTS 17-19 AND THE WEST 15 FEET OF LOT 20,
BLOCK 1 OF INDIAN HILLS
LOCATED IN THE VILLAGE OF FONTANA-ON-GENEVA LAKE,
WALWORTH COUNTY, WISCONSIN

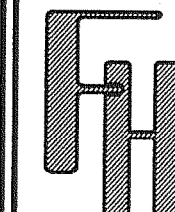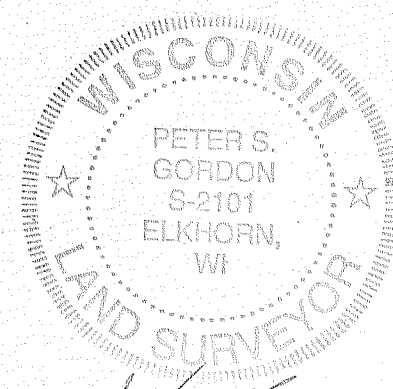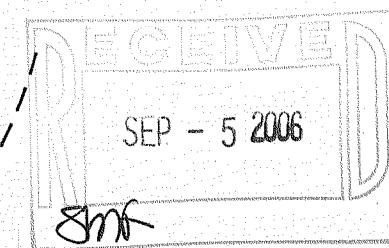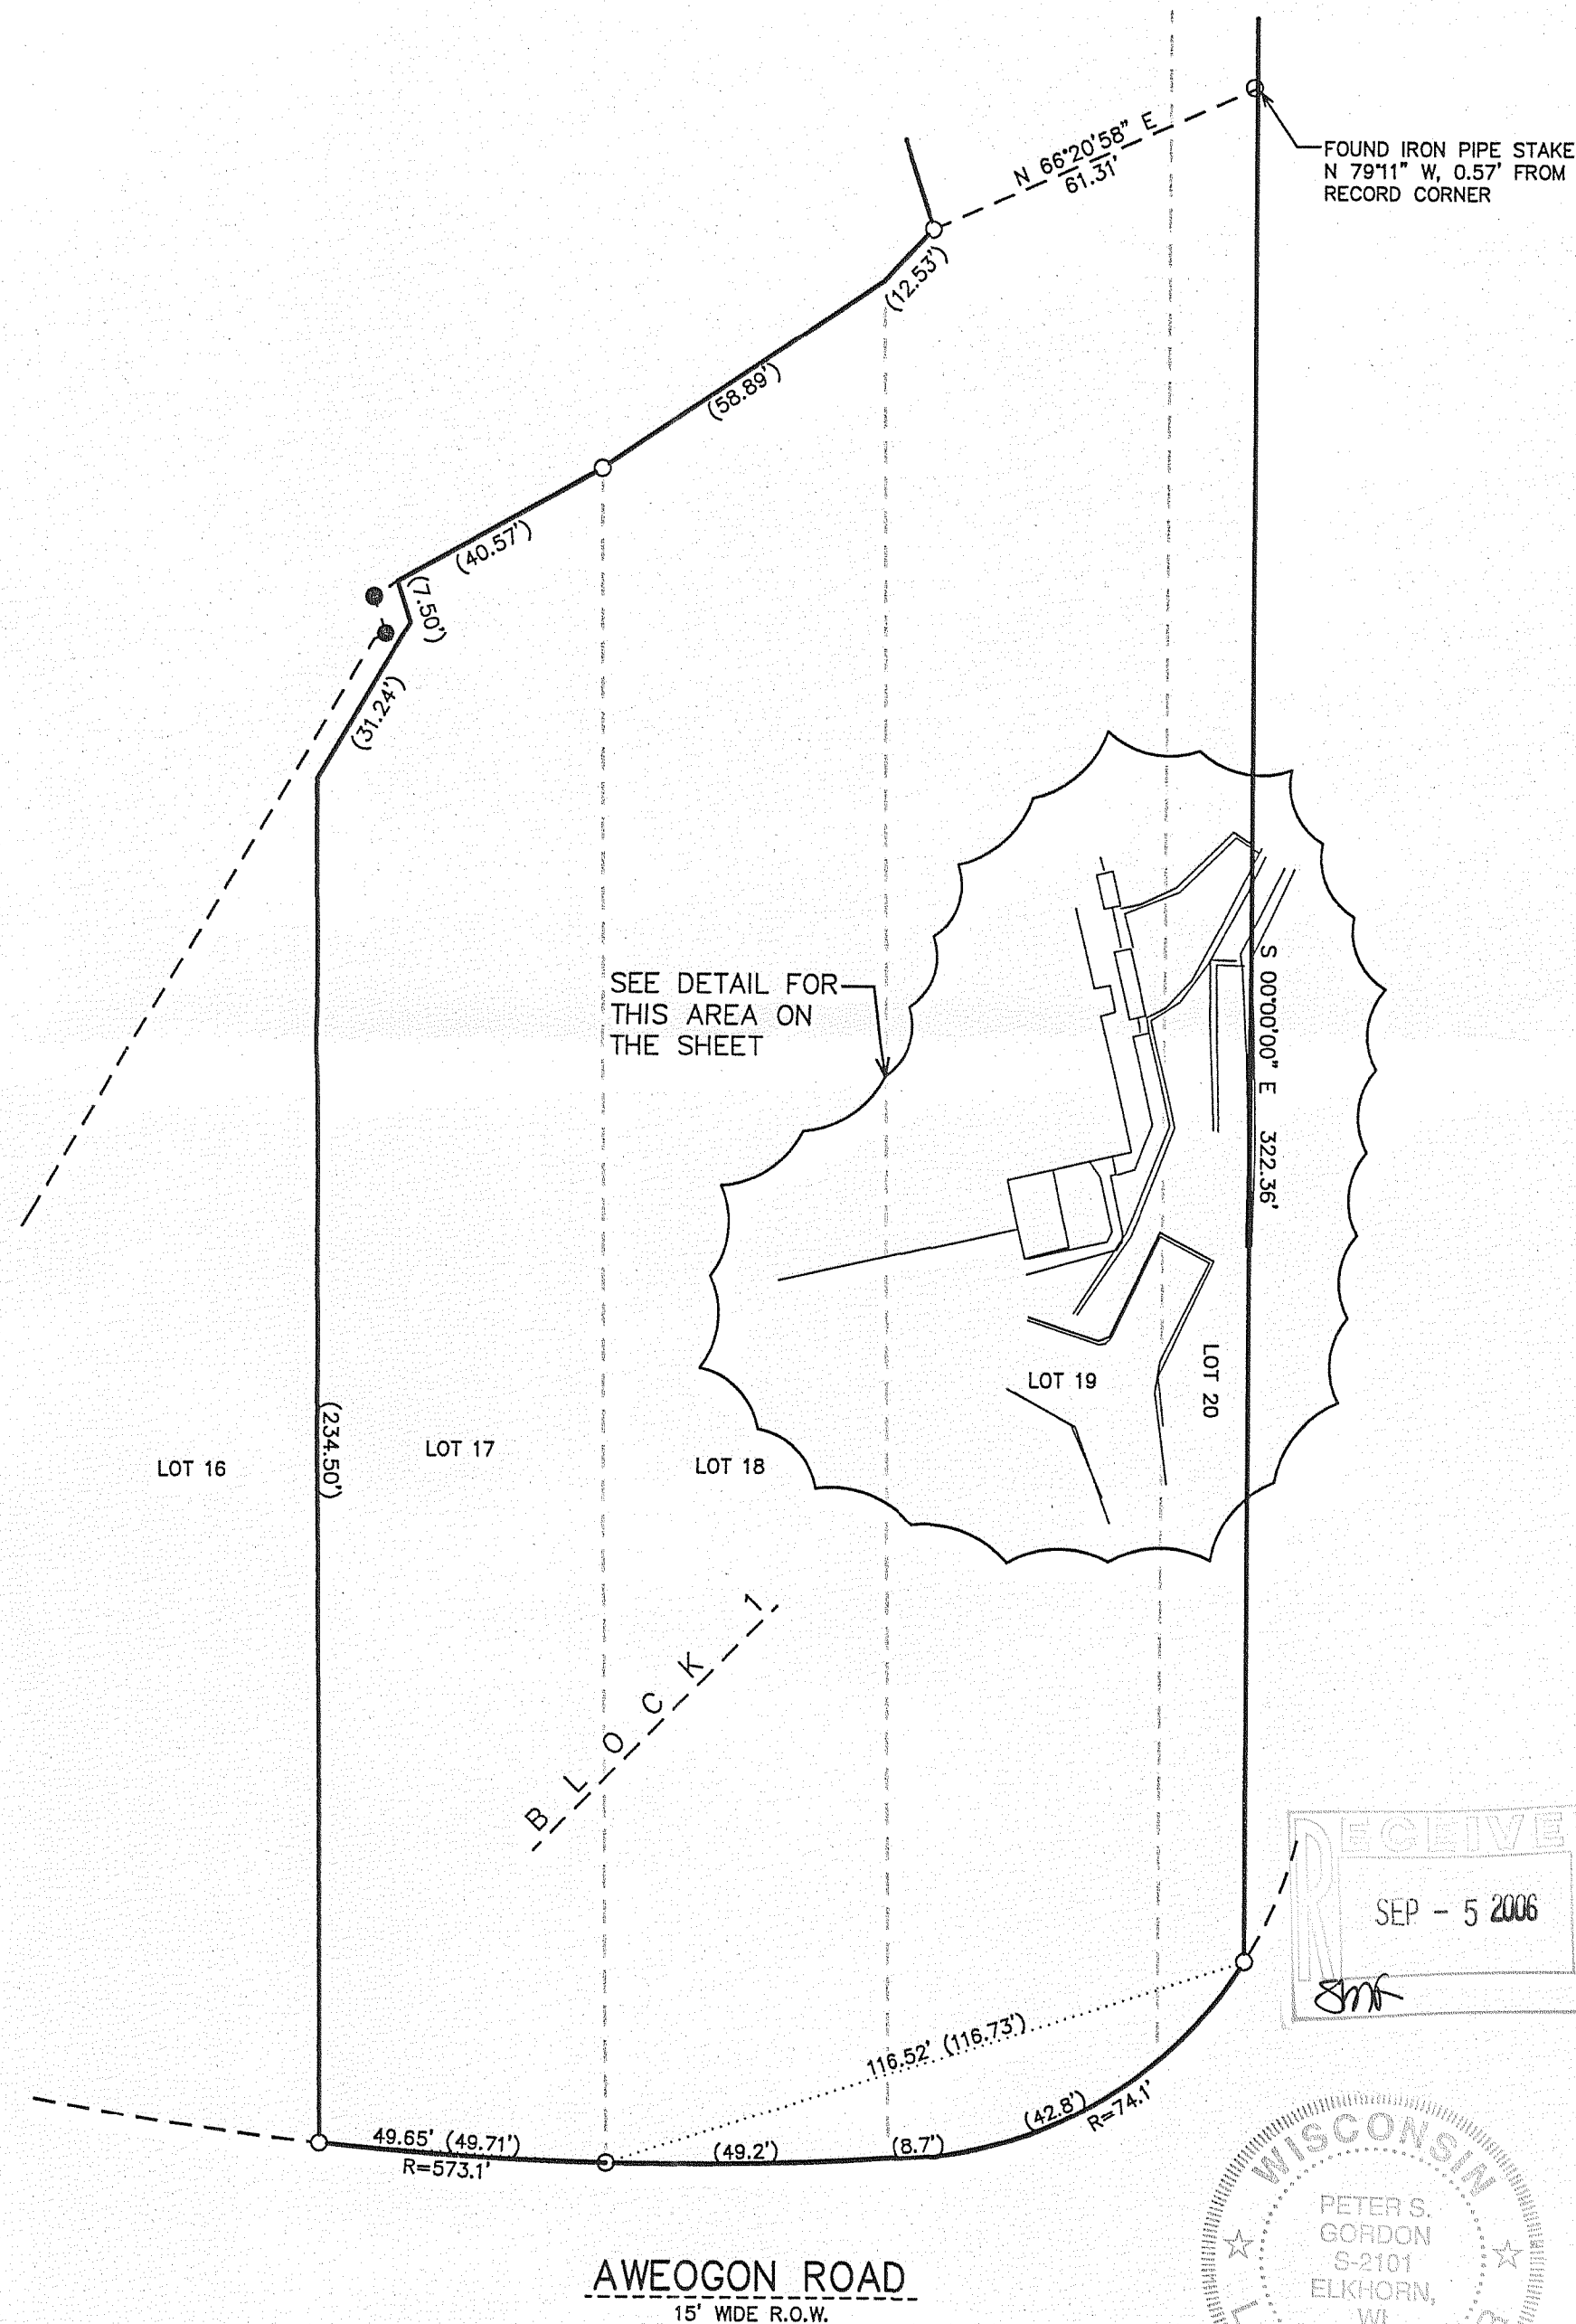

WORK ORDERED BY -
BILL KLEWIN
621 BOWERS BOULEVARD
DELAVER, WI 53115

FARRIS, HANSEN & ASSOCIATES, INC.
ENGINEERING - ARCHITECTURE - SURVEYING
7 RIDGWAY COURT P.O. BOX 437
ELKHORN, WISCONSIN 53121
OFFICE: (262) 723-2098 FAX: (262) 723-5886

REVISIONS

PROJECT NO.
7114
DATE:
08/02/06
SHEET NO.
1 OF 1

X:\Projects\7114 Dcad\TOPO

SLH-18

005-2410