


GEORGE T. DUNHAM
SURVEYING & SUBDIVIDING
DELAVAN, WISCONSIN

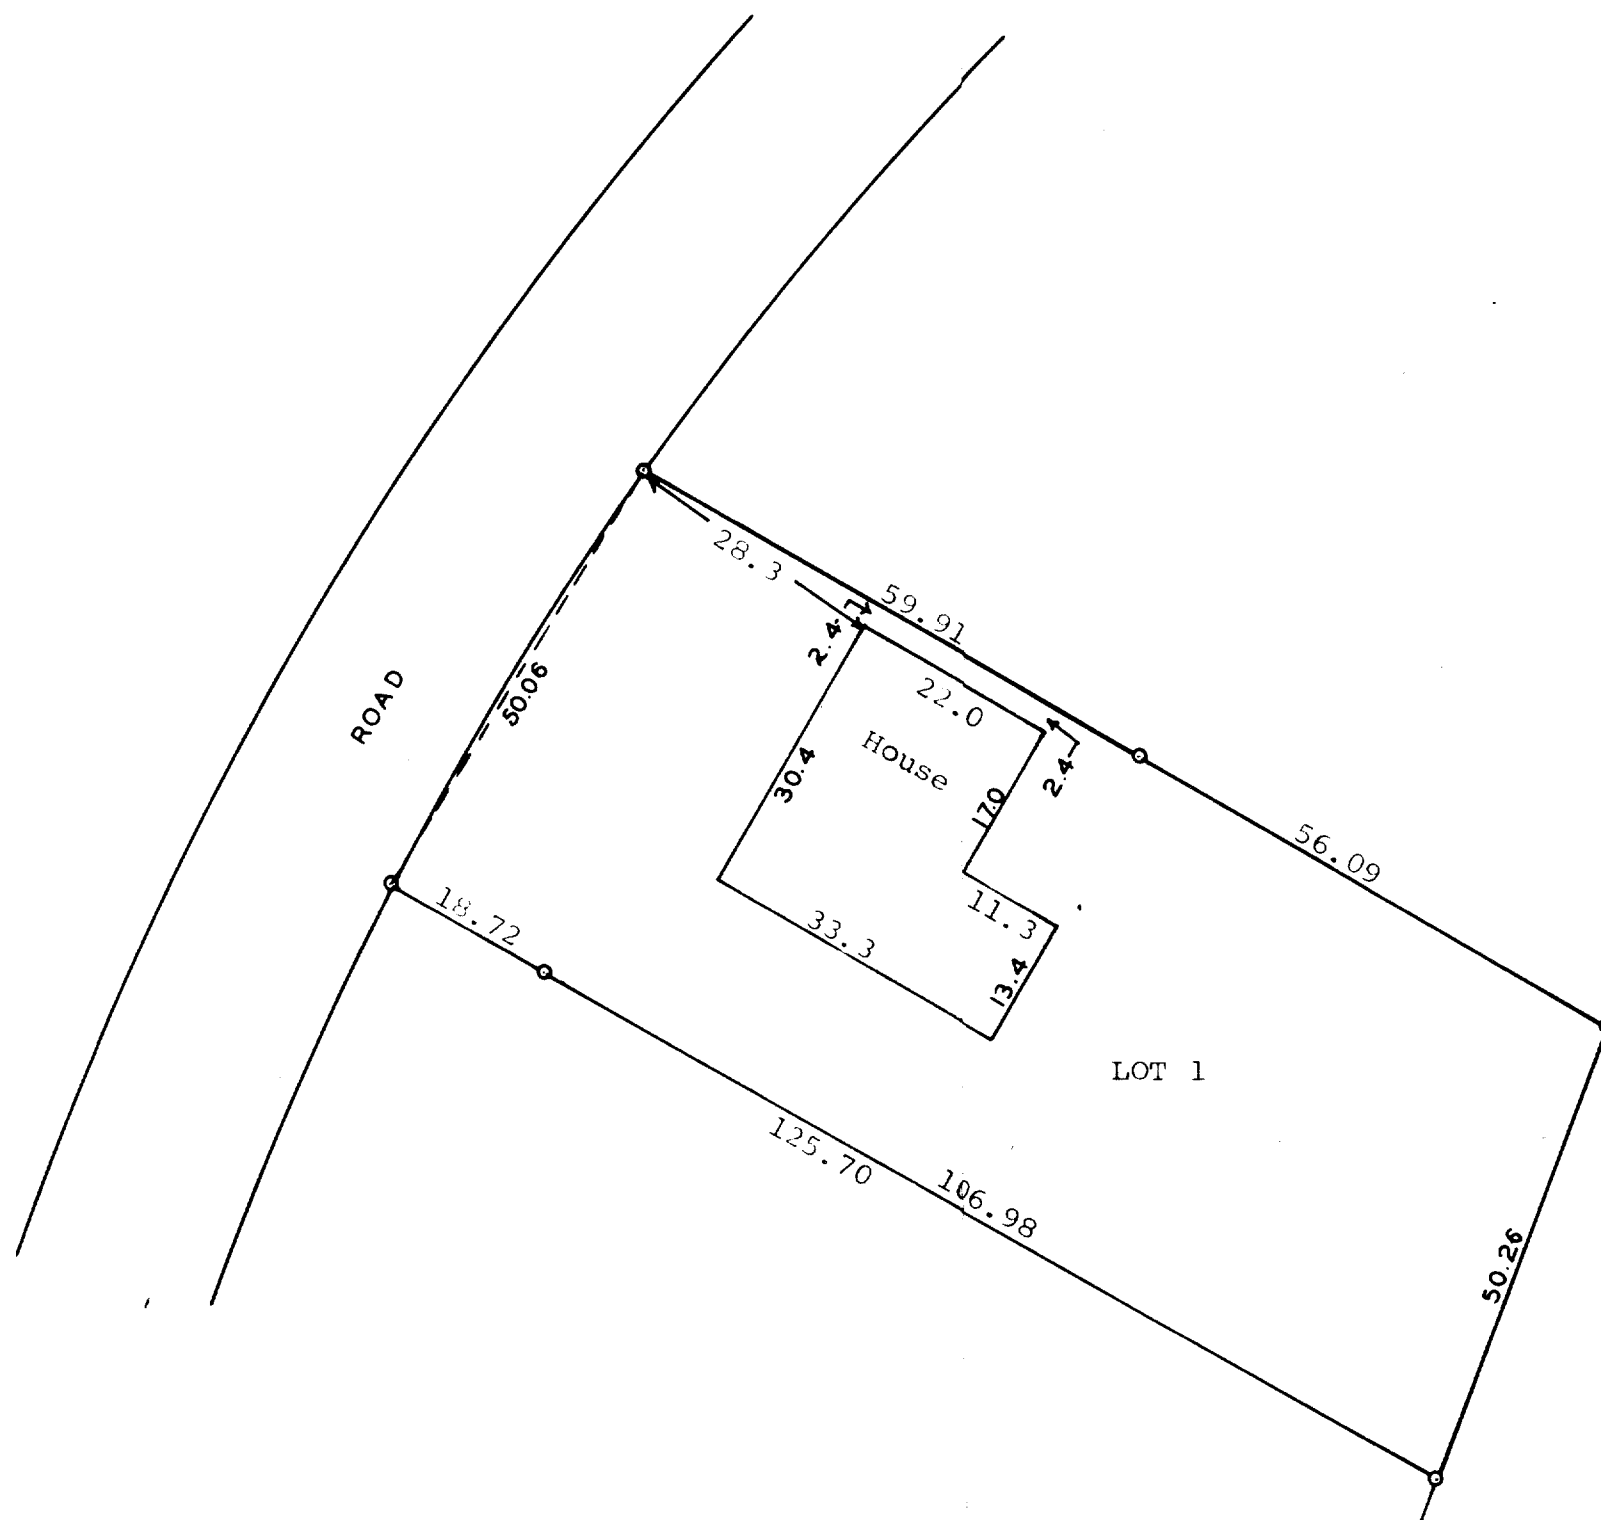


Scale - 1" = 20'
o = Iron Pipe

STATE OF WISCONSIN)
COUNTY OF WALWORTH) SS

I, George T. Dunham, Surveyor, certify that I have surveyed the property described as follows,
Lot 1, Block 4 of Indian Hills 1st Addition located in the Village of Fontana, Walworth County, Wisconsin, and that the above plat is an accurate survey and a true representation thereof and correctly shows the exterior lines and location of buildings on said property and the correct measurements thereof.
September 28, 1971

George T. Dunham
George T. Dunham, Surveyor

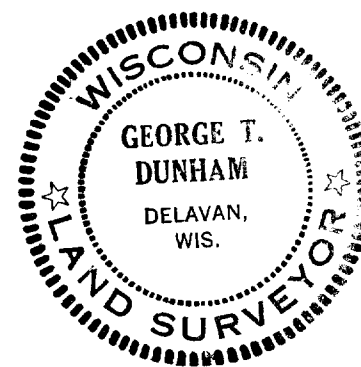

5-244