

-WORK ORDERED BY_
KEEFE REAL ESTATE
751 GENEVA PARKWAY
LAKE GENEVA, WISCONSIN 53147

FOUND CONCRETE MONUMENT
N75°26'23"W 0.88' FROM
LOT CORNER

FARRIS, HANSEN & ASSOCIATES, INC.

ENGINEERING - ARCHITECTURE - SURVEYING
7 RIDGWAY COURT - P.O. BOX 437 - ELKHORN, WISCONSIN 53121
PHONE: (262) 723-2098 FAX: (262) 723-5886

PLAT OF SURVEY OF

Lot 8, Block D, Unit 3 of Country Club Estates, Village of Fontana-on-Geneva Lake,
Walworth County, Wisconsin.


Tax Key No: SC0300060

LEGAL DESCRIPTION OF RECORD FROM TITLE COMMITMENT PROVIDED BY CLIENT

TITLE REFERS TO AN "EASEMENT GRANTED...TO WISCONSIN SOUTHERN GAS
CO...RECORDED...IN VOLUME 210 OF DEEDS ON PAGE 52". THIS DOCUMENT
GRANTS THE RIGHT TO INSTALL GAS PIPES, ETC. IN DRIVEWAYS.

LEGEND

- FOUND CONCRETE MONUMENT
- FOUND IRON PIPE STAKE
- (XXX)-RECORDED AS
- ✿-EXISTING TREE

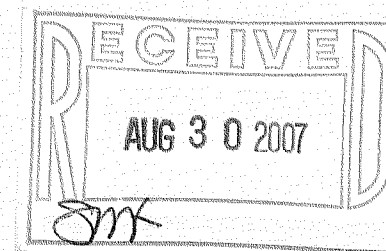



NOTE: COPIES OF THIS MAP TO WHICH THE FOLLOWING CERTIFICATE WILL APPLY SHOW
THE SURVEYOR'S ORIGINAL SEAL AND SIGNATURE IN RED INK. COPIES BY ANY OTHER
MEANS MAY HAVE ALTERATIONS WHICH DO NOT REPRESENT THE SURVEYOR'S WORK
PRODUCT.

I HEREBY CERTIFY THAT THE ABOVE DESCRIBED PROPERTY HAS BEEN SURVEYED UNDER
MY DIRECTION AND THAT THE ABOVE MAP IS A TRUE REPRESENTATION THEREOF AND
SHOWS THE SIZE AND LOCATION OF THE PROPERTY, ITS EXTERIOR BOUNDARIES, THE
LOCATION OF ALL VISIBLE STRUCTURES, AND DIMENSIONS OF ALL PRINCIPLE
BUILDINGS THEREON, BOUNDARY FENCES, APPARENT EASEMENTS, ROADWAYS, AND
VISIBLE ENCROACHMENTS, IF ANY. THIS SURVEY IS MADE FOR THE USE OF THE
PRESENT OWNERS OF THE PROPERTY, AND ALSO THOSE WHO PURCHASE, MORTGAGE, OR
GUARANTEE THE TITLE THERETO WITHIN ONE YEAR FROM THE DATE HEREOF.

DATED: 7/5/2007

Peter S. Gordon
PETER S. GORDON

PROJECT: 7360
DATE: 07/05/2007
SHEET 1 OF 1

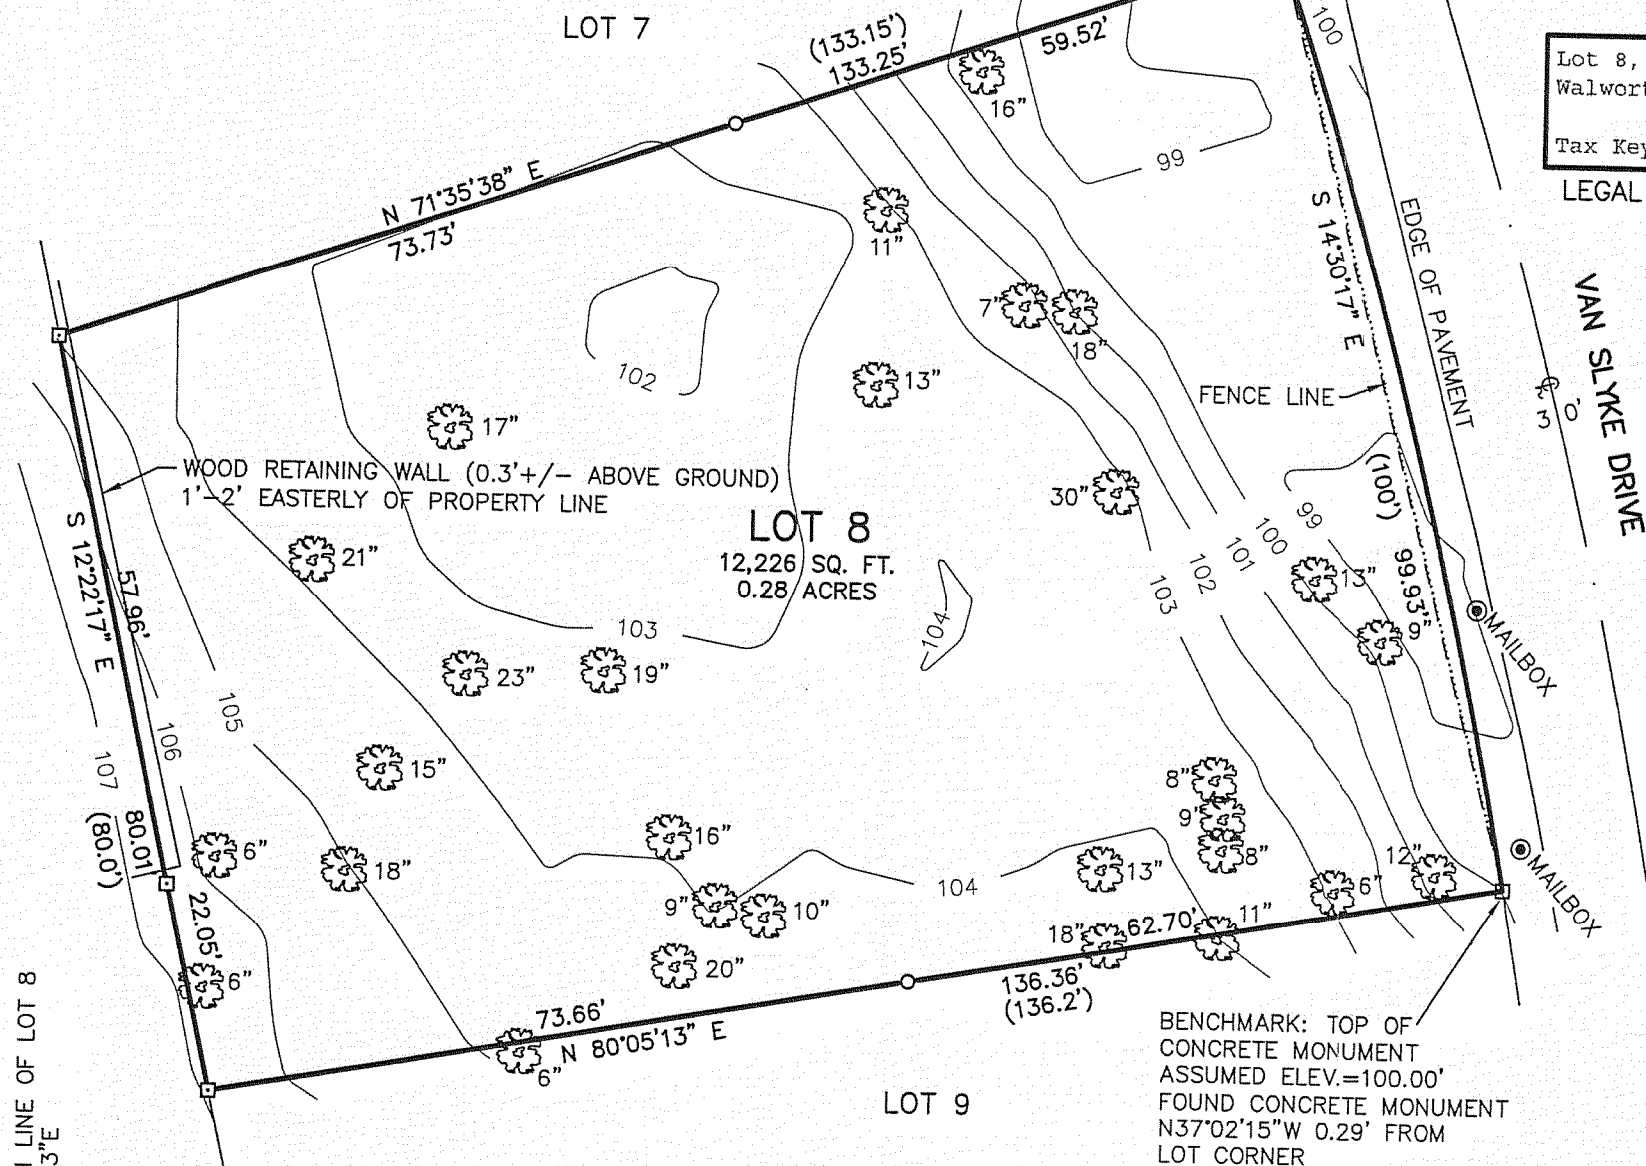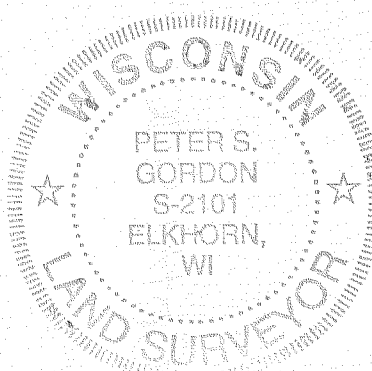

003-60

005-2492