


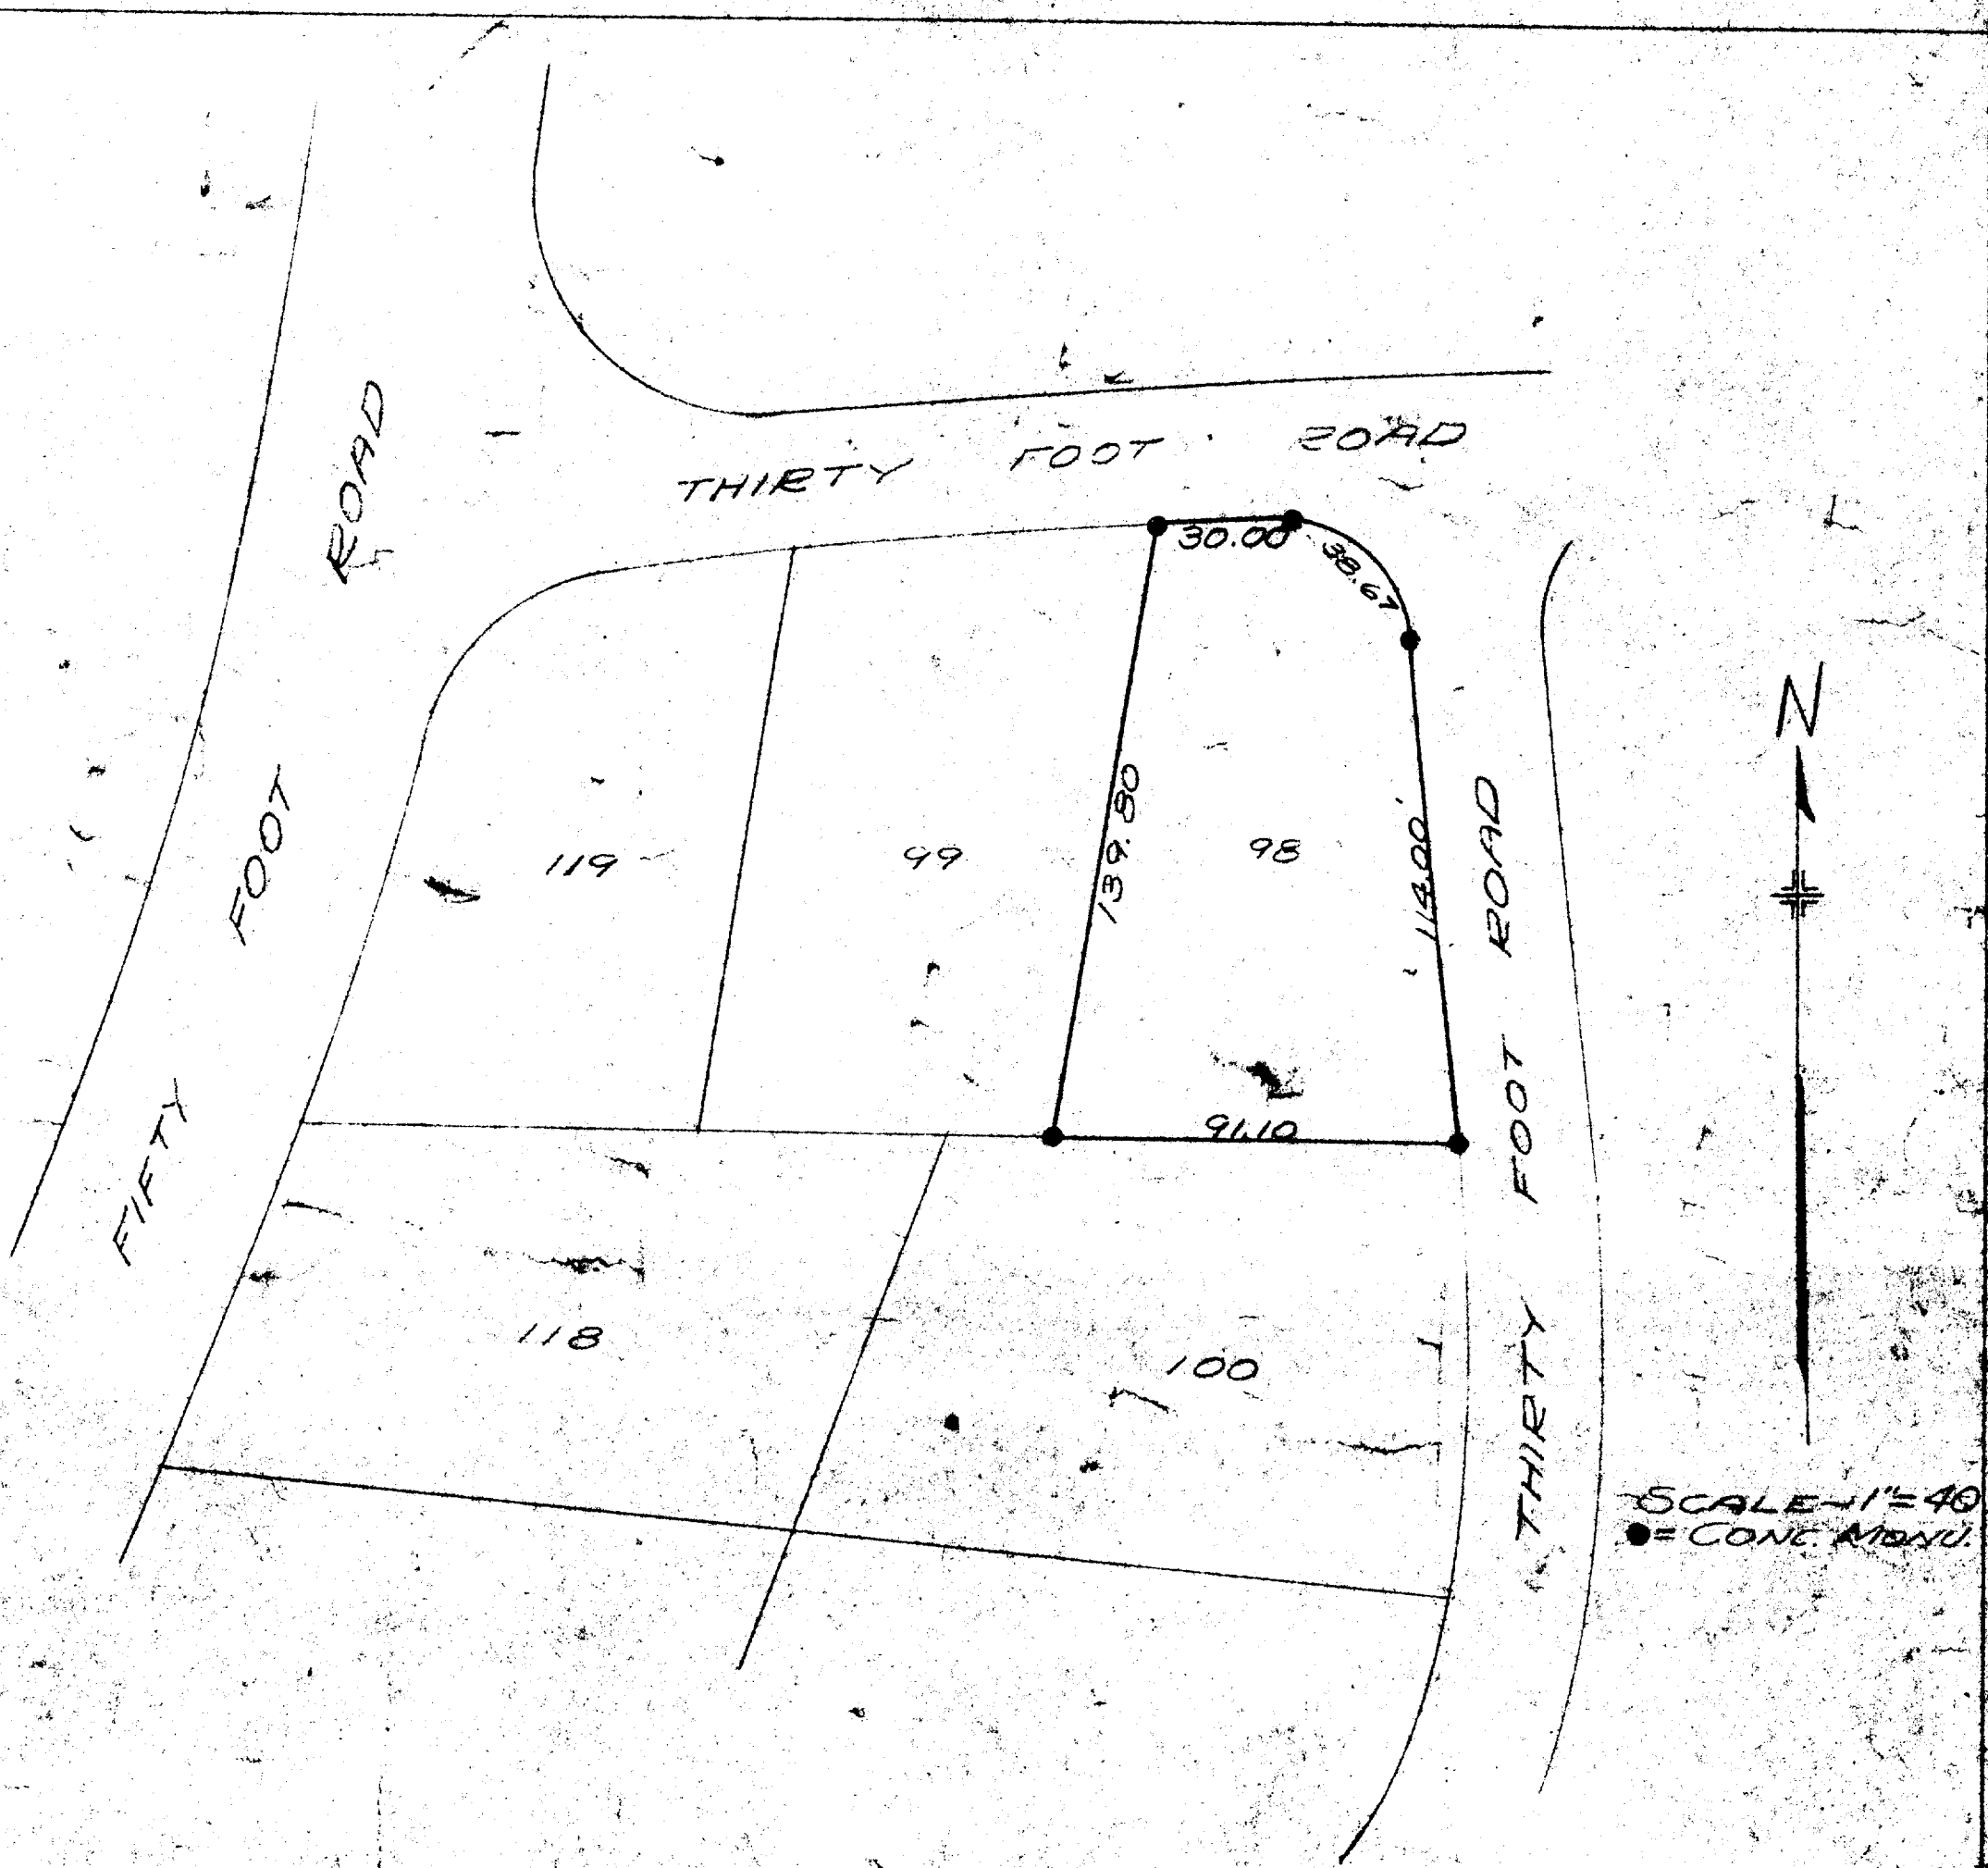

PLAT OF SURVEY OF LOT 98 OF UNIT 2 OF
COUNTRY CLUB ESTATES, A SUBDIVISION LOCATED
IN SECTIONS 14 AND 18, T1N R1E, WALWORTH
COUNTY, WISCONSIN.

DEC. 13, 1945

[Signature]
COUNTY SURVEYOR