



ABELL SURVEYING & MAPPING

1140 SEQUOIA STREET • DELAVAN, WISCONSIN 53115
262-728-6737

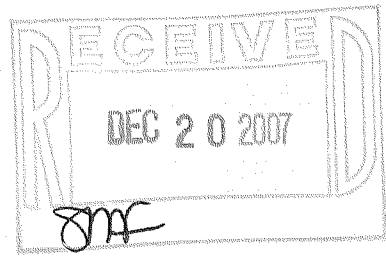

N

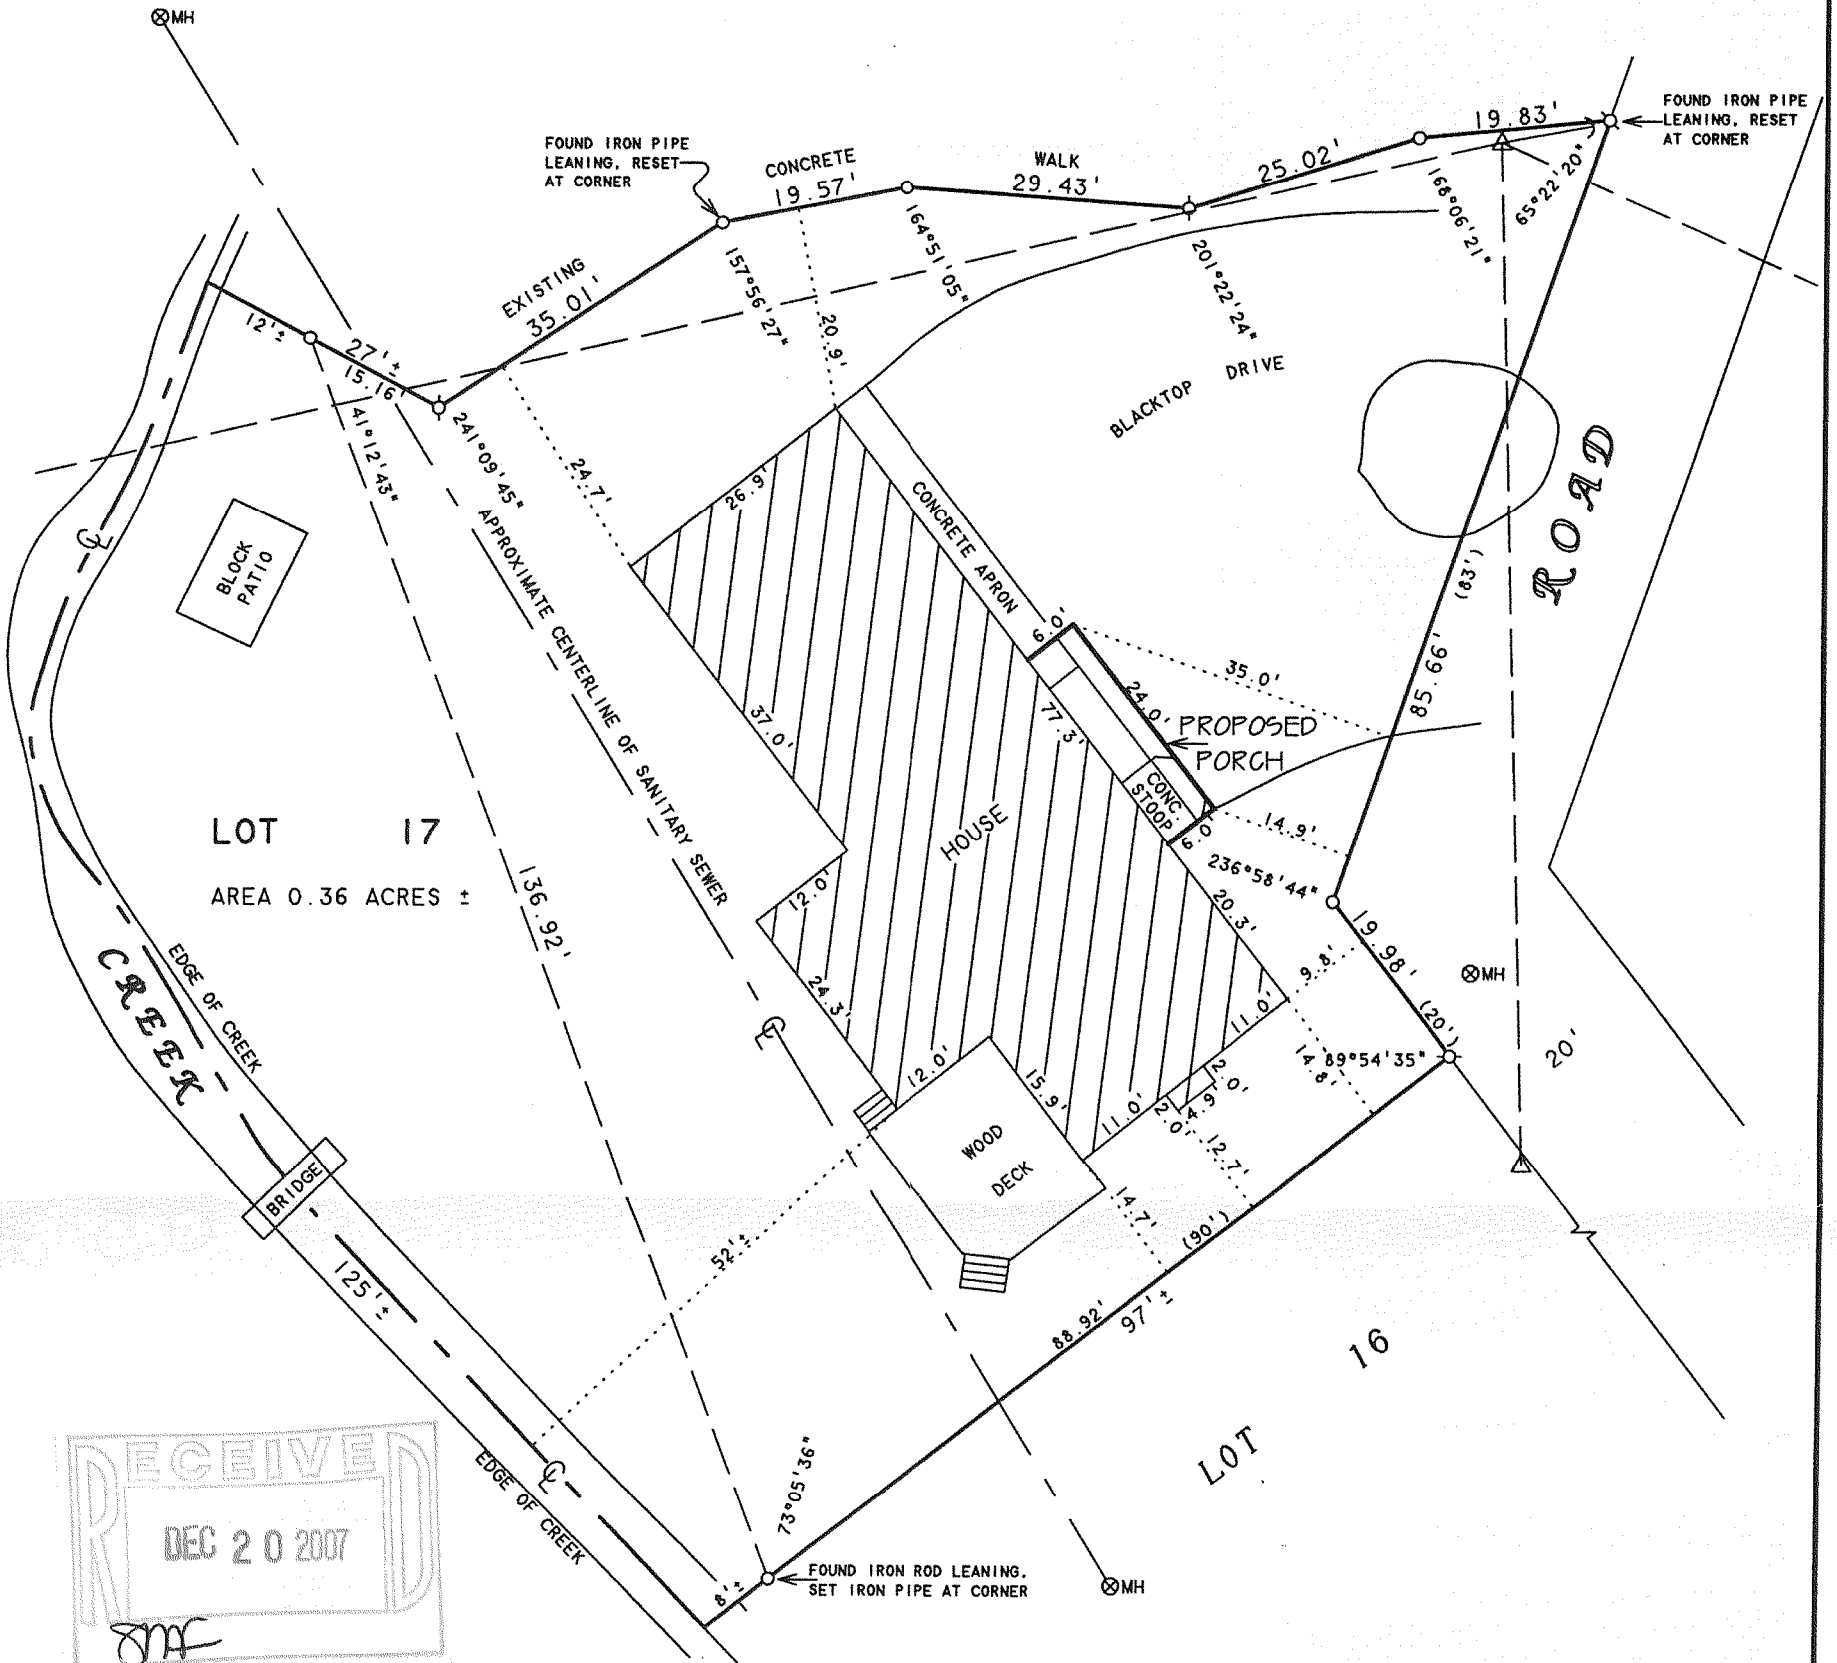

SCALE 1"=20'

LEGEND

- - IRON PIPE FOUND
- - 1" DIA. IRON PIPE SET
- △ - UTILITY POLE
- - GUY WIRE
- - OVERHEAD UTILITY LINES
- ⊗MH - MANHOLE COVER
- () - RECORDED AS

PLAT OF SURVEY OF

LOT 17 IN THE GARDENS, ACCORDING TO THE REVISED PLAT THEREOF
RECORDED ON JUNE 9, 1927 IN VOLUME 8 OF PLATS AT PAGE 121,
AS DOCUMENT NO. 263978 AND BEING PART OF SECTION 11, IN
TOWN 1 NORTH, RANGE 16 EAST, IN THE VILLAGE OF FONTANA-ON-
GENEVA LAKE, WALWORTH COUNTY, WISCONSIN.

I HEREBY CERTIFY THAT I HAVE SURVEYED THE ABOVE DESCRIBED PROPERTY AND THAT THE
ABOVE MAP IS A TRUE REPRESENTATION THEREOF AND SHOWS THE SIZE AND LOCATION OF
THE PROPERTY, ITS EXTERIOR BOUNDARIES, THE LOCATION OF ALL VISIBLE STRUCTURES
AND DIMENSIONS OF ALL PRINCIPAL BUILDINGS THEREON, BOUNDARY FENCES, APPARENT
EASEMENTS, ROADWAYS AND VISIBLE ENCROACHMENTS, IF ANY, TO THE BEST OF MY
KNOWLEDGE AND BELIEF.

THIS SURVEY IS MADE FOR THE USE OF THE PRESENT OWNERS OF THE PROPERTY, AND ALSO
THOSE WHO PURCHASE, MORTGAGE, OR GUARANTEE THE TITLE THERETO WITHIN ONE (1) YEAR
FROM DATE HEREON.

David F. Abell

DAVID F. ABELL
WISCONSIN REGISTERED LAND SURVEYOR, S-1596

ORDERED BY: SUSAN GRABINSKI
91 N. POTAWATOMI ROAD
UNIT R-3
WILLIAMS BAY, WI 53191

October 25, 2007

DATE JOB NUMBER - 87065A
NOTE: THIS IS NOT A CERTIFIED COPY UNLESS SEALED.

557 17B

005-2524