


FARRIS, HANSEN & ASSOCIATES, INC.

ENGINEERING - ARCHITECTURE - SURVEYING
7 RIDGWAY COURT - P.O. BOX 437 - ELKHORN, WISCONSIN 53121
PHONE: (262) 723-2098 FAX: (262) 723-5886

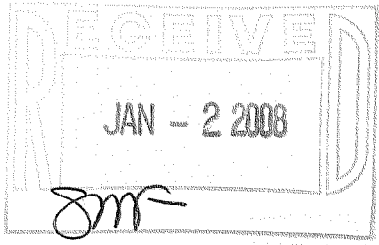

UNIT 1051

UNIT 1053

13,544 SQ. FT.
0.31 ACRES

FOUNDATION
LOCATED
12/10/07

UNIT 1055

UTILITIES
ALONG LINE
BRIARWOOD DRIVE

SET SPIKE IN
TREE ROOT

PLAT OF SURVEY OF

UNIT 1053 OF ABBEY SPRINGS CONDOMINIUM
NO. 8, LOCATED IN THE SOUTHEAST 1/4 AND
THE SOUTHWEST 1/4 OF SECTION 13, T 1 N,
R 16 E, VILLAGE OF FONTANA-ON-GENEVA
LAKE, WALWORTH COUNTY, WISCONSIN.


ASSIGNED THE WESTERLY BOUNDARY OF
UNIT 1053 N 58°30'30" E

LEGEND
●-FOUND IRON REBAR STAKE
○-FOUND IRON PIPE STAKE
(XXX)-RECORDED AS

-WORK ORDERED BY-

CHICAGO DESIGN & CONSTRUCTION
1640 WEST HUBBARD STREET, SUITE 100
CHICAGO, ILLINOIS 60622

30 15 0 30 60 90 120
MAP SCALE IN FEET - ORIGINAL 1"=30'

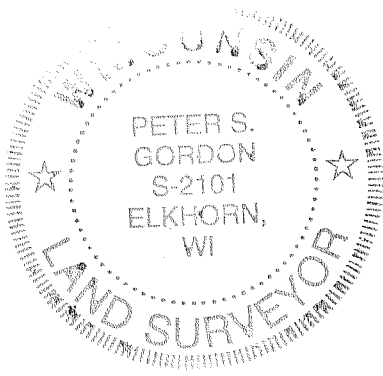

NOTE: COPIES OF THIS MAP TO WHICH THE FOLLOWING CERTIFICATE
WILL APPLY SHOW THE SURVEYOR'S ORIGINAL SEAL AND SIGNATURE IN
RED INK. COPIES BY ANY OTHER MEANS MAY HAVE ALTERATIONS
WHICH DO NOT REPRESENT THE SURVEYOR'S WORK PRODUCT. I
HEREBY CERTIFY THAT THE ABOVE DESCRIBED PROPERTY HAS BEEN
SURVEYED UNDER MY DIRECTION AND THAT THE ABOVE MAP IS A
TRUE REPRESENTATION THEREOF AND SHOWS THE SIZE AND LOCATION
OF THE PROPERTY AND ITS EXTERIOR BOUNDARIES. THIS SURVEY IS
MADE FOR THE USE OF THE PRESENT OWNERS OF THE PROPERTY,
AND ALSO THOSE WHO PURCHASE, MORTGAGE, OR GUARANTEE THE
TITLE THERETO WITHIN ONE YEAR FROM THE DATE HEREOF.

REVISED 12/11/2007 TO
SHOW AS-BUILT FOUNDATION

DATED: 9/21/2007

Peter S. Gordon
PETER S. GORDON

PROJECT: 7432
DATE: 09/21/2007
SHEET 1 OF 1

DEC 11 2007

SCDB 8 01052

005-2525