



PLAT OF SURVEY

LOT 4 OF CERTIFIED SURVEY MAP NO. 3421

RECORDED IN VOL. 19 ON PG. 293 AS DOC. NO. 507115
LOCATED IN PART OF THE NE 1/4 OF THE SW 1/4 OF SECTION 15,
TOWN 1 NORTH, RANGE 16 EAST, VILLAGE OF FONTANA-ON-GENEVA LAKE,
WALWORTH COUNTY, WISCONSIN

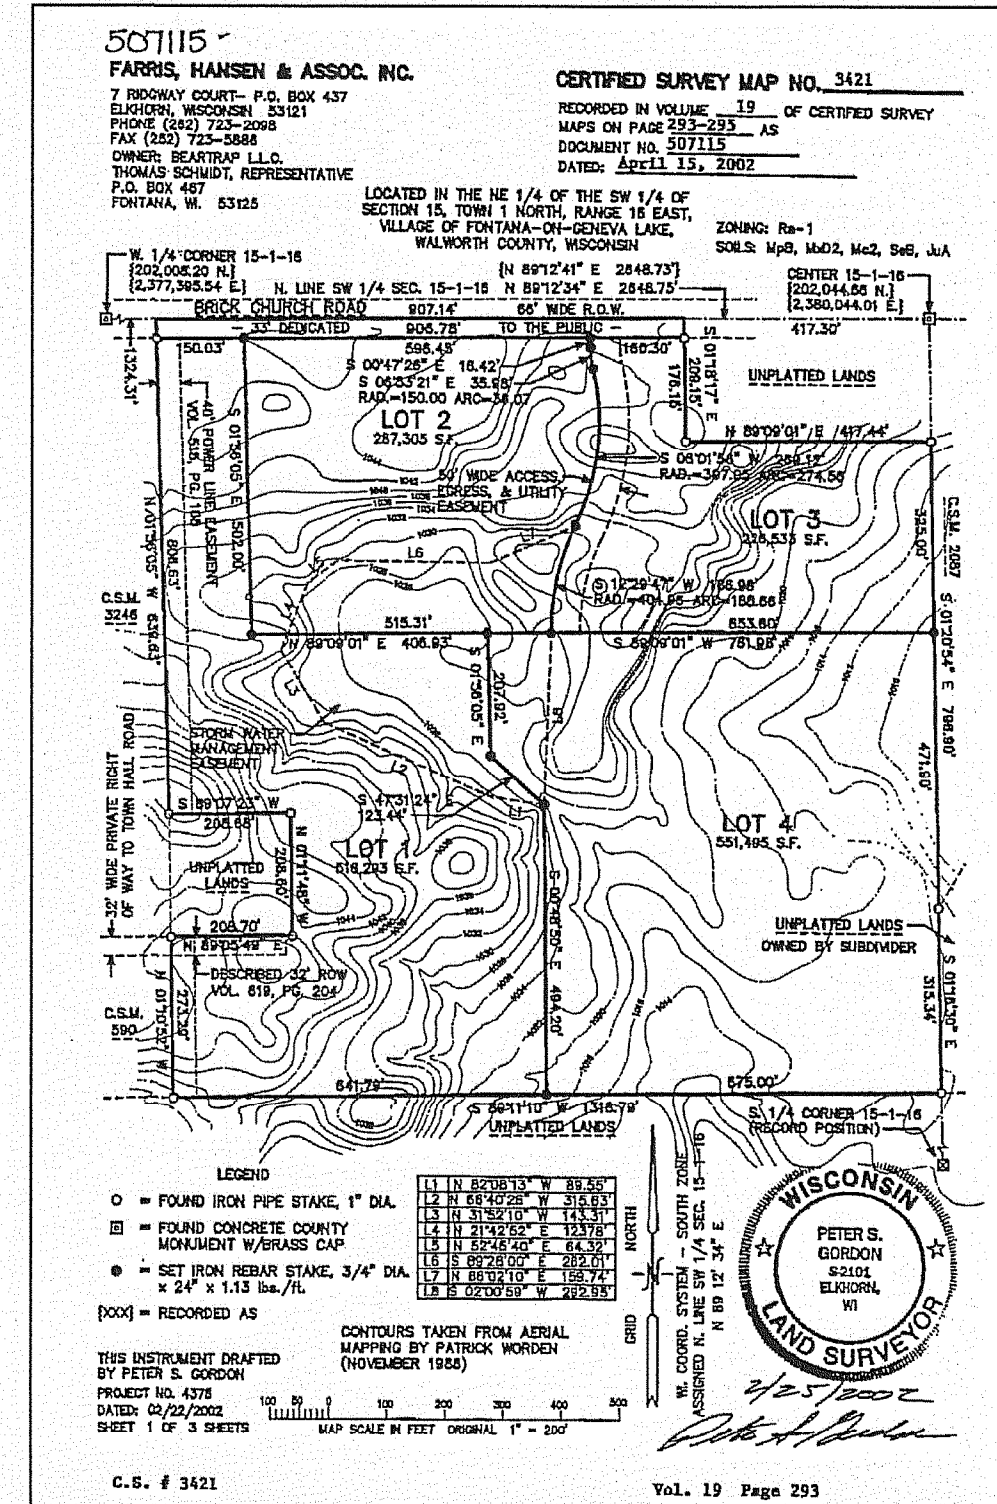

GRID NORTH
W. COORD. SYSTEM - SOUTH ZONE
ASSIGNED N. LINE SW 1/4 SEC. 15-1-16
N 89°12'34" E

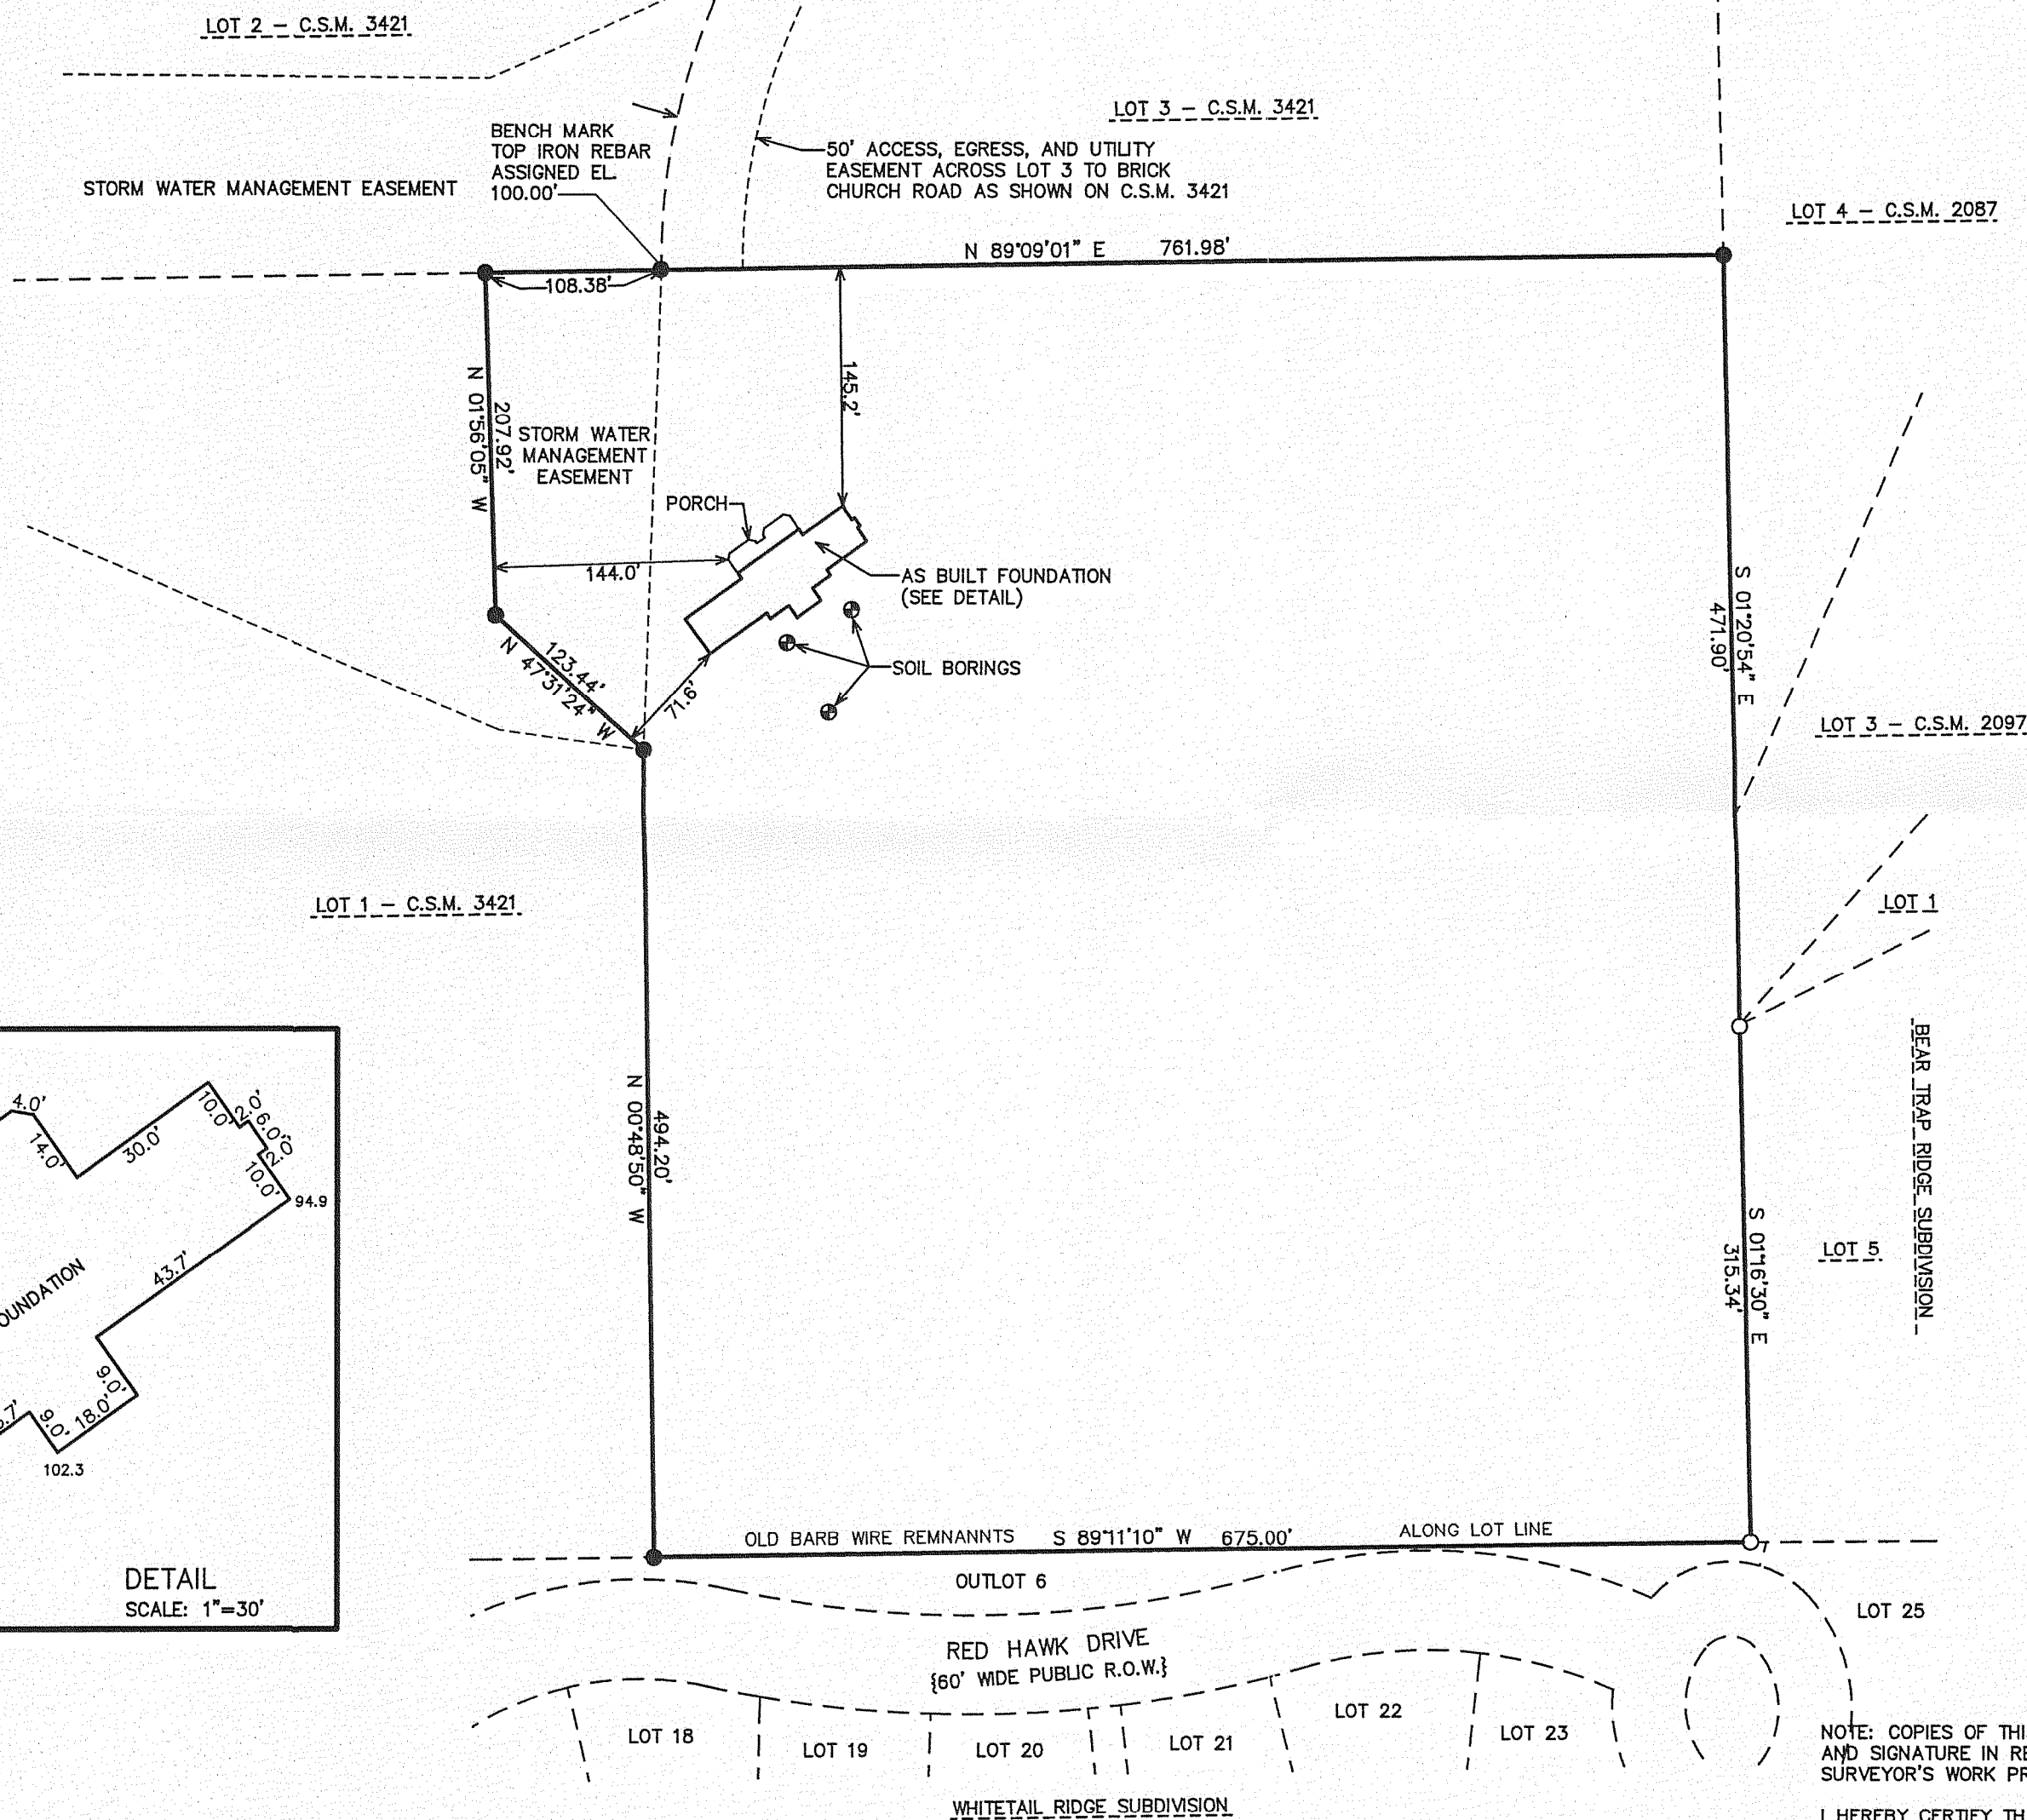

NOTE: THE EASEMENT IN VOL. 619 OF DEEDS, PAGE 204
RE-RECORDED IN VOL. 620 OF DEEDS ON PAGE 553 IS A
ROW WHICH LIES WEST OF LOT 1 OF CSM 3421 AND
DOES NOT AFFECT LOT 4.

NOTE: COPIES OF THIS MAP TO WHICH THE FOLLOWING CERTIFICATE WILL APPLY SHOW SURVEYOR'S ORIGINAL SEAL
AND SIGNATURE IN RED INK. COPIES BY ANY OTHER MEANS MAY HAVE ALTERATIONS WHICH DO NOT REPRESENT THE
SURVEYOR'S WORK PRODUCT.

I HEREBY CERTIFY THAT THE ABOVE DESCRIBED PROPERTY HAS BEEN SURVEYED UNDER MY DIRECTION AND THAT THE
ABOVE MAP IS A TRUE REPRESENTATION THEREOF AND SHOWS THE SIZE AND LOCATION OF THE PROPERTY, ITS
EXTERIOR BOUNDARIES, THE LOCATION OF ALL VISIBLE STRUCTURES, AND DIMENSIONS OF ALL PRINCIPLE
BUILDINGS THEREON, BOUNDARY FENCES, APPARENT EASEMENTS, ROADWAYS, AND VISIBLE ENCROACHMENTS, IF ANY.
THIS SURVEY IS MADE FOR THE USE OF THE PRESENT OWNERS OF THE PROPERTY, AND ALSO THOSE WHO PURCHASE,
MORTGAGE, OR GUARANTEE THE TITLE THERETO WITHIN ONE YEAR FROM THE DATE HEREOF.

DATED: JUNE 12, 2007

PETER S. GORDON R.L.S. 2101

REVISED 11-07-2007

TO SHOW AS BUILT FOUNDATION SIZE & LOCATION
AND UPDATE THE SURVEY TO TITLE SPEC'S.

FARRIS, HANSEN & ASSOCIATES, INC.
ENGINEERING - ARCHITECTURE - SURVEYING
7 RIDGEWAY COURT P.O. BOX 437
ELKHORN, WISCONSIN 53121
OFFICE: (262) 723-2098 FAX: (262) 723-5886

REVISIONS

PROJECT NO.
4378.04
DATE:
06/12/2007
SHEET NO.
1 OF 1