


Topographic Map

of




Part of Tax Parcel STFV 00088,
located in the Fractional Northeast 1/4 of Section 13, Town 1
North, Range 16 East, Village of Fontana-on-Geneva Lake,
Walworth County, Wisconsin.

Prepared for: **Edward S. Lyon**
986 South Shore Drive
Fontana, Wisconsin. 53125

Tax Parcel
STFV 00088A

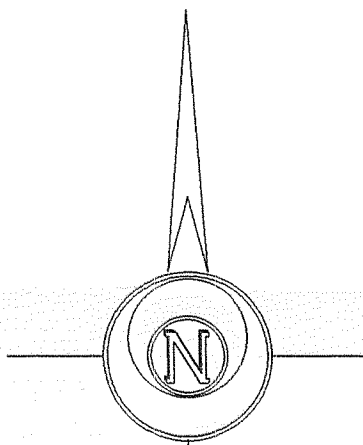

Bearings referenced to previous
surveys of record.

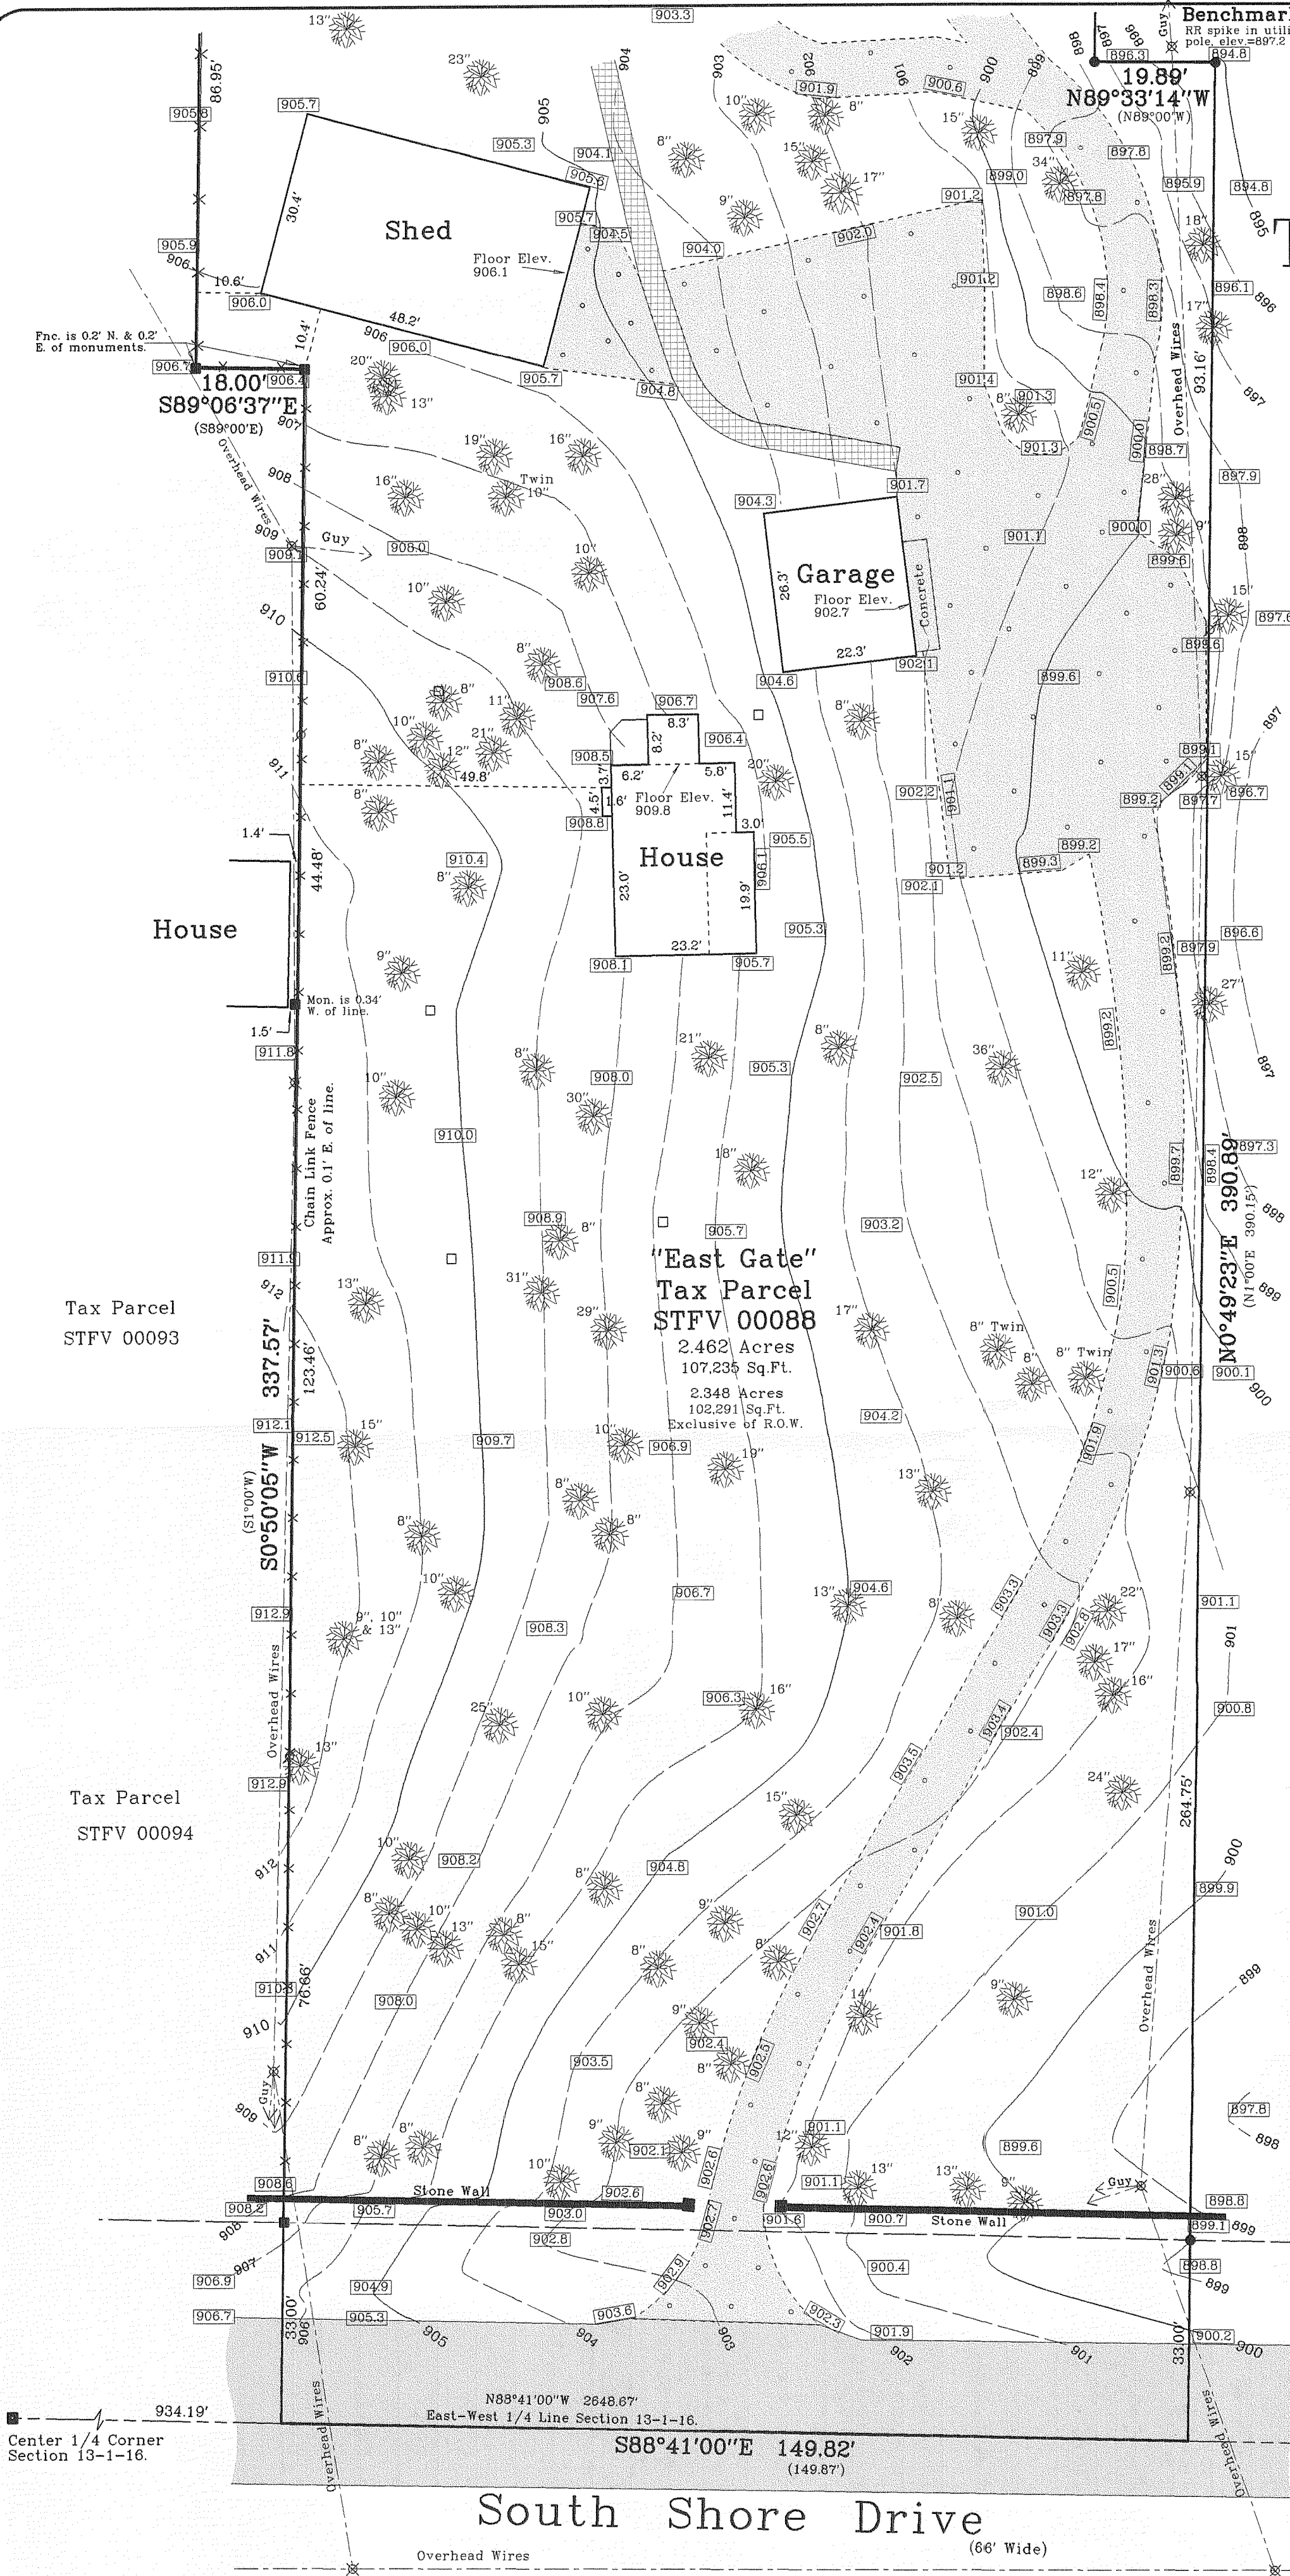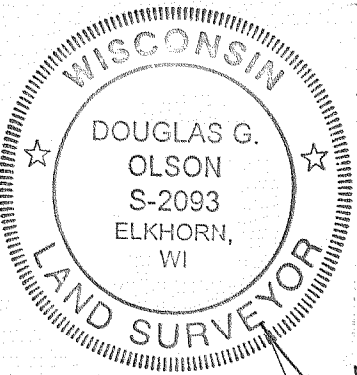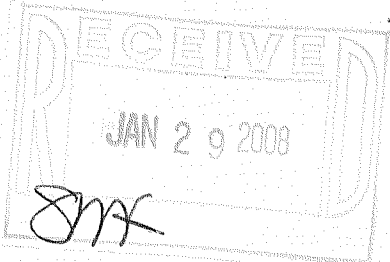

See complete survey of property by Jensen & Olson Land Surveying,
LLC dated July 13, 2000, Job Reference Number 2000.092.

2006.144 Sheet 1 of 1 Sheets Job Reference Number 2006.144 11nr16e-2006144-2006144south.S90	Legend Found Concrete Monument Found Iron Pipe Found Iron Rod Recorded Information Utility Pole Gravel Surface Block Walk Asphalt Surface Spot Elevation Deciduous Tree Concrete	Jensen & Olson Land Surveying, LLC 45 South Wisconsin Street P.O. Box 322 Elkhorn, Wisconsin. 53121 Telephone (262) 723-3434 Facsimile (262) 723-8044	Scale in Feet 1" = 20' 0' 10' 20' 40'	Survey Date: December 15, 2006. Revisions:
--	--	--	--	--

STFV-88

005-2547