


GEORGE T. DUNHAM
SURVEYING & SUBDIVIDING
DELAVER, WISCONSIN

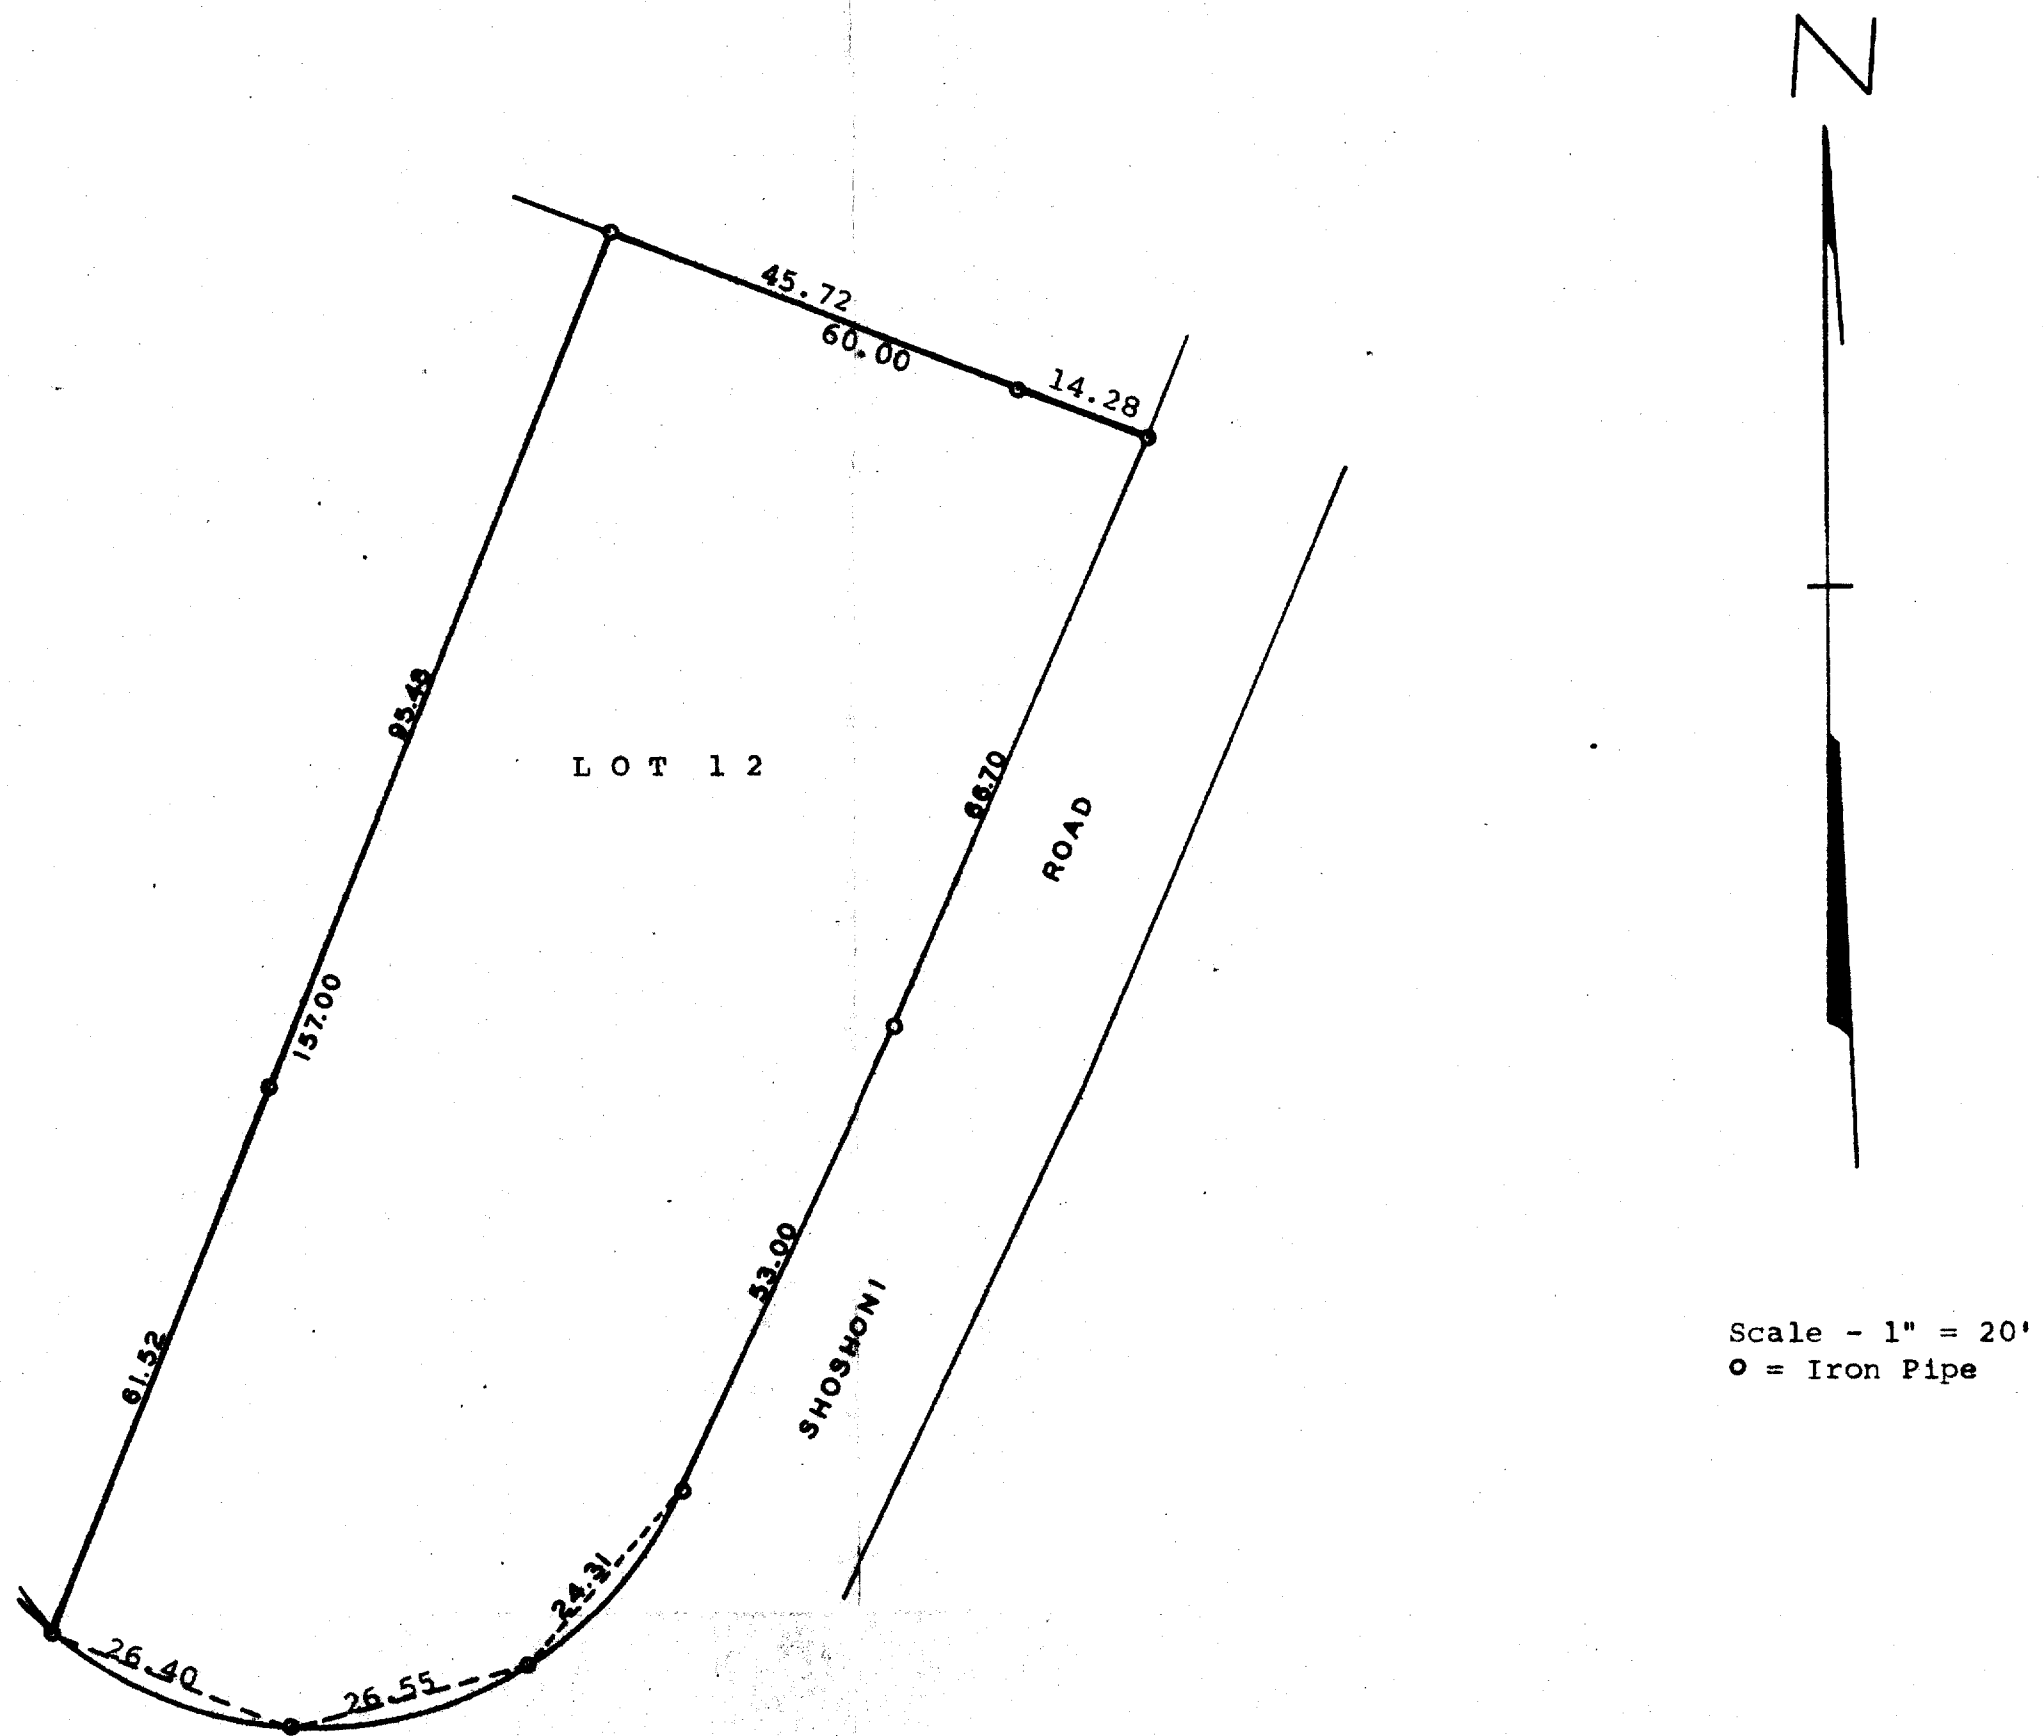

Plat of survey of Lot 12, Block 4 of Indian Hills 1st Addition
Village of Fontana, Walworth County, Wisconsin.
April 19, 1972

George T. Dunham
George T. Dunham, Surveyor

