


# FARRIS, HANSEN & ASSOC. INC.

7 RIDGWAY COURT- P.O. BOX 437  
ELKHORN, WISCONSIN 53121  
PHONE (262) 723-2098  
FAX (262) 723-5886

ORDERED BY: KEEFE REAL ESTATE  
PO BOX 460  
LAKE GENEVA, WI. 53147

## PLAT OF SURVEY LOT 11, BLOCK 7 INDIAN HILLS 1ST ADDITION SUBDIVISION LOCATED IN THE SE 1/4 SEC. 14 TOWN 1 NORTH, RANGE 16 EAST VILLAGE OF FONTANA-ON-GENEVA LAKE WALWORTH COUNTY, WISCONSIN

TAX KEY NO. SIHF 00076  
803 ODSILA WAY

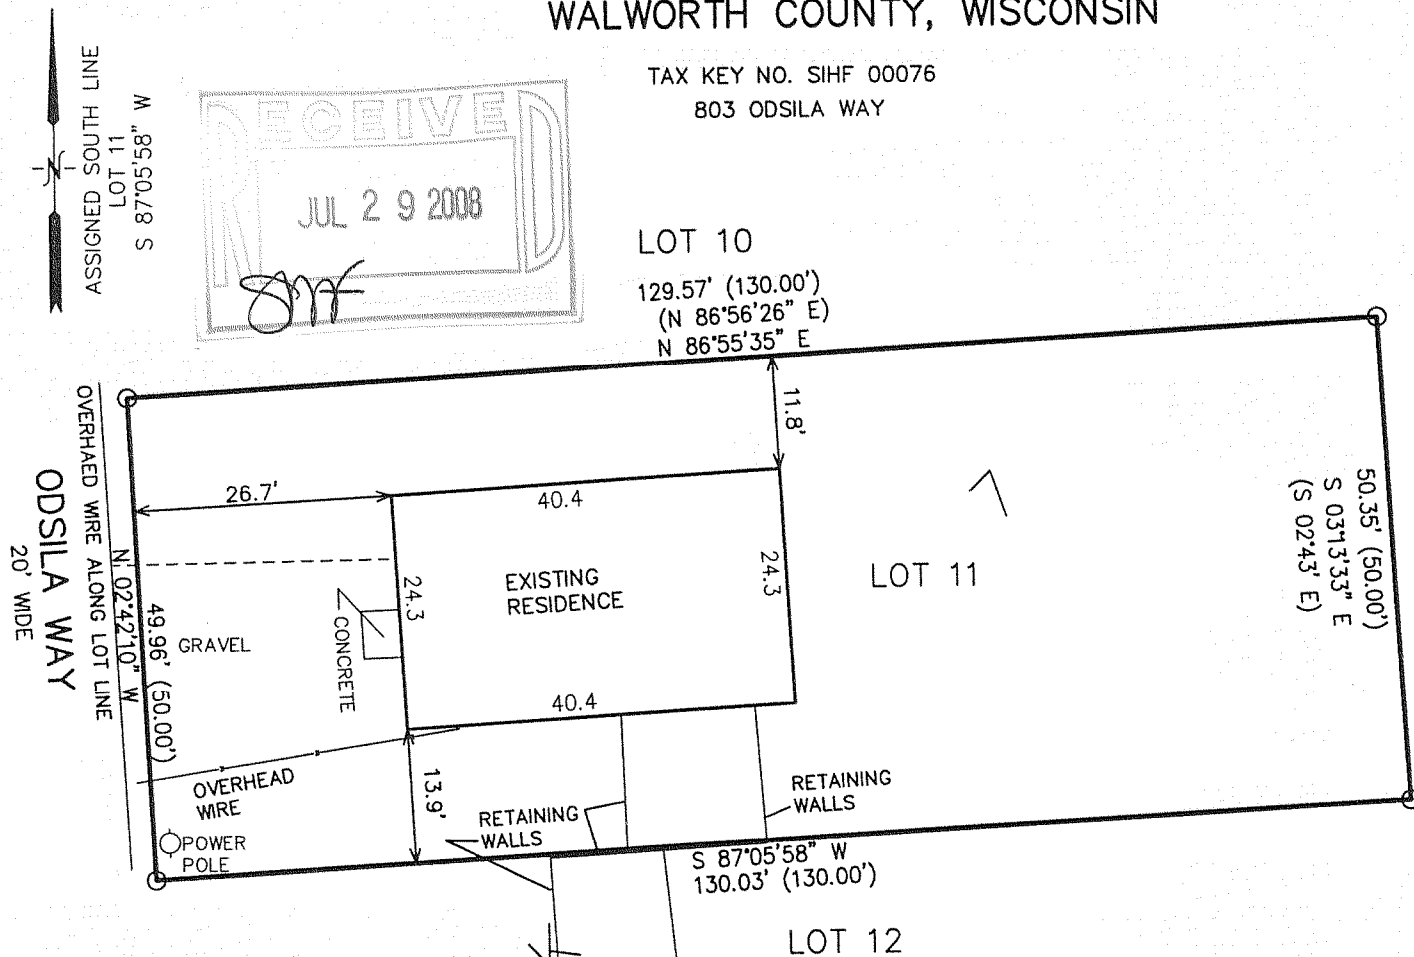

NOTE: THE ORIGINAL SUBDIVISION  
PLAT SHOWS A DOTTED LINE WHICH  
APPEARS TO HAVE BEEN A ROW SETBACK  
SCALING 22' TO 25' FROM THE ROW FOR  
ODSILA WAY.

### LEGEND

○ = FOUND IRON PIPE STAKE  
(xxx) = RECORDED AS


6510 S.F. (0.15 ACRES)

NOTE: COPIES OF THIS MAP TO WHICH THE FOLLOWING CERTIFICATE WILL APPLY SHOW SURVEYOR'S  
ORIGINAL SEAL AND SIGNATURE IN RED INK. COPIES BY ANY OTHER MEANS MAY HAVE ALTERATIONS  
WHICH DO NOT REPRESENT THE SURVEYOR'S WORK PRODUCT.


I HEREBY CERTIFY THAT THE ABOVE DESCRIBED PROPERTY HAS BEEN SURVEYED UNDER MY DIRECTION  
AND THAT THE ABOVE MAP IS A TRUE REPRESENTATION THEREOF AND SHOWS THE SIZE AND LOCATION OF  
THE PROPERTY, ITS EXTERIOR BOUNDARIES, THE LOCATION OF ALL VISIBLE STRUCTURES, AND  
DIMENSIONS OF ALL PRINCIPLE BUILDINGS THEREON, BOUNDARY FENCES, APPARENT EASEMENTS,  
ROADWAYS, AND VISIBLE ENCROACHMENTS, IF ANY. THIS SURVEY IS MADE FOR THE USE OF THE  
PRESENT OWNERS OF THE PROPERTY, AND ALSO THOSE WHO PURCHASE, MORTGAGE, OR GUARANTEE THE  
TITLE THERETO WITHIN ONE YEAR FROM THE DATE HEREOF.

DATED: JULY 15, 2008

*Peter S. Gordon*  
PETER S. GORDON R.L.S. 2101

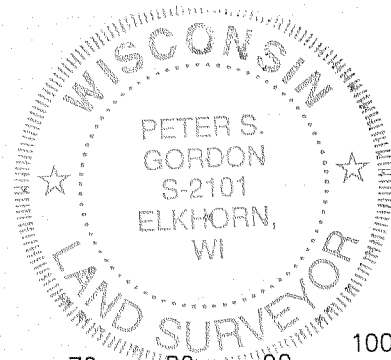

PROJECT NO. 7674  
DATED: 07-02-2008  
SHEET 1 OF 1 SHEETS

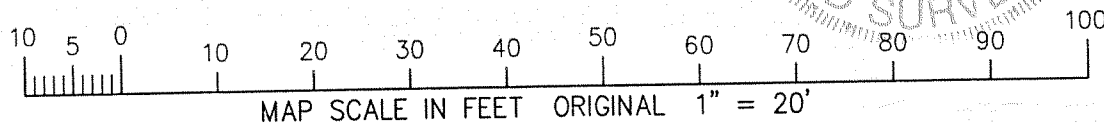

JUL 15 2008

SIHF-710

005-2589