


HAROLD H. KOLB

REGISTERED PROFESSIONAL LAND SURVEYOR
LAKE GENEVA, WISCONSIN

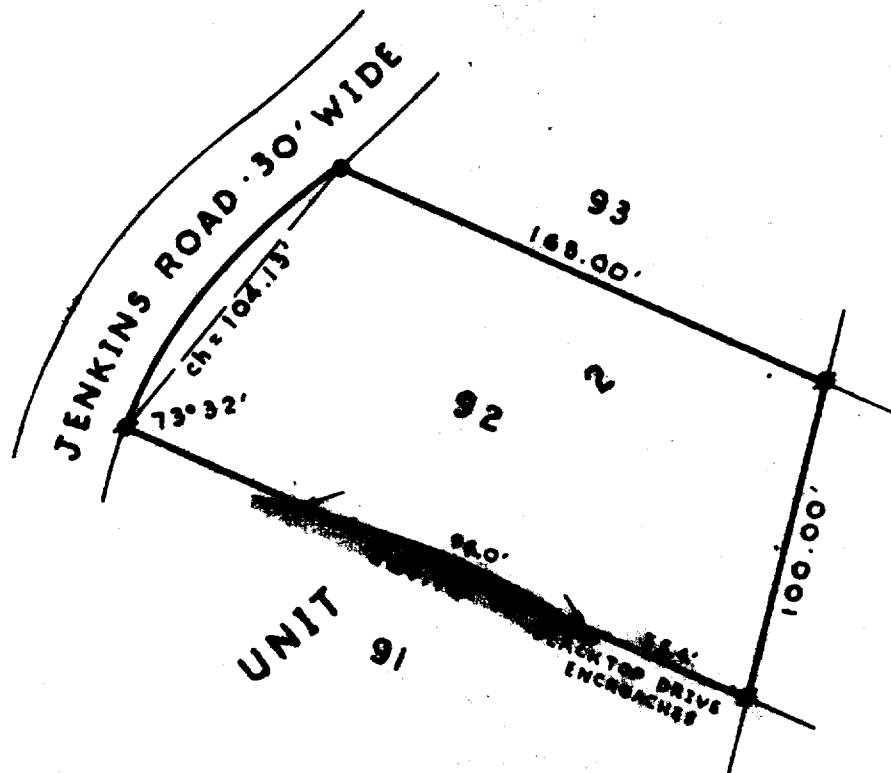

PLAT OF SURVEY OF

Lot 92, Unit 2 of Country Club Estates,
Subdivision, Village of Fontana on Geneva
Lake, Walworth County, Wisconsin.

N



SCALE: 1"=60'

LEGEND

- ♦ - IRON PIPE FOUND
- O - IRON PIPE PLACED
- - CONCRETE MONUMENT FOUND
- - CONCRETE MON. PLACED



I, HAROLD H. KOLB, DO HEREBY CERTIFY THAT I HAVE
SURVEYED THE PROPERTY HEREON DESCRIBED ACCORDING
TO THE OFFICIAL RECORDS, AND THAT THE PLAT HEREON
IS A CORRECT REPRESENTATION OF THE LOT LINES.

Harold H. Kolb

HAROLD H. KOLB
WISCONSIN REGISTERED LAND SURVEYOR, S-187

DATE August 29, 1972

SC02-97

5-259