


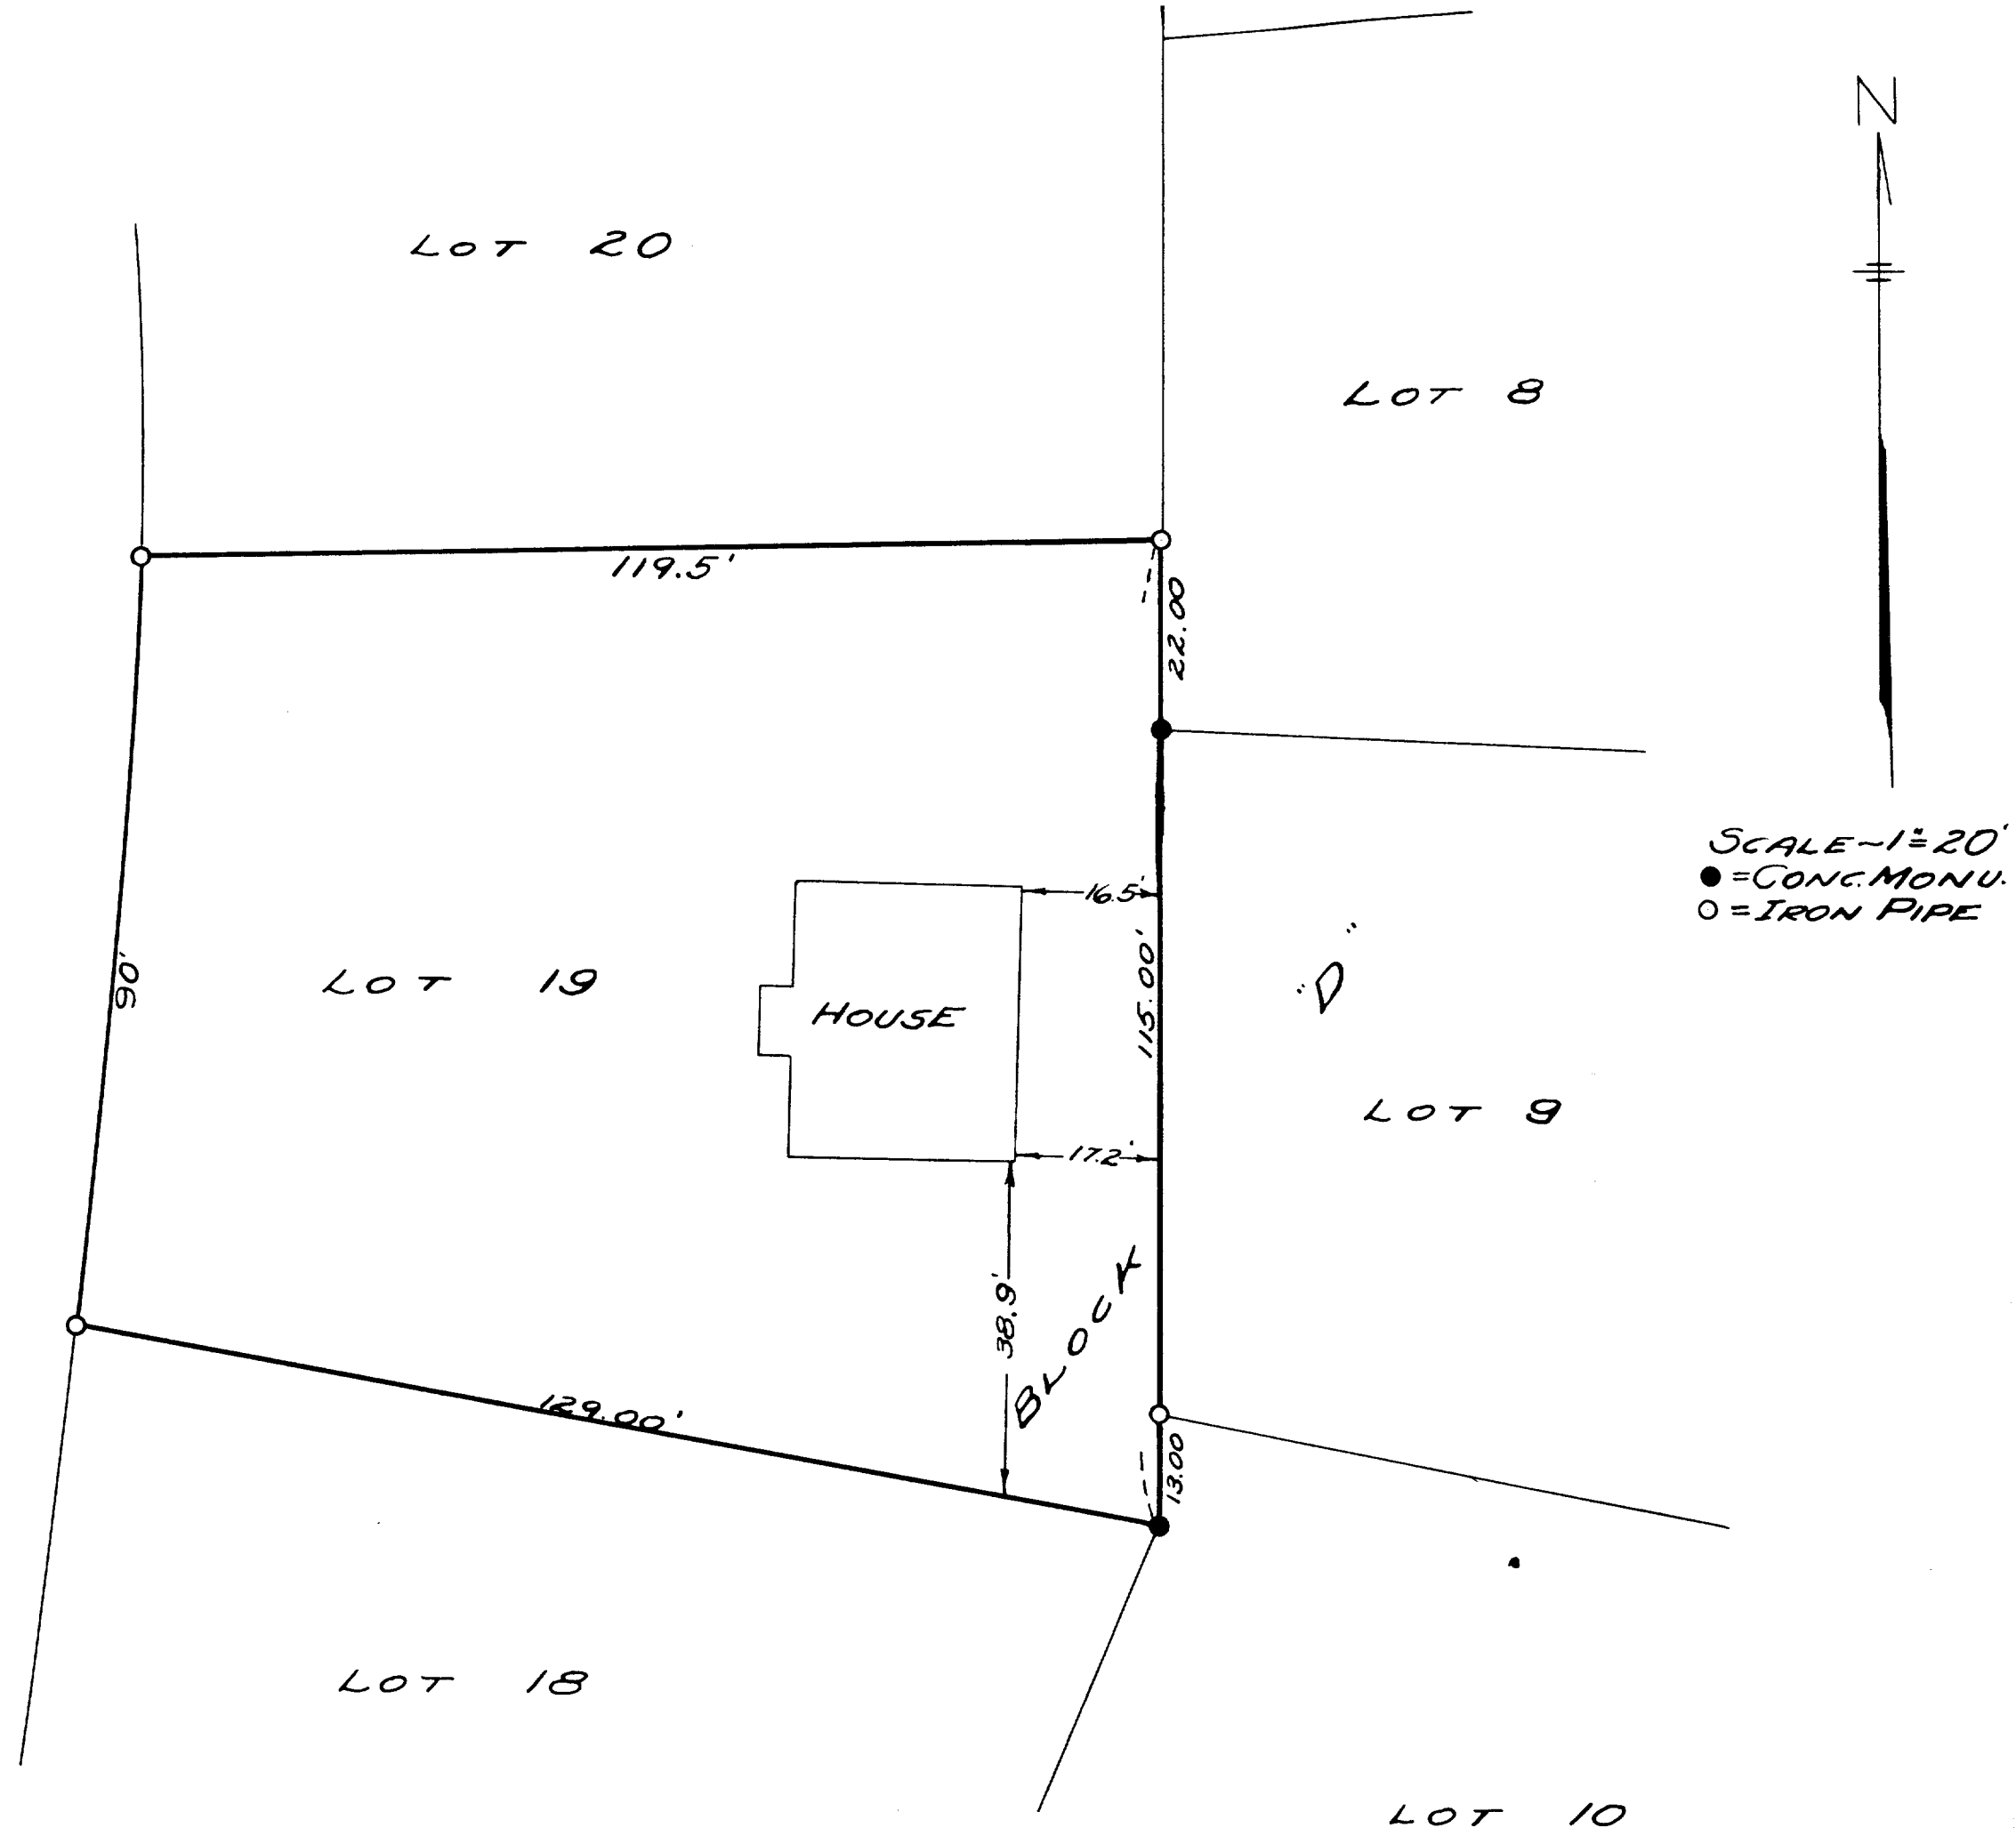

I HEREBY CERTIFY THAT THE PLAT SHOWN HEREON IS A CORRECT REPRESENTATION OF A SURVEY OF LOT 19 BLOCK D OF UNIT NO. 3 OF COUNTRY CLUB ESTATES, A SUBDIVISION LOCATED IN THE VILLAGE OF FONTANA-ON-GENEVA LAKE, WALWORTH COUNTY, WISCONSIN, AND THAT I FOUND THE ORIGINAL WOOD STAKES OF THE SUBDIVISION AT EACH OF THE CORNERS OF LOT 19 AT WHICH I HAVE PLACED STAKES AS SHOWN.

NOV. 26, 1945

SC03-71

Floyd L. Jensen
COUNTY SURVEYOR 5-25