

FARRIS, HANSEN & ASSOCIATES, INC.

ENGINEERING — ARCHITECTURE — SURVEYING
7 RIDGWAY COURT — P.O. BOX 437 — ELKHORN, WISCONSIN 53121
PHONE: (262) 723-2098 FAX: (262) 723-5886

SITE, GRADING, DRAINAGE, & EROSION CONTROL PLAN PLAT OF SURVEY


UNIT 158 OF ABBEY SPRINGS CONDOMINIUM NO. 5
LOCATED IN PART OF THE SW 1/4 OF SECTION 18,
TOWN 1 NORTH, RANGE 17 EAST, VILLAGE OF FONTANA-ON-GENEVA LAKE,
WALWORTH COUNTY, WISCONSIN

— WORK ORDERED BY —
MIKE CHORNEYKO
MICHAEL RAYMOND CUSTOM HOMES
200 WEST MAIN STREET, SUITE E
ST. CHARLES, IL 60174

LEGEND

- = FOUND IRON PIPE STAKE
- ▲ = FOUND "PK" NAIL IN PAVEMENT
- (XXX) = RECORDED AS

ASSIGNED SOUTH LINE OF UNIT 158
ABBAY SPRING CONDOMINIUM NO. 5
N 88°44'00" W

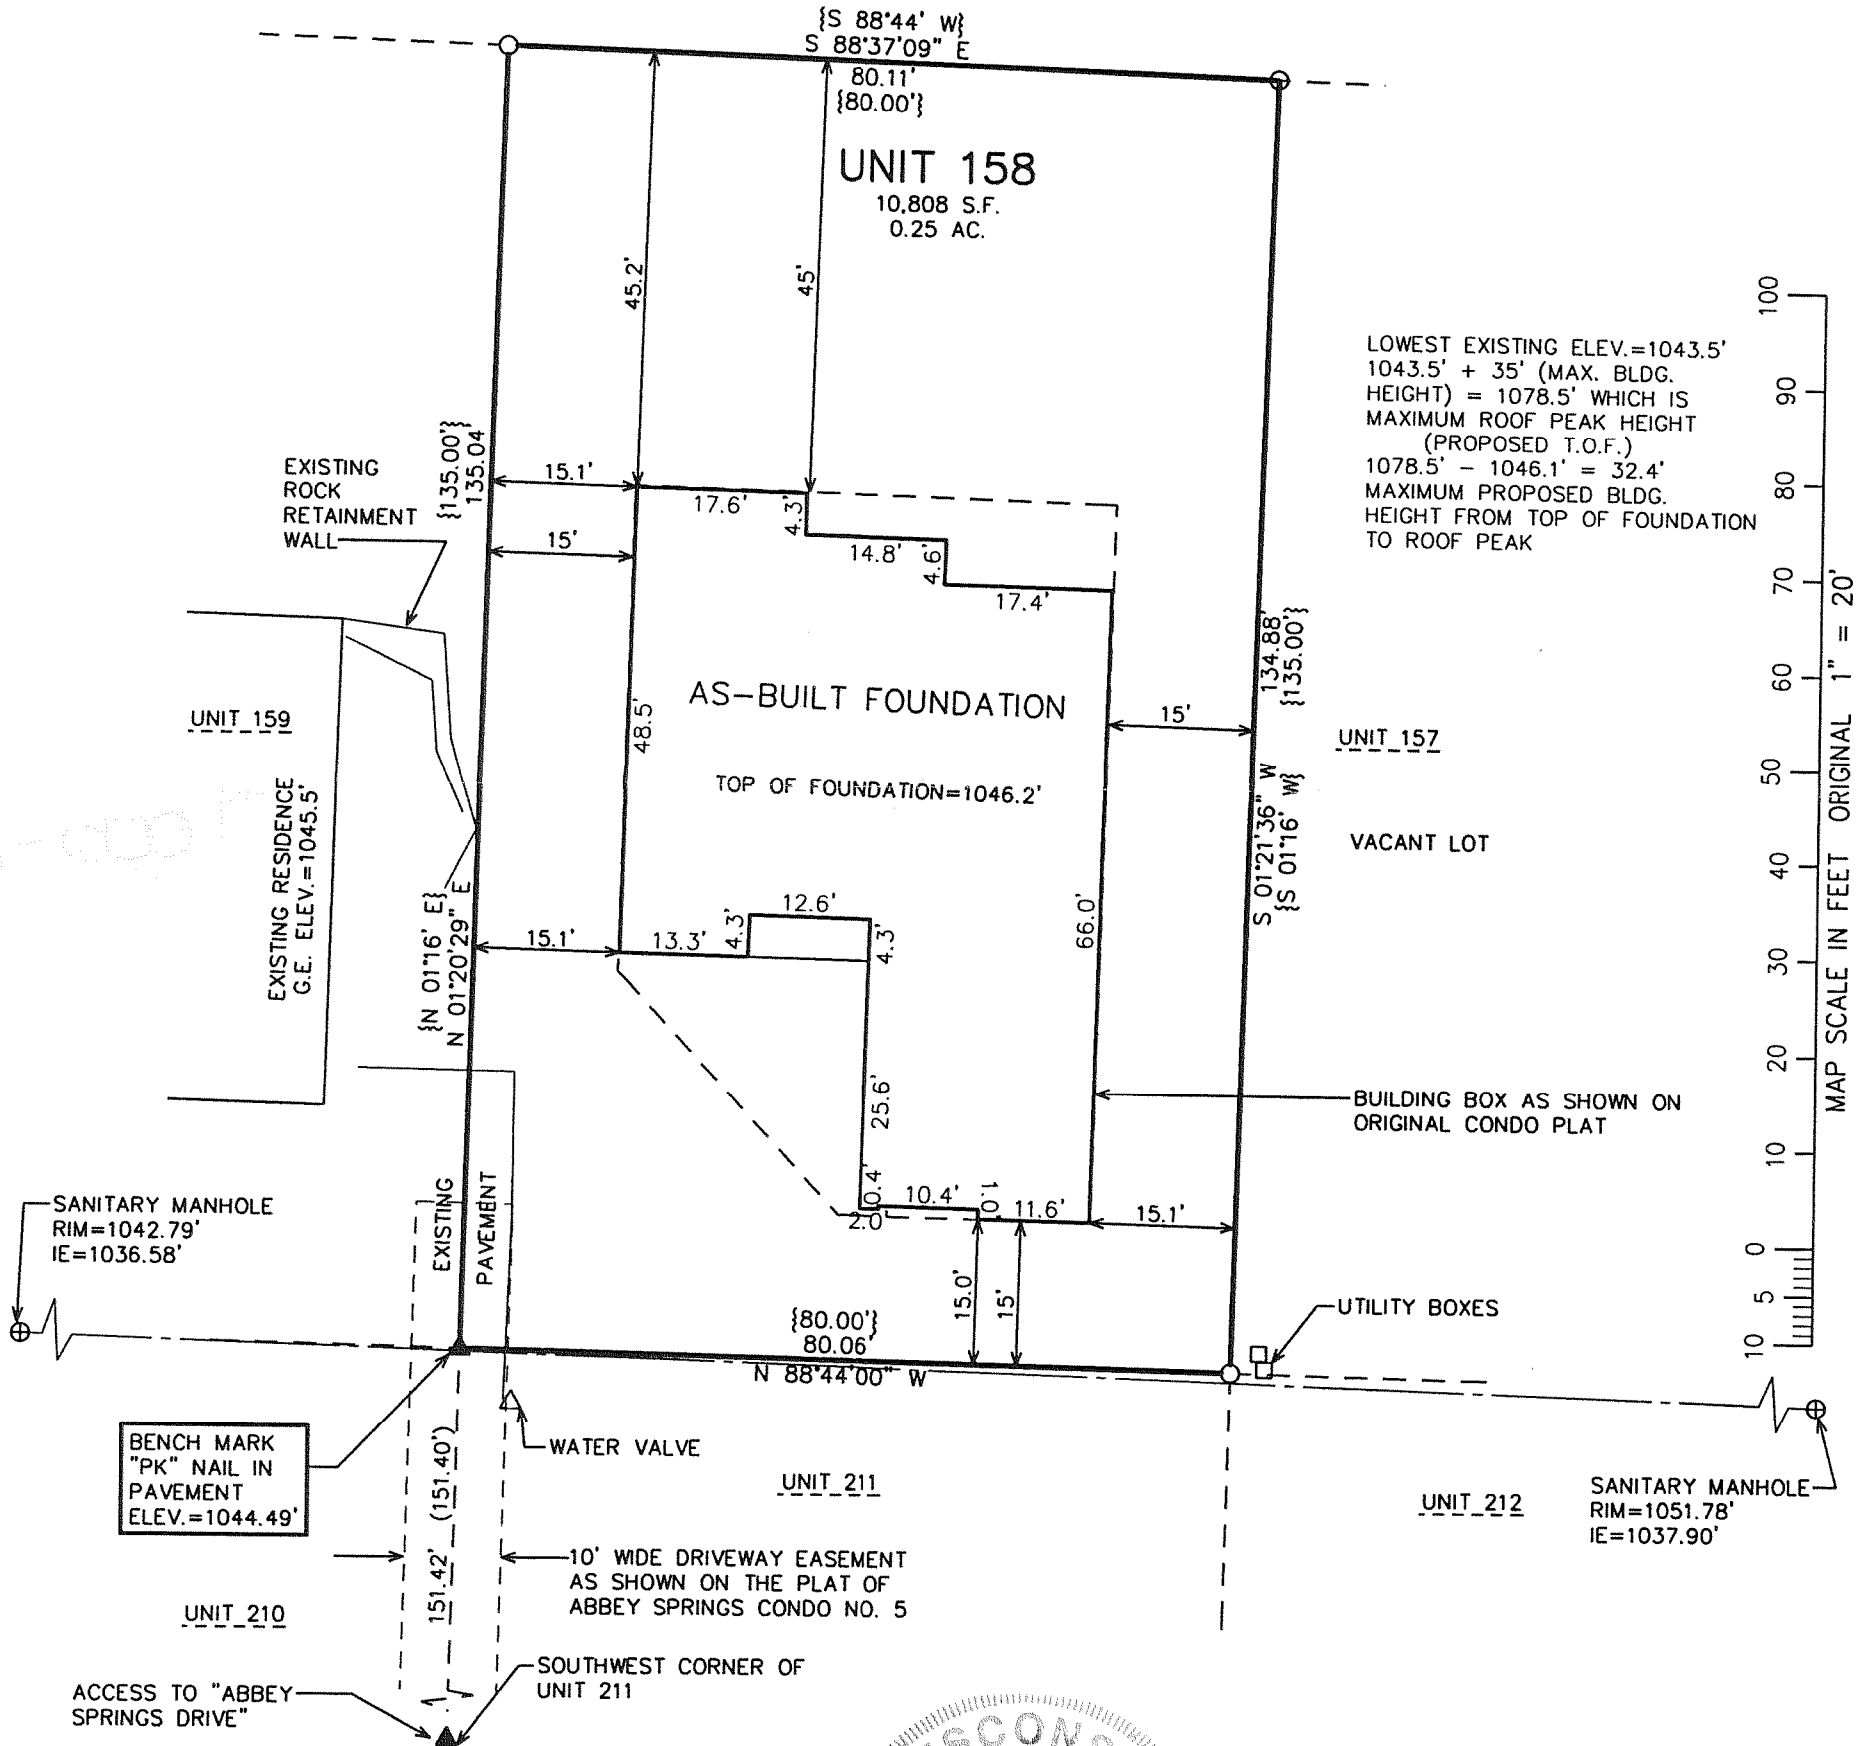

NOTE: COPIES OF THIS MAP TO WHICH THE FOLLOWING CERTIFICATE
WILL APPLY SHOW THE SURVEYOR'S ORIGINAL SEAL AND SIGNATURE
IN RED INK. COPIES BY ANY OTHER MEANS MAY HAVE ALTERATIONS
WHICH DO NOT REPRESENT THE SURVEYOR'S WORK PRODUCT.


I HEREBY CERTIFY THAT THE ABOVE DESCRIBED PROPERTY HAS BEEN
SURVEYED UNDER MY DIRECTION AND THAT THE ABOVE MAP IS A TRUE
REPRESENTATION THEREOF AND SHOWS THE SIZE AND LOCATION OF
THE PROPERTY AND ITS EXTERIOR BOUNDARIES. THIS SURVEY IS
MADE FOR THE USE OF THE PRESENT OWNERS OF THE PROPERTY, AND
ALSO THOSE WHO PURCHASE, MORTGAGE, OR GUARANTEE THE TITLE
THERE TO WITHIN ONE YEAR FROM THE DATE HEREOF.

DATED: NOVEMBER 3, 2006

REVISED: 7/17/2007-KB
SITE, GRADING, DRAINAGE,
AND EROSION CONTROL PLAN

REVISED: 8/8/2008-KB
TO SHOW SIZE AND LOCATION
OF AS-BUILT FOUNDATION

PETER S. GORDON R.L.S. 2101

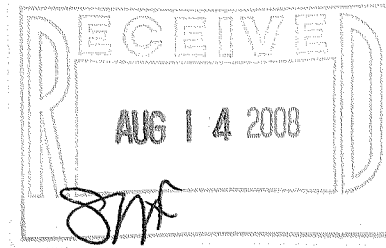

PROJECT: 7175
DATE: 11/03/2006
SHEET 1 OF 1

SCDB 5-158

005-2604

AUG 0 8 2008

8/8/2008 X:\Projects\7175\Draw\ASBUILT_20080808