





PREPARED FOR
LINDA TONGE
KEEFE REALESTATE
751 GENEVA PARKWAY
LAKE GENEVA WI. 53147

PLAT OF SURVEY

-OF-

KROTT SURVEYING INC.
N3705 WILLOW BEND LANE
LAKE GENEVA WI. 53147
PHONE # (262)248-3697
FAX # (262)249-0639

LOT 3 AND LOT 4 IN BLOCK 4 IN INDIAN HILLS FIRST ADDITION TO THE VILLAGE OF FONTANA-ON-GENEVA LAKE EXCEPTING THE NORTHERLY 12 FEET OF LOT 3, BLOCK 4 OF INDIAN HILLS, FIRST ADDITION TO THE VILLAGE OF FONTANA-ON-GENEVA LAKE, WALWORTH COUNTY, WISCONSIN.

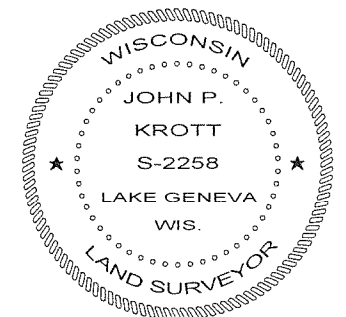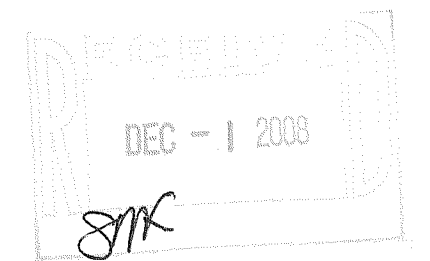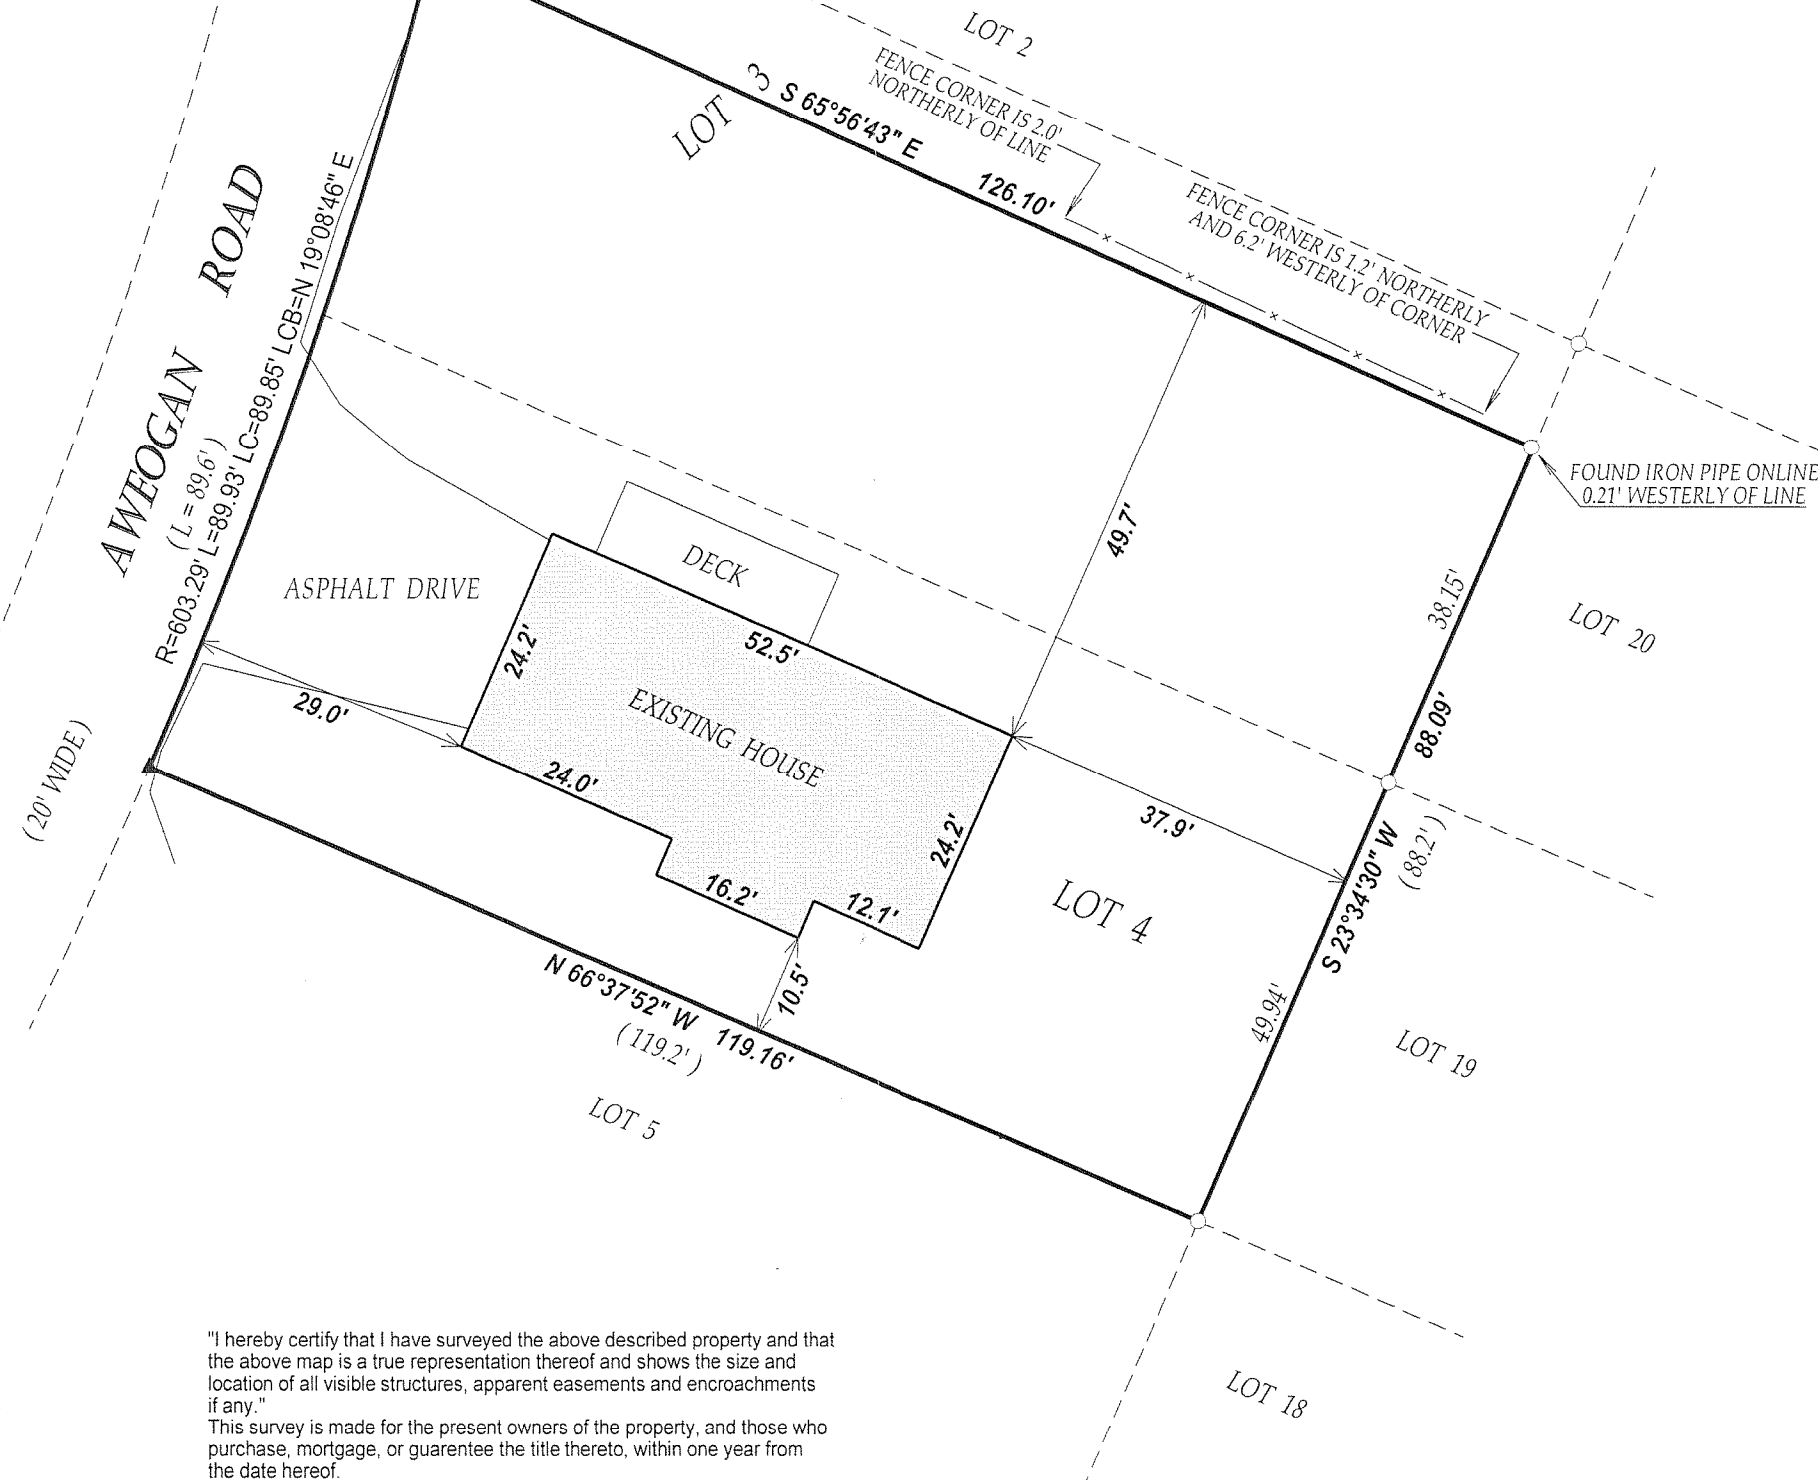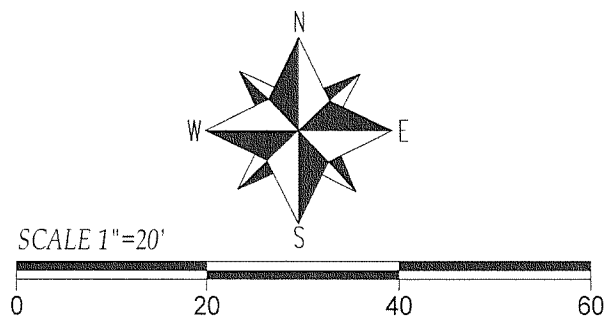

John P. Krott
JOHN KROTT S - 2258
Wisconsin Registered Land Surveyor
(original if signed in red)

"I hereby certify that I have surveyed the above described property and that the above map is a true representation thereof and shows the size and location of all visible structures, apparent easements and encroachments if any."
This survey is made for the present owners of the property, and those who purchase, mortgage, or guarantee the title thereto, within one year from the date hereof.

- LEGEND
- FOUND IRON PIPE
 - ▲ FOUND IRON SPIKE
 - △ SET P.K. NAIL
 - (XX) RECORDED AS

JOB # 08-194 TAX ID # SIHF00027 & SIHF00028

DATED THIS THE 8th DAY OF SEPTEMBER 2008.

005-2616