
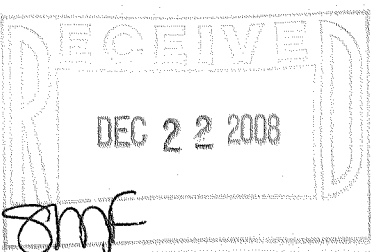
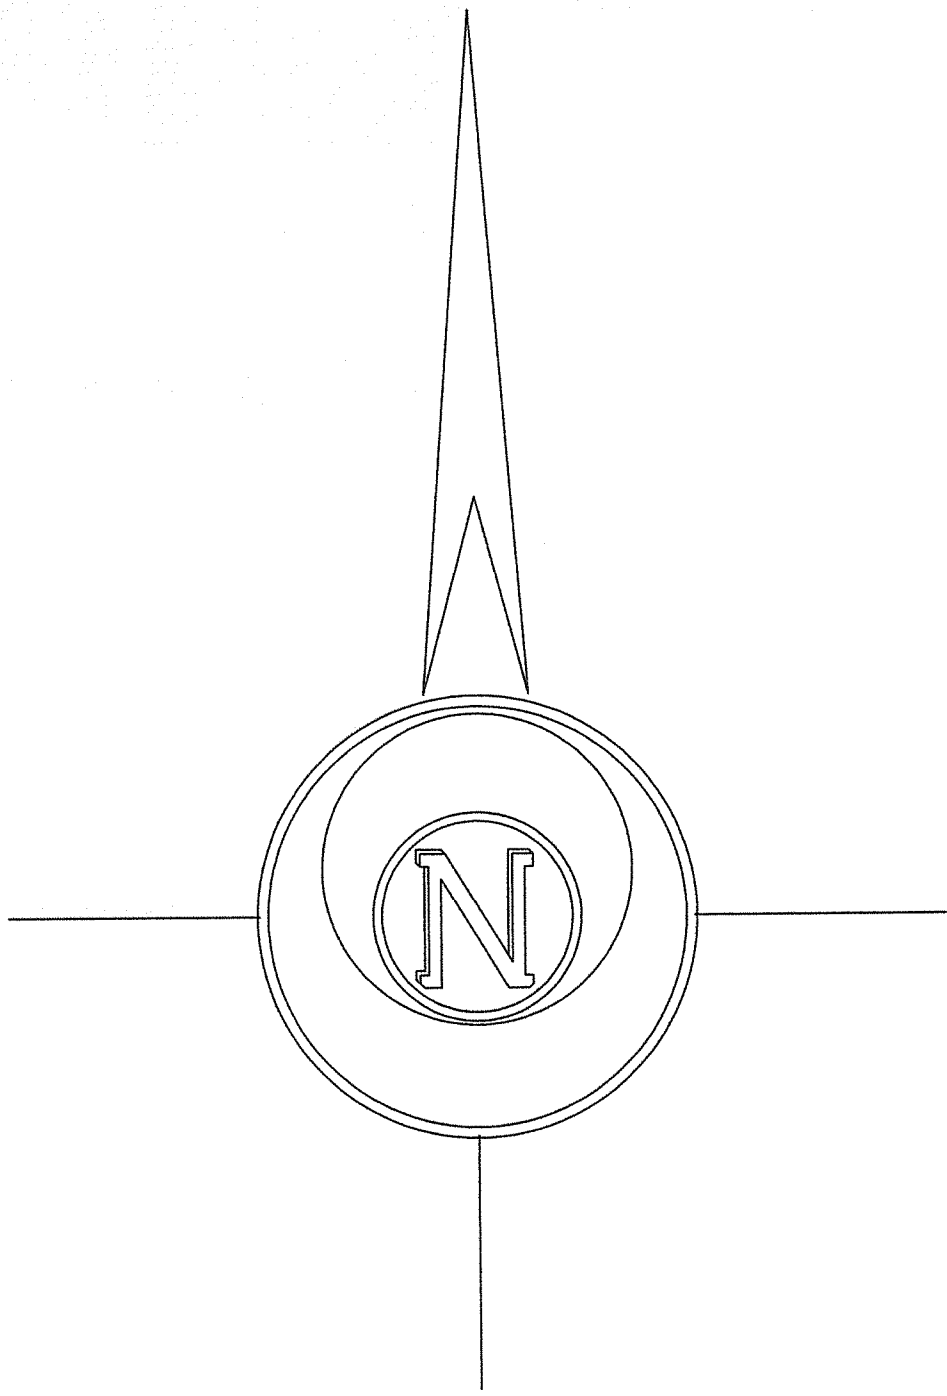


PLAT OF SURVEY

OUTLOT 60, ASSESSOR'S PLAT NO. 1 (AMENDED), VILLAGE OF FONTANA - ON - GENEVA - LAKE, WALWORTH COUNTY, WISCONSIN.

ORDERED BY: MARTHA CUCCO
KEEFE REAL ESTATE
751 GENEVA PARKWAY
LAKE GENEVA, WI 53147

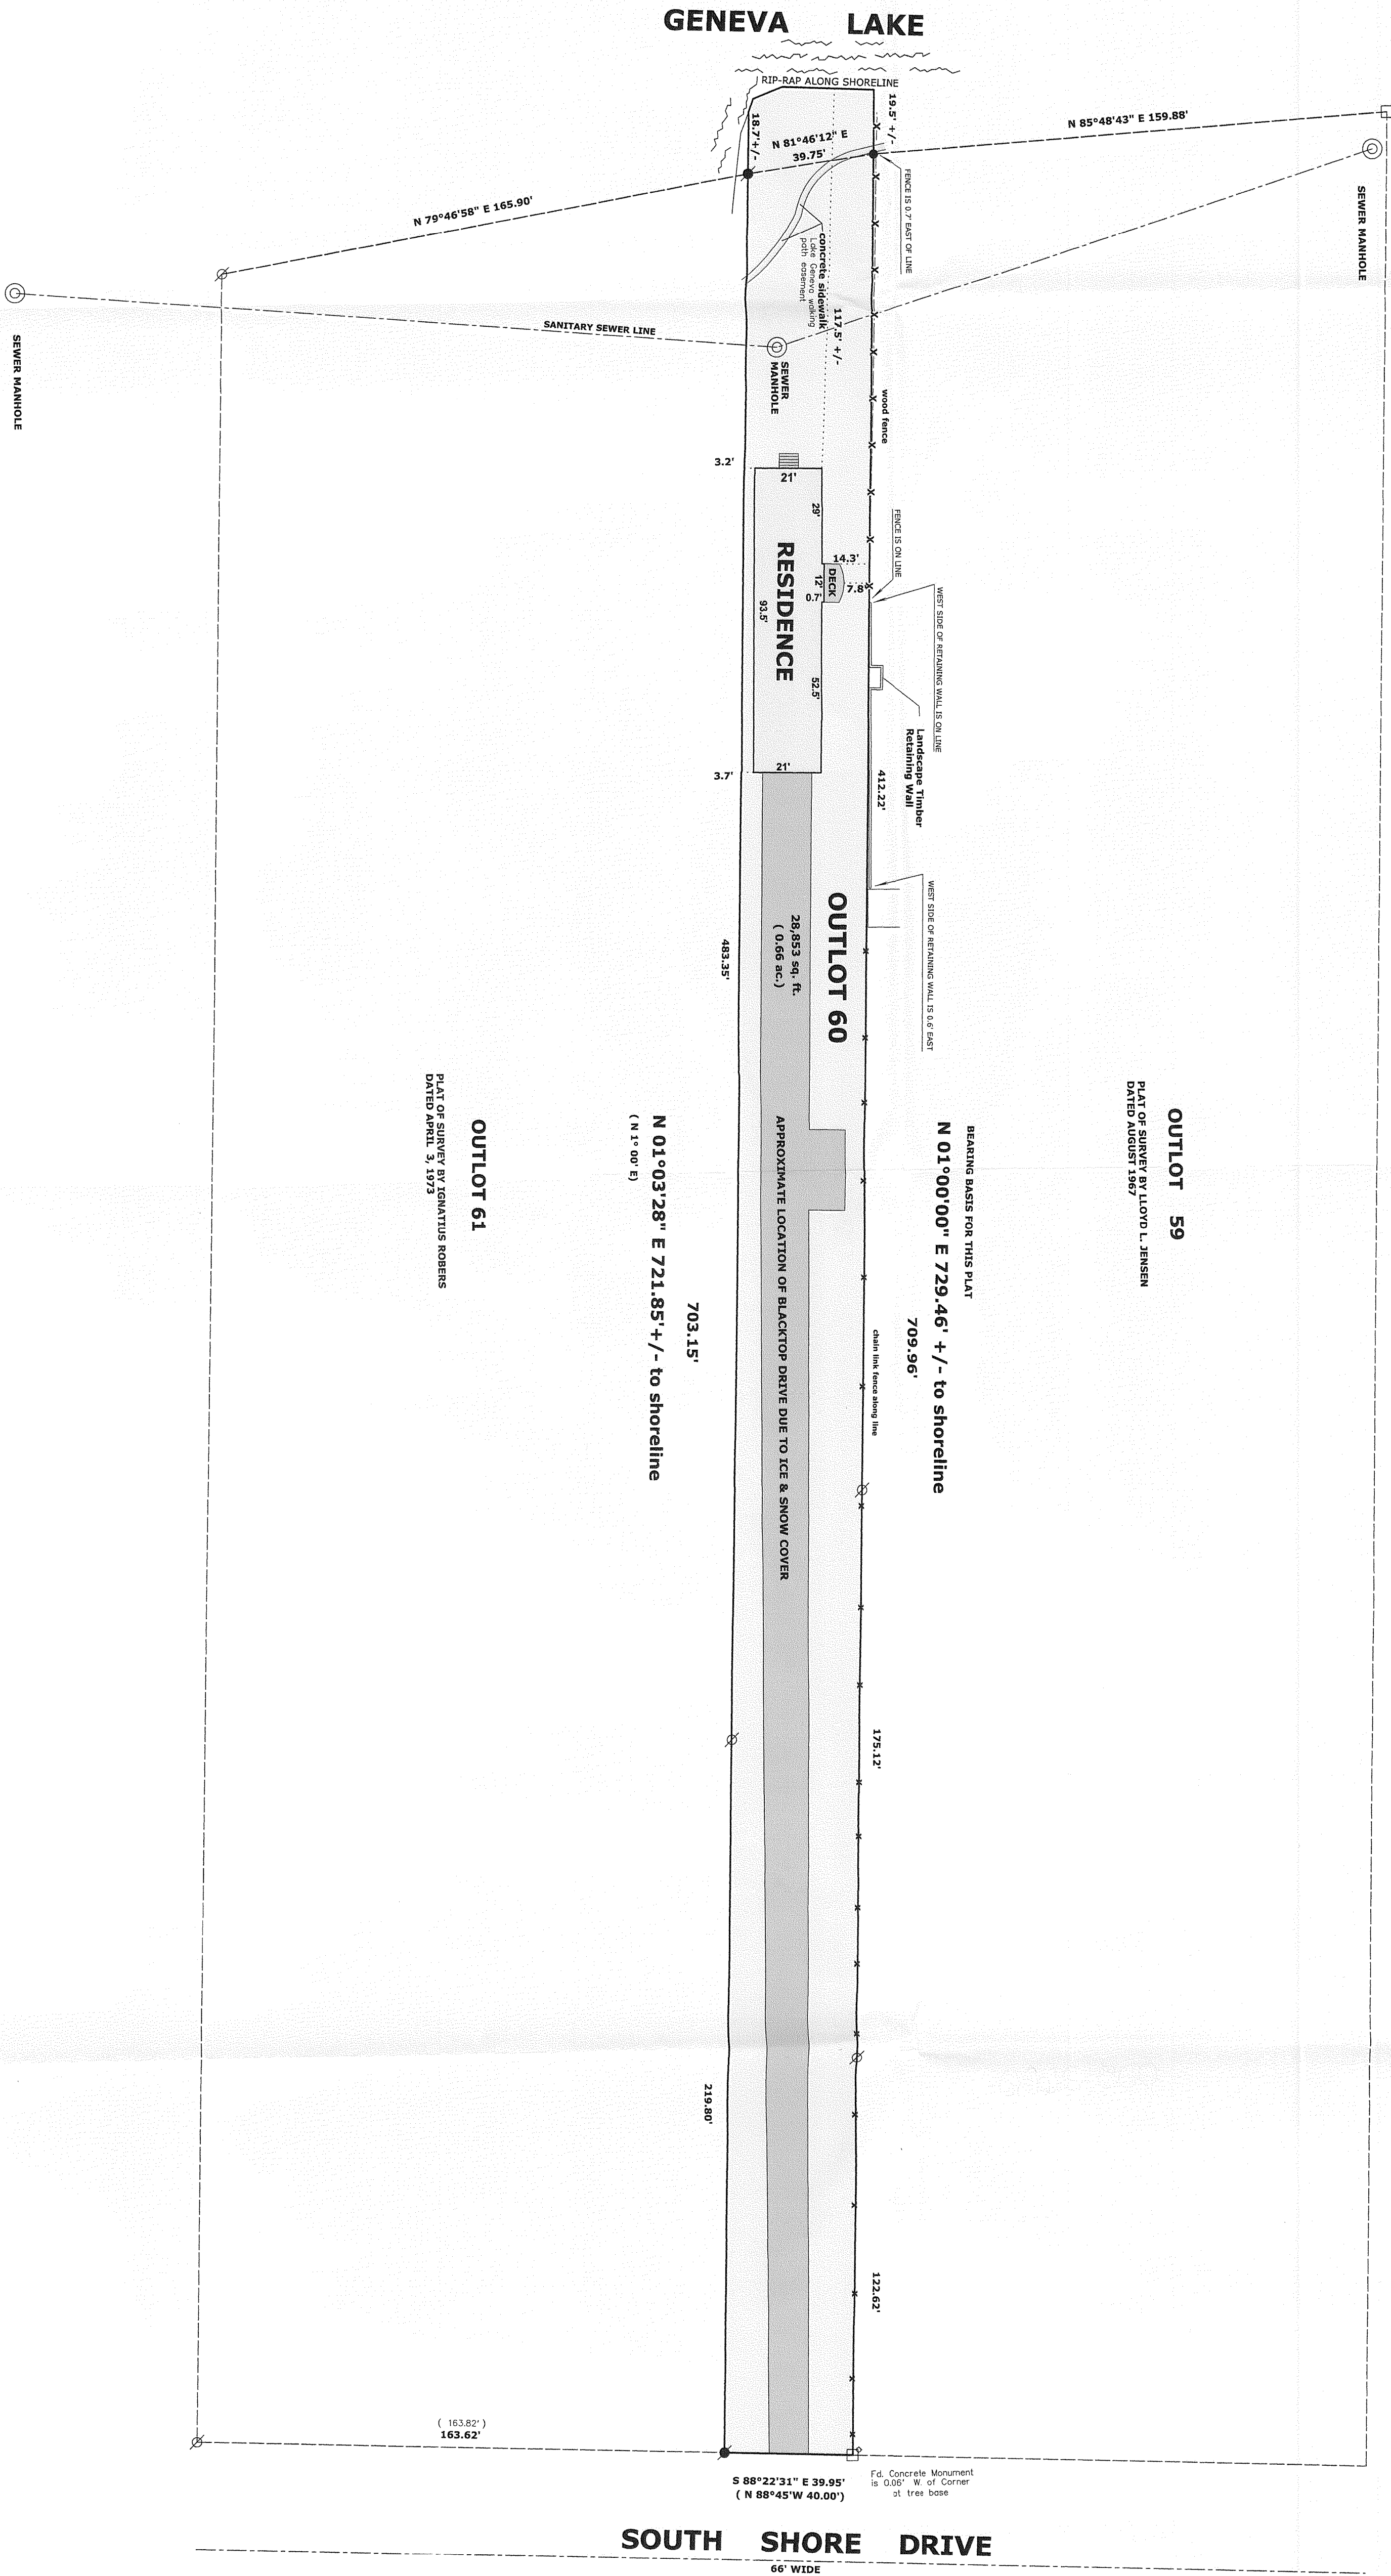

LEGEND

- FOUND IRON PIPE
- FOUND IRON ROD
- FOUND CONCRETE MONUMENT
- SET IRON ROD, 24" LONG, WEIGHING 1.5 LBS./LINEAL FT., 3/4" DIA.
- RECORDED AS DIMENSION
- EXISTING FENCE

SCALE: 1 INCH = 30 FEET

"I hereby certify that the above described property has been surveyed by me or under my direction and that the above map is a true representation thereof and shows the size and location of the property, its exterior boundaries, the location of all visible structures and dimensions of all principal buildings thereon, boundary fences, apparent easements, roadways and visible encroachments, if any."

"This survey is made for the use of the present owners of the property, and also those who purchase, mortgage, or guarantee the title thereto within one year from date hereof."

Mark L. Miritz
MARK L. MIRITZ
WISCONSIN REGISTERED
LAND SURVEYOR S-2582
DATE: DEC. 12, 2008 JOB NO. 08.1204

SURVEYOR'S NOTES:

- 1) THE RESIDENCE WAS LOCATED AT THE FOUNDATION BY THIS FIRM ON OCT. 28, 2003
- 2) BRICK WALKS WERE NOT LOCATED DUE TO ICE & SNOW COVER