


GEORGE T. DUNHAM
SURVEYING & SUBDIVIDING
DELAVAN, WISCONSIN

N

Scale - 1" = 20'
○ = Iron Pipe
● = Concrete Monument

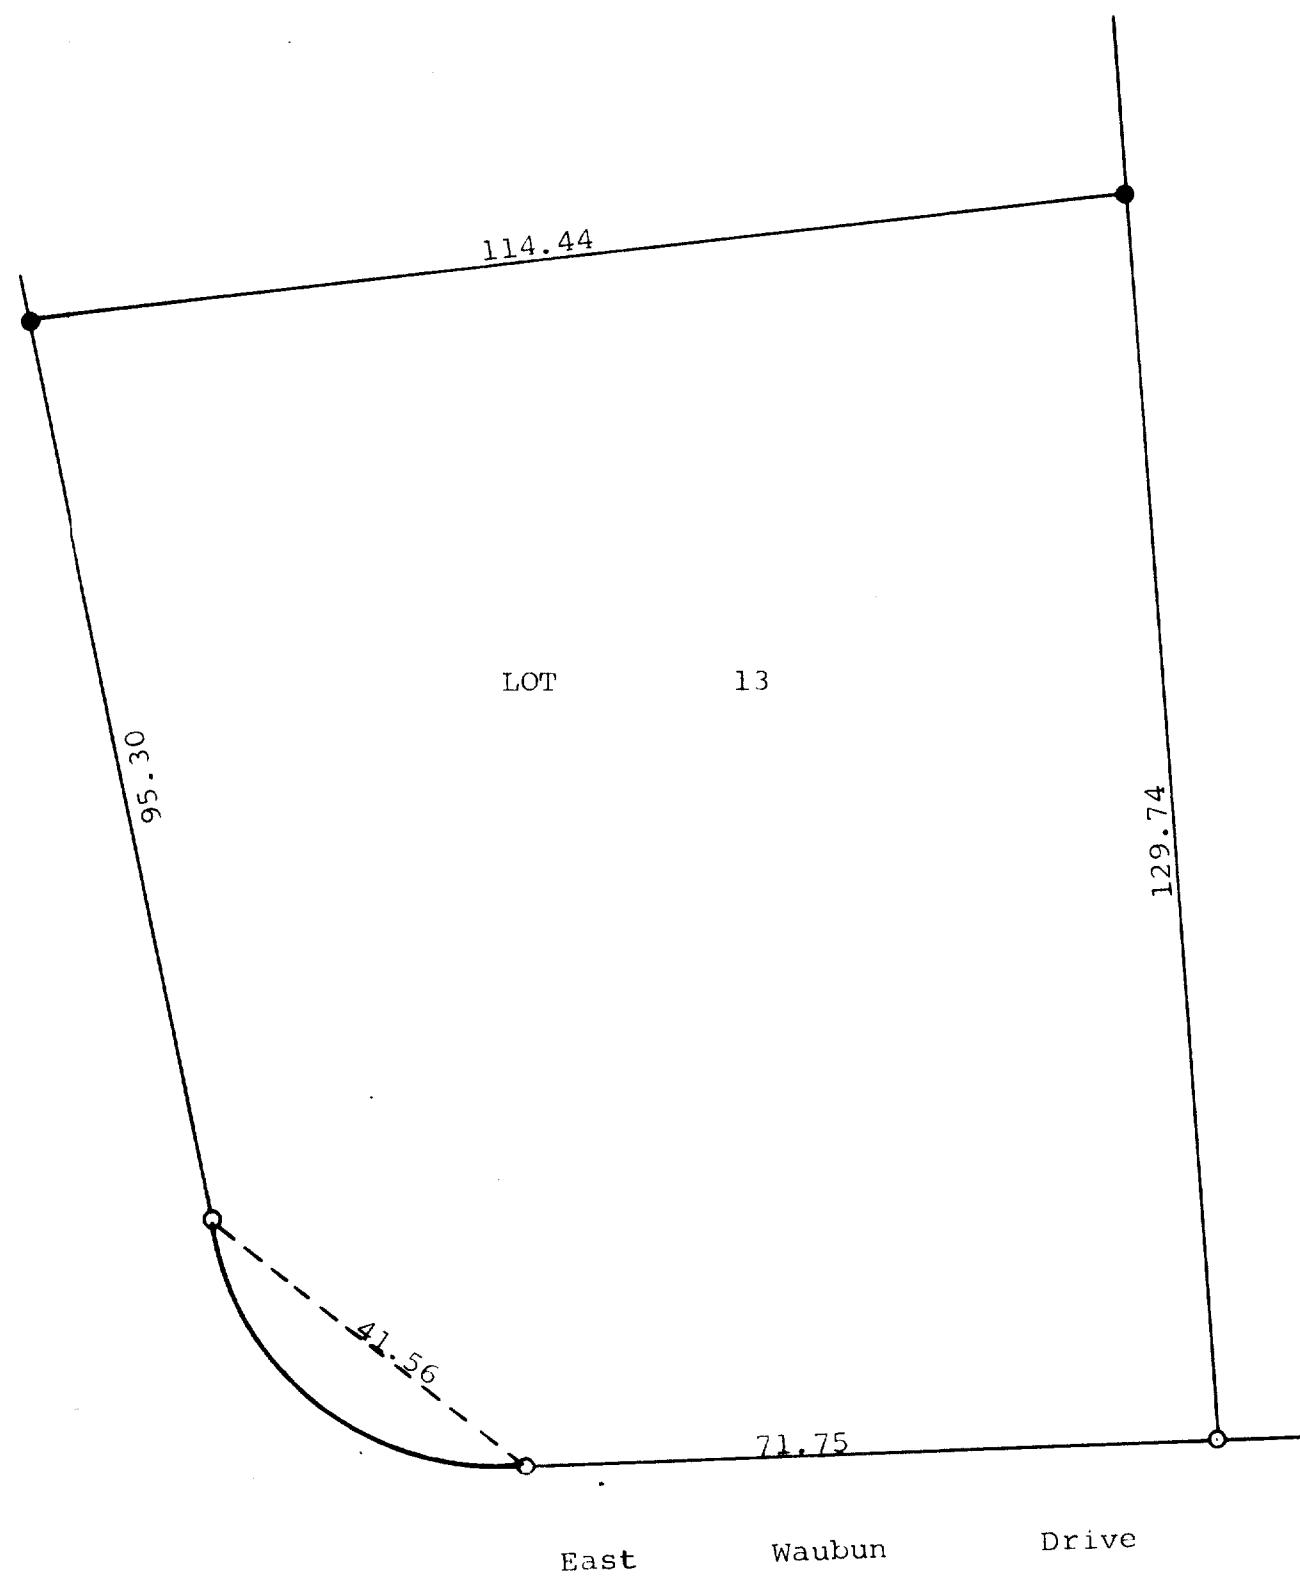

Plat of survey of Lot 13, Block "F" in Unit 3 of Country Club Estates in the Village of Fontana on Geneva Lake, Walworth County, Wisconsin.
May 28, 1971

George T. Dunham
George T. Dunham, Surveyor

