
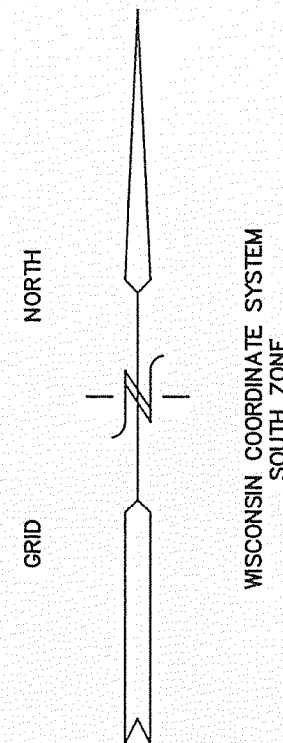


PLAT OF SURVEY


LOT 13 OF PHEASANT RIDGE

LOCATED IN THE SE 1/4 OF NE 1/4 SECTION 23, TOWN 1 NORTH, RANGE 16 EAST
VILLAGE OF FONTANA-ON-GENEVA LAKE, WALWORTH COUNTY, WISCONSIN

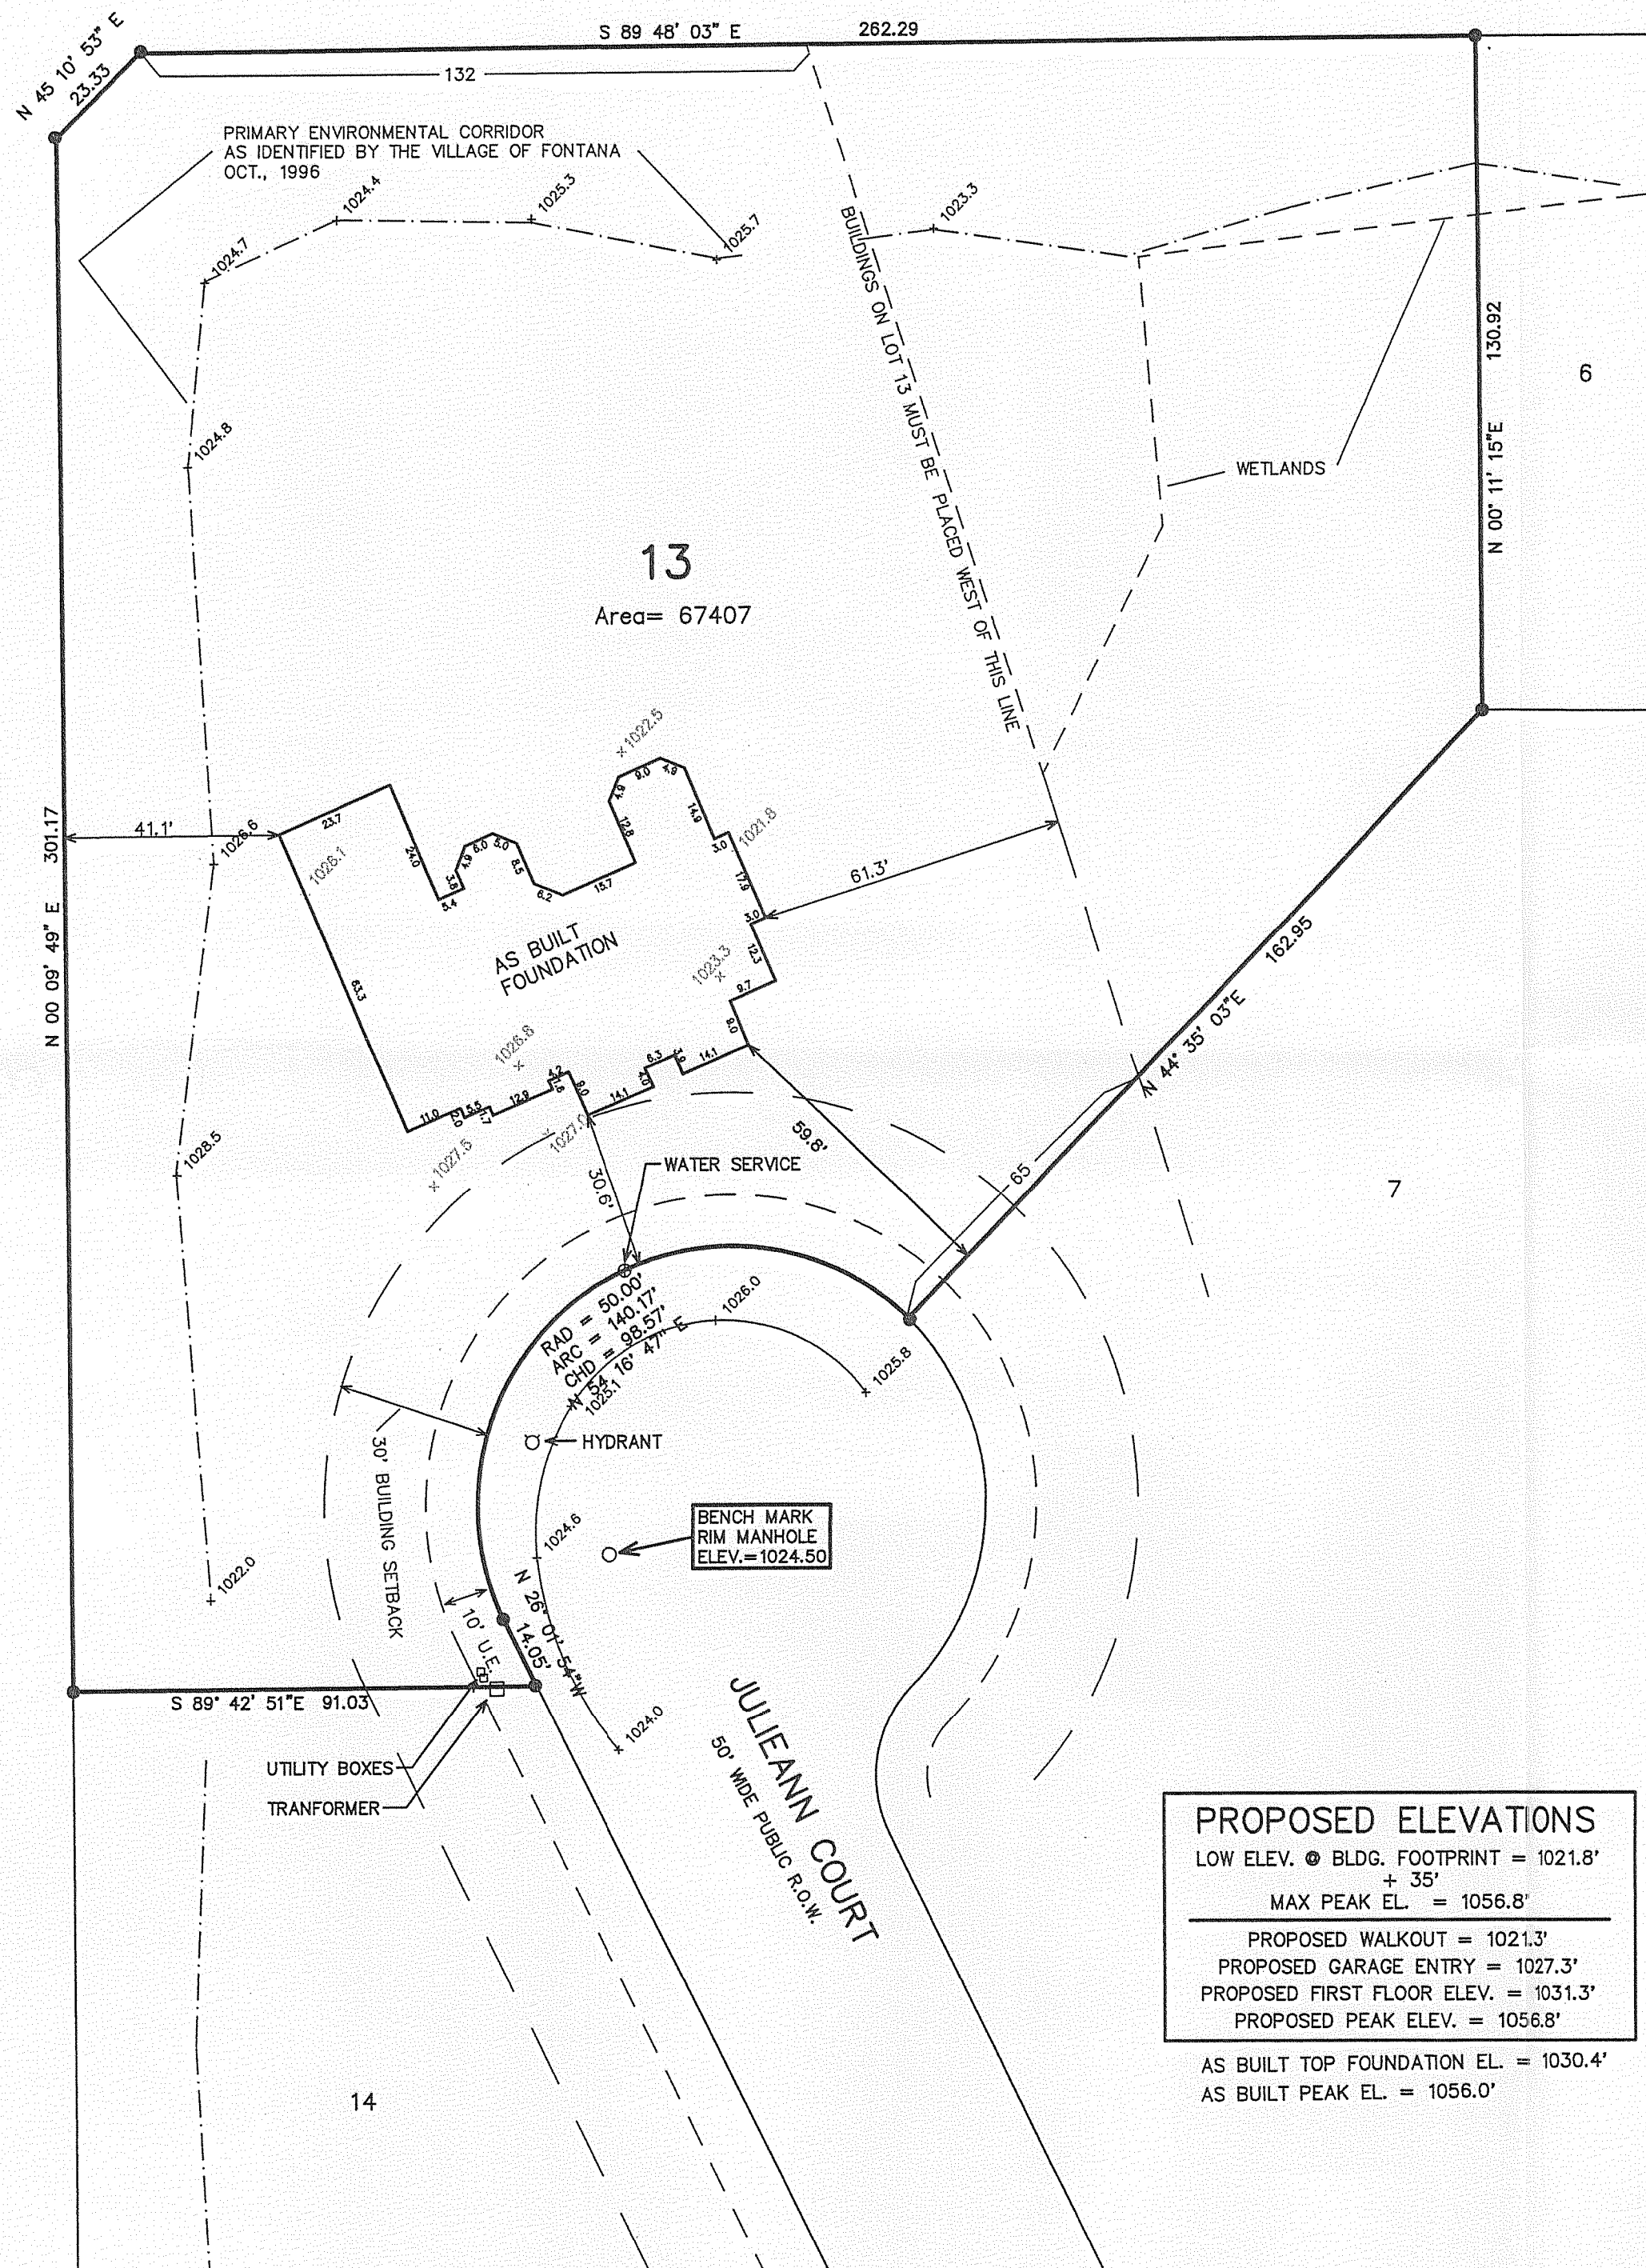

LEGEND


● = FOUND IRON REBAR STAKE

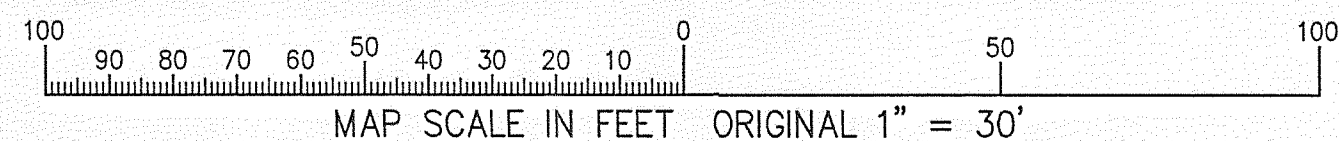

PROPOSED ELEVATIONS

LOW ELEV. @ BLDG. FOOTPRINT = 1021.8'
+ 35'
MAX PEAK EL. = 1056.8'
PROPOSED WALKOUT = 1021.3'
PROPOSED GARAGE ENTRY = 1027.3'
PROPOSED FIRST FLOOR ELEV. = 1031.3'
PROPOSED PEAK ELEV. = 1056.8'

AS BUILT TOP FOUNDATION EL. = 1030.4'
AS BUILT PEAK EL. = 1056.0'

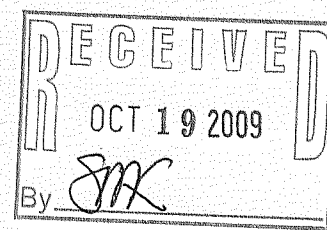

NOTE: COPIES OF THIS MAP TO WHICH THE FOLLOWING CERTIFICATE WILL APPLY SHOW SURVEYOR'S ORIGINAL SEAL AND SIGNATURE IN RED INK. COPIES BY ANY OTHER MEANS MAY HAVE ALTERATIONS WHICH DO NOT REPRESENT THE SURVEYOR'S WORK PRODUCT.


I HEREBY CERTIFY THAT THE ABOVE DESCRIBED PROPERTY HAS BEEN SURVEYED UNDER MY DIRECTION AND THAT THE ABOVE MAP IS A TRUE REPRESENTATION THEREOF AND SHOWS THE SIZE AND LOCATION OF THE PROPERTY AND ITS EXTERIOR BOUNDARIES. THIS SURVEY IS MADE FOR THE USE OF THE PRESENT OWNERS OF THE PROPERTY, AND ALSO THOSE WHO PURCHASE, MORTGAGE, OR GUARANTEE THE TITLE THERETO WITHIN ONE YEAR FROM THE DATE HEREOF.



DATED: 12-14-2001

PETER S. GORDON R.L.S. 2101

REVISED 01-15-2009
TO SHOW PROPOSED RESIDENCE
& GRADES
REVISED 04-29-2009
TO SHOW AS BUILT FOUNDATION
REVISED 09-10-2009
TO SHOW PEAK AS BUILT EL.

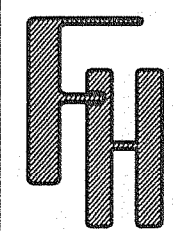

WORK ORDER BY: BILL HENRY
500 HENLOCK LANE
LIBERTYVILLE, IL 60048

FARRIS, HANSEN & ASSOCIATES, INC.
Engineering, Architecture, Surveying
7 Ridgway Court P.O. Box 437
ELKHORN, WISCONSIN 53121
Office: (414) 723-2098
Fax: (414) 723-5886

REVISIONS
1/14/2002 LK
ADDED TOPO.
3/24/2009 LK
ADJ. GRADES

PROJECT NO.
3997.13
DATE:
8/23/99
SHEET NO.
1 OF 1

SPHR-13

005-2680