


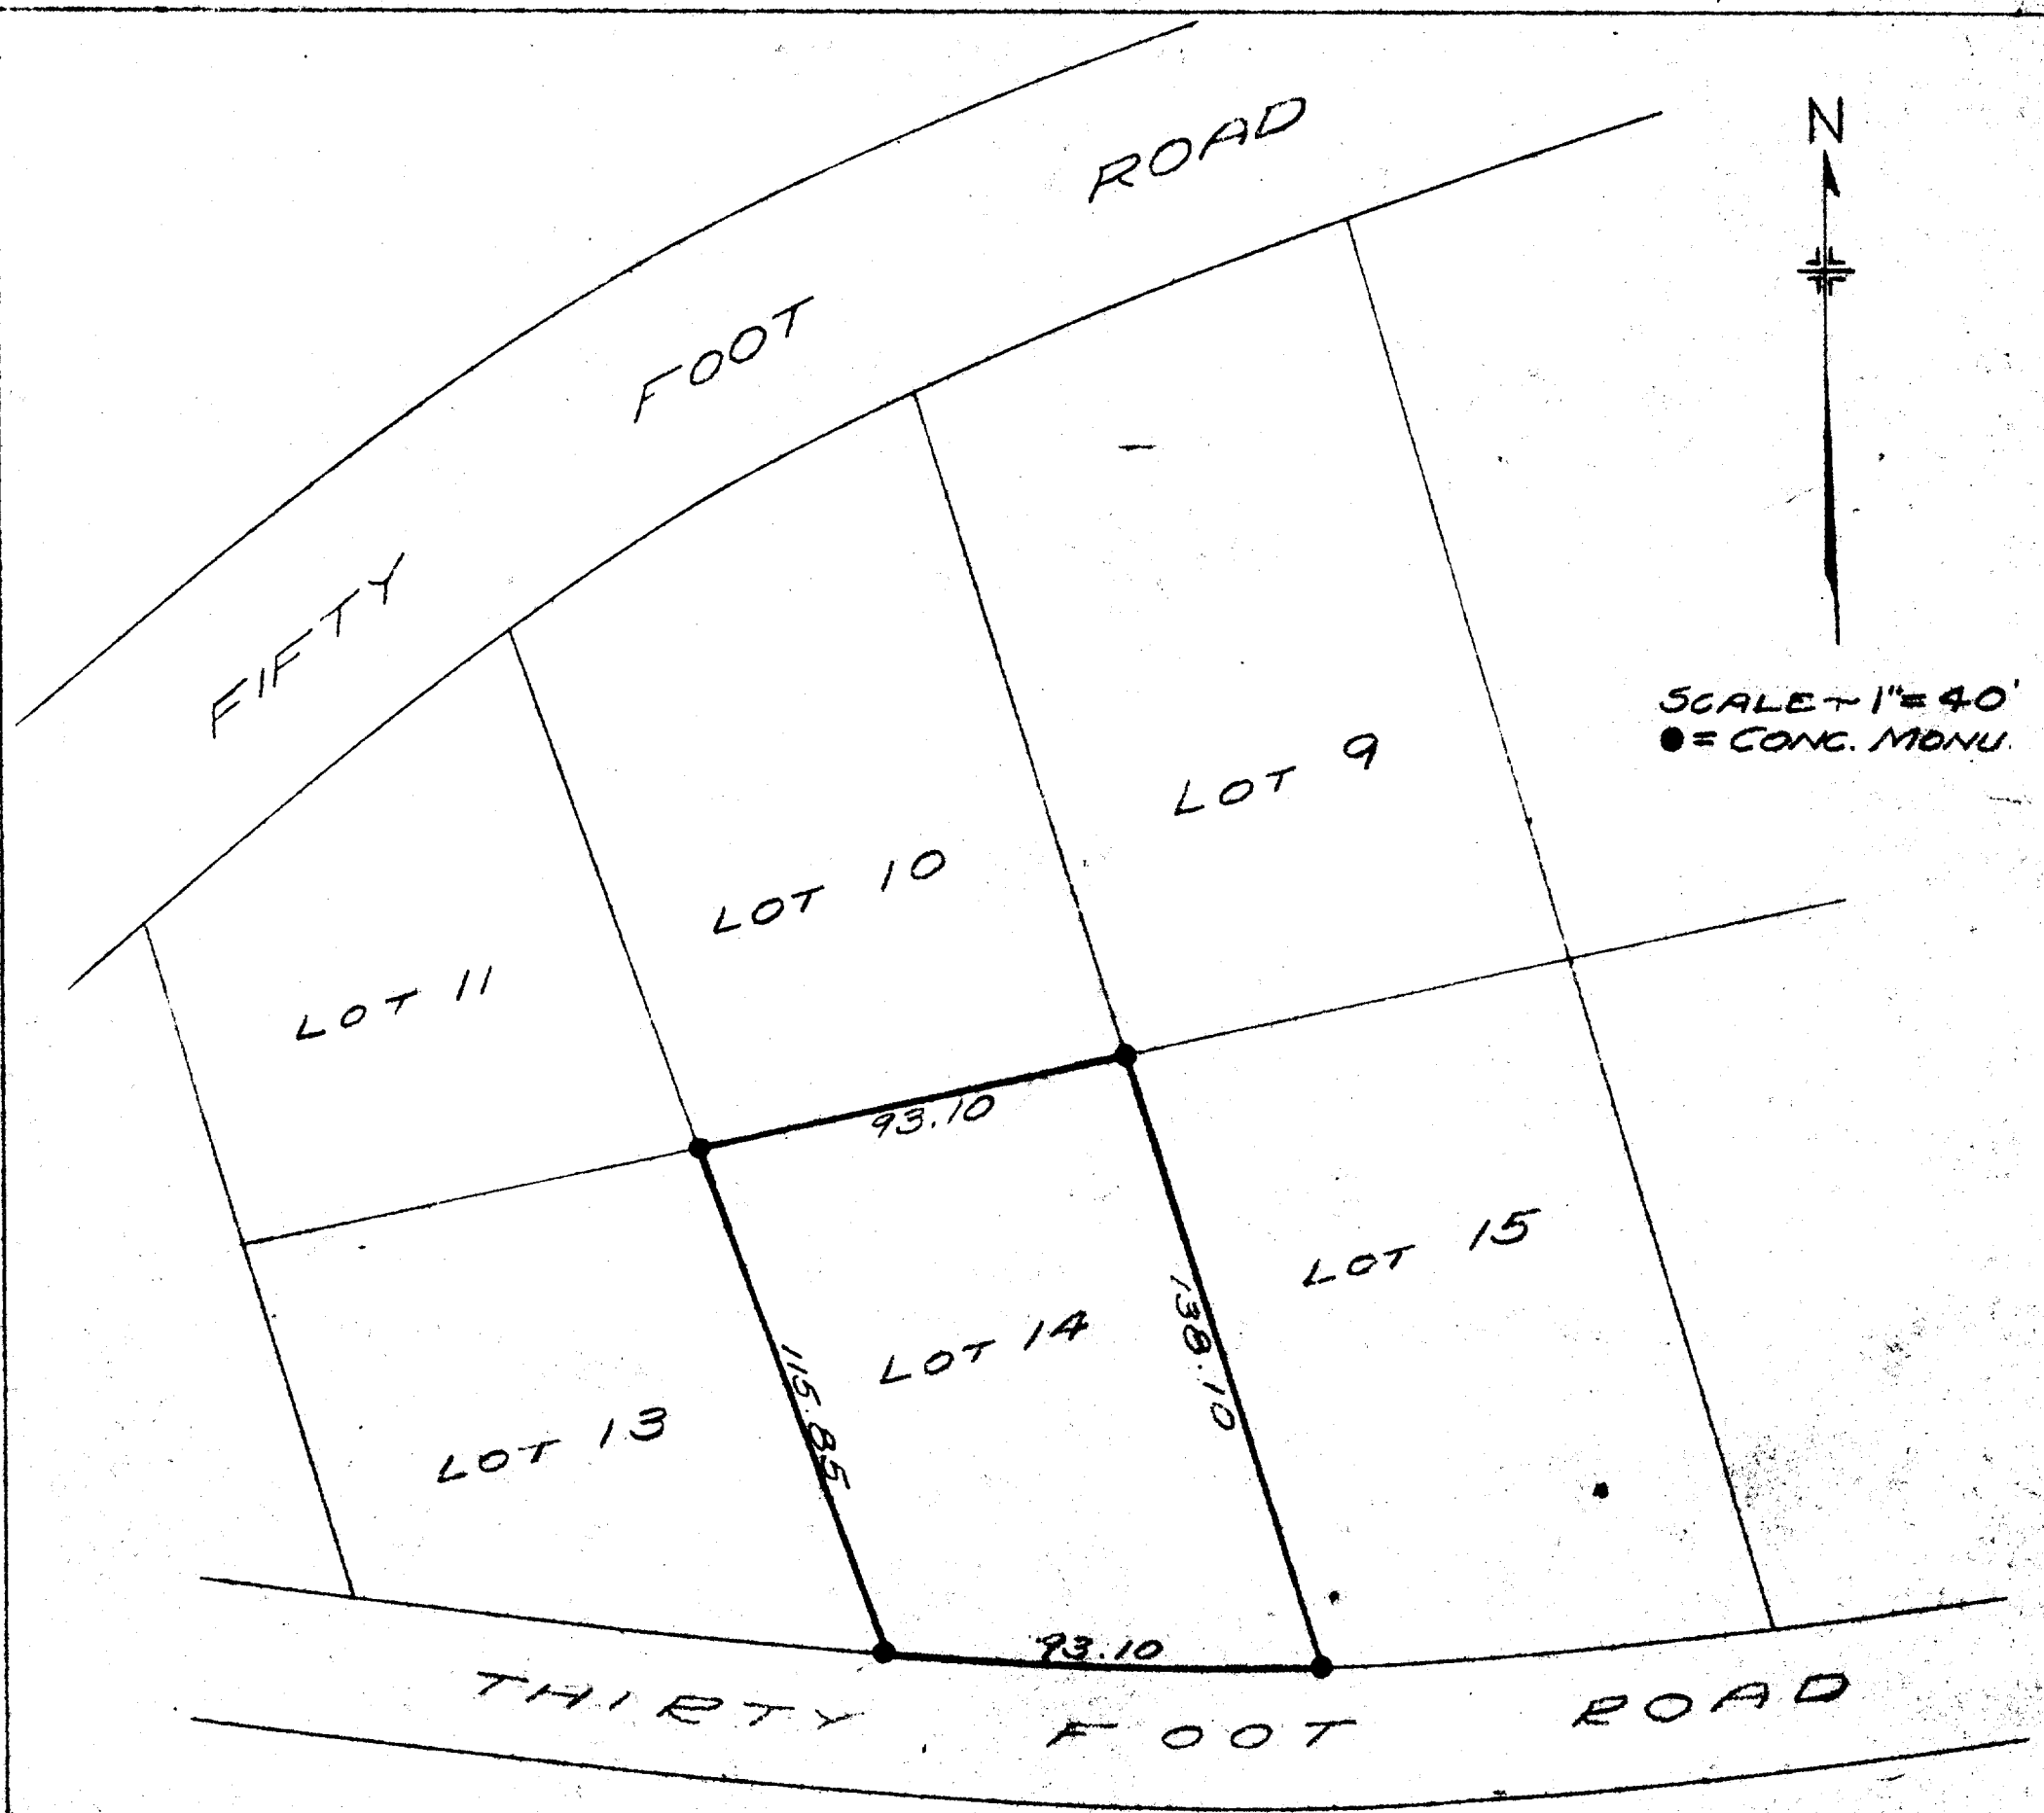

PLAT OF SURVEY OF LOT 14 OF UNIT 2 OF COUNTRY CLUB ESTATES, A SUBDIVISION LOCATED IN SECTIONS 14 AND 23, T1N, R16E OF WALWORTH COUNTY, WISCONSIN.

NOV 26, 1945

Lloyd L. Jensen
COUNTY SURVEYOR