


PREPARED FOR:
ICON DEVELOPMENT GROUP
JOHN MATUSIK
2413 W. ALGONQUIN RD.
SUITE 247
ALGONQUIN, IL 60102

KROTT SURVEYING INC.
N3705 WILLOW BEND LANE
LAKE GENEVA WI. 53147
PHONE # (262)248-3697
FAX # (262)249-0639

PLAT OF SURVEY
-OF-

ALL THAT PART OF LOTS 92 AND 93 LYING NORTH OF A LINE BEGINNING AT A POINT 14 FEET NORTH OF THE NORTHEAST CORNER OF LOT 94 IN BUENA VISTA SUBDIVISION AND EXTENDING DUE WEST TO A POINT 4 FEET NORTH OF THE NORTHWEST CORNER OF SAID LOT 93, ALL IN BUENA VISTA SUBDIVISION IN SECTIONS 11 AND 14, TOWNSHIP 1 NORTH, RANGE 16 EAST, VILLAGE OF FONTANA-ON-GENEVA LAKE, WALWORTH COUNTY, WISCONSIN.

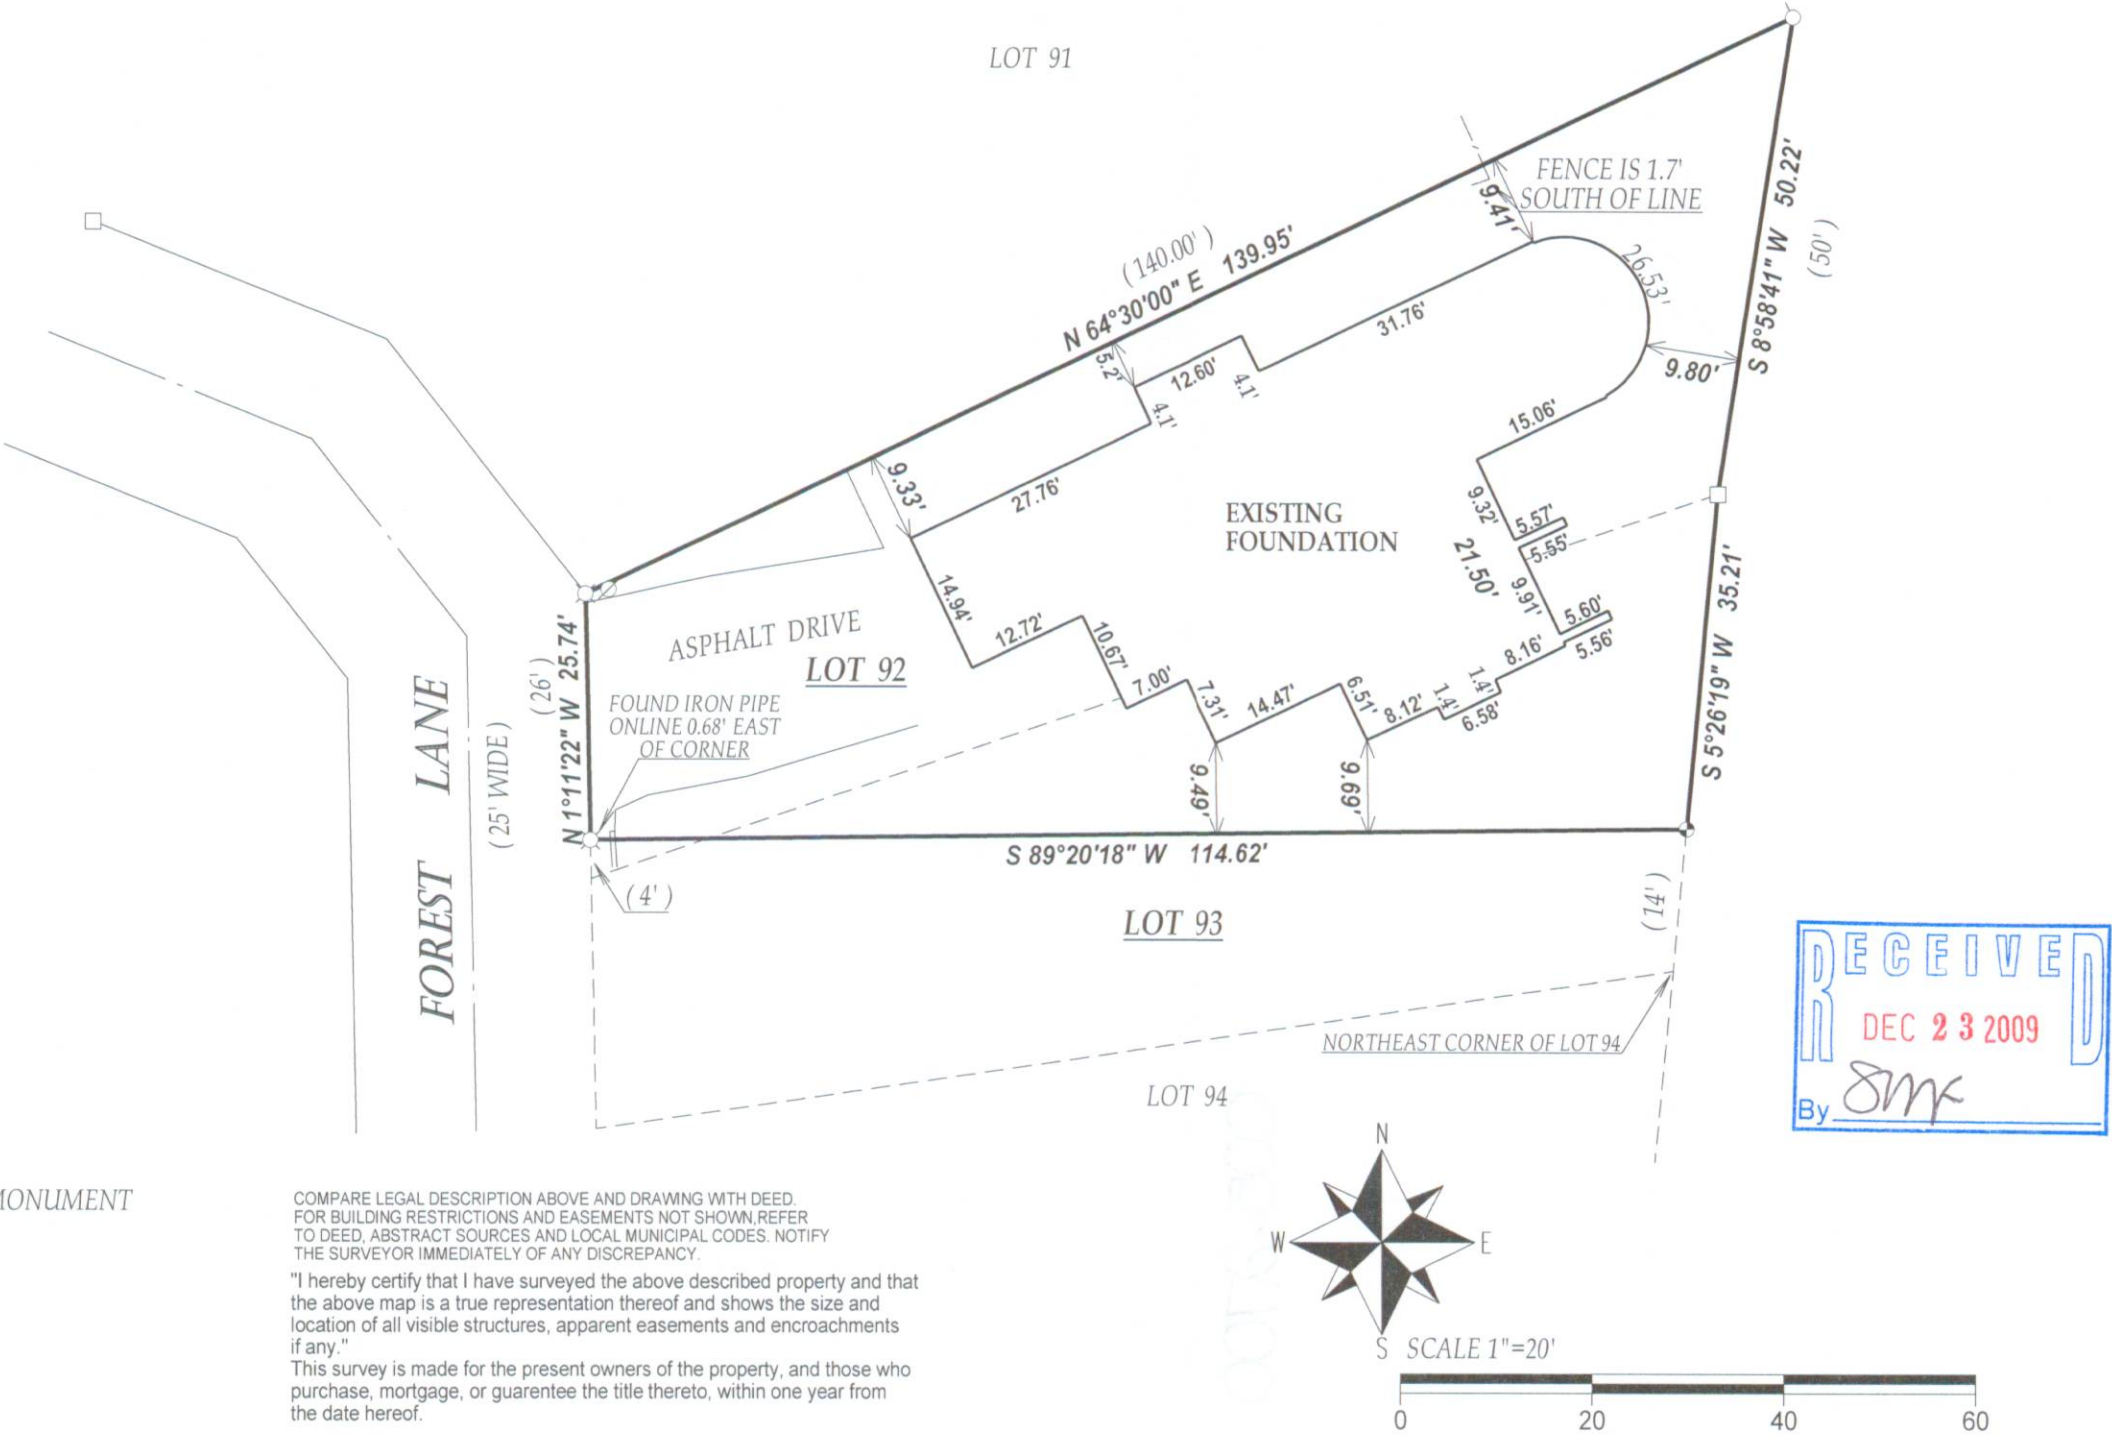

GENEVA LAKE

LEGEND

- FOUND P.K. NAIL
- FOUND IRON PIPE
- FOUND IRON BAR
- FOUND CONCRETE MONUMENT
- UTILITY POLE

(XX) RECORDED AS

TAX ID # SBV00066

JOB # 05-612AB

COMPARE LEGAL DESCRIPTION ABOVE AND DRAWING WITH DEED. FOR BUILDING RESTRICTIONS AND EASEMENTS NOT SHOWN, REFER TO DEED, ABSTRACT SOURCES AND LOCAL MUNICIPAL CODES. NOTIFY THE SURVEYOR IMMEDIATELY OF ANY DISCREPANCY.

"I hereby certify that I have surveyed the above described property and that the above map is a true representation thereof and shows the size and location of all visible structures, apparent easements and encroachments if any."

This survey is made for the present owners of the property, and those who purchase, mortgage, or guarantee the title thereto, within one year from the date hereof.



DATED THIS 25th, DAY OF NOVEMBER, 2009

John P. Krott

JOHN KROTT S - 2258
Wisconsin Registered Land Surveyor
(original if signed in red)

005-2700