


SITE PLAN

**LOT 5 AND LOT 6 OF INDIAN HILLS SUBDIVISION,
LOCATED IN THE VILLAGE OF FONTANA-ON-GENEVA
LAKE, WALWORTH COUNTY, WISCONSIN.**

ORDERED BY: SCHAUDER BUILDING, INC.
4115 HWY 51 NORTH
JANESVILLE, WI 53545

SITE ADDRESS: 720 ADAHI WAY

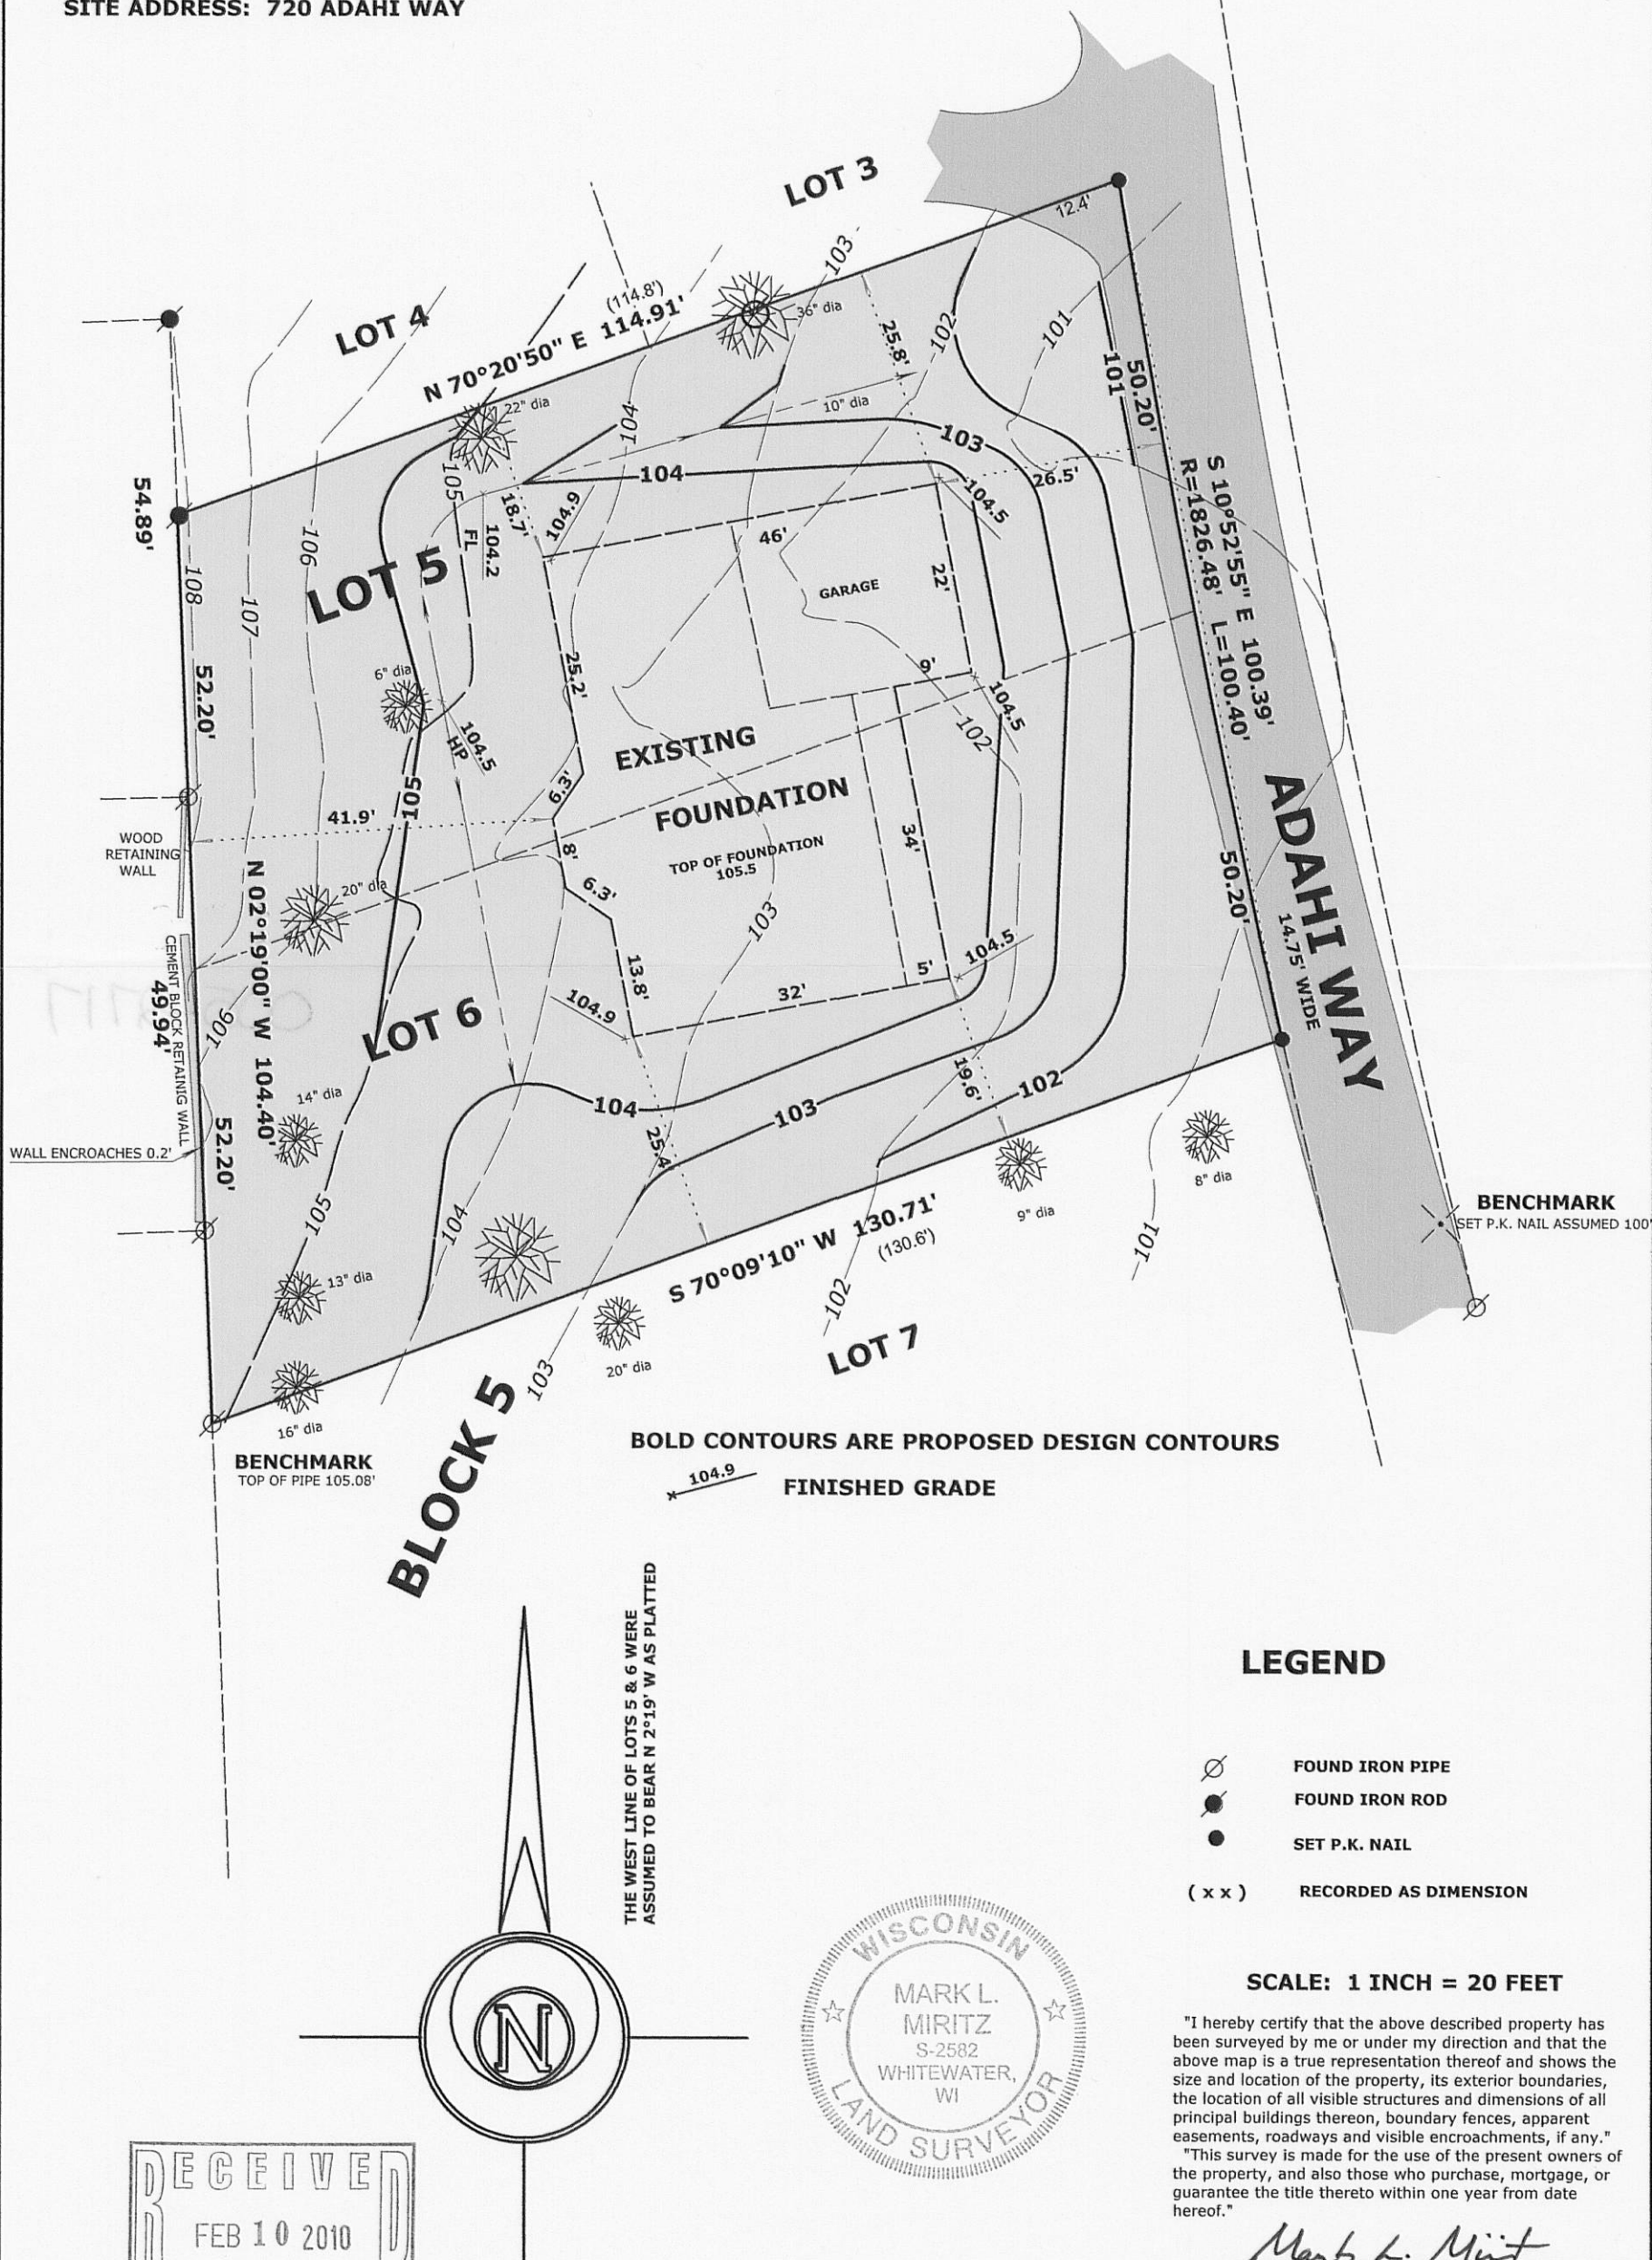

LEGEND

- FOUND IRON PIPE
- FOUND IRON ROD
- SET P.K. NAIL
- (x x) RECORDED AS DIMENSION

SCALE: 1 INCH = 20 FEET


"I hereby certify that the above described property has been surveyed by me or under my direction and that the above map is a true representation thereof and shows the size and location of the property, its exterior boundaries, the location of all visible structures and dimensions of all principal buildings thereon, boundary fences, apparent easements, roadways and visible encroachments, if any."
"This survey is made for the use of the present owners of the property, and also those who purchase, mortgage, or guarantee the title thereto within one year from date hereof."

Mark L. Miritz
MARK L. MIRITZ

**WISCONSIN REGISTERED
LAND SURVEYOR S-2582**

DATE: OCT. 29, 2009 JOB NO. 09.903

REVISED DEC. 8, 2009 TO SHOW FOUNDATION "AS BUILT"

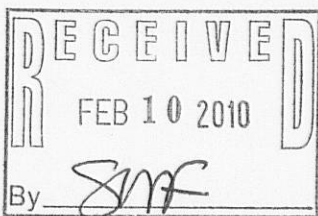

SIH-70