


KROTT SURVEYING, INC.
N3705 WILLOW BEND LANE
LAKE GENEVA, WI 53147
(262)-248-3697


-OF-

GENEVA LAKE

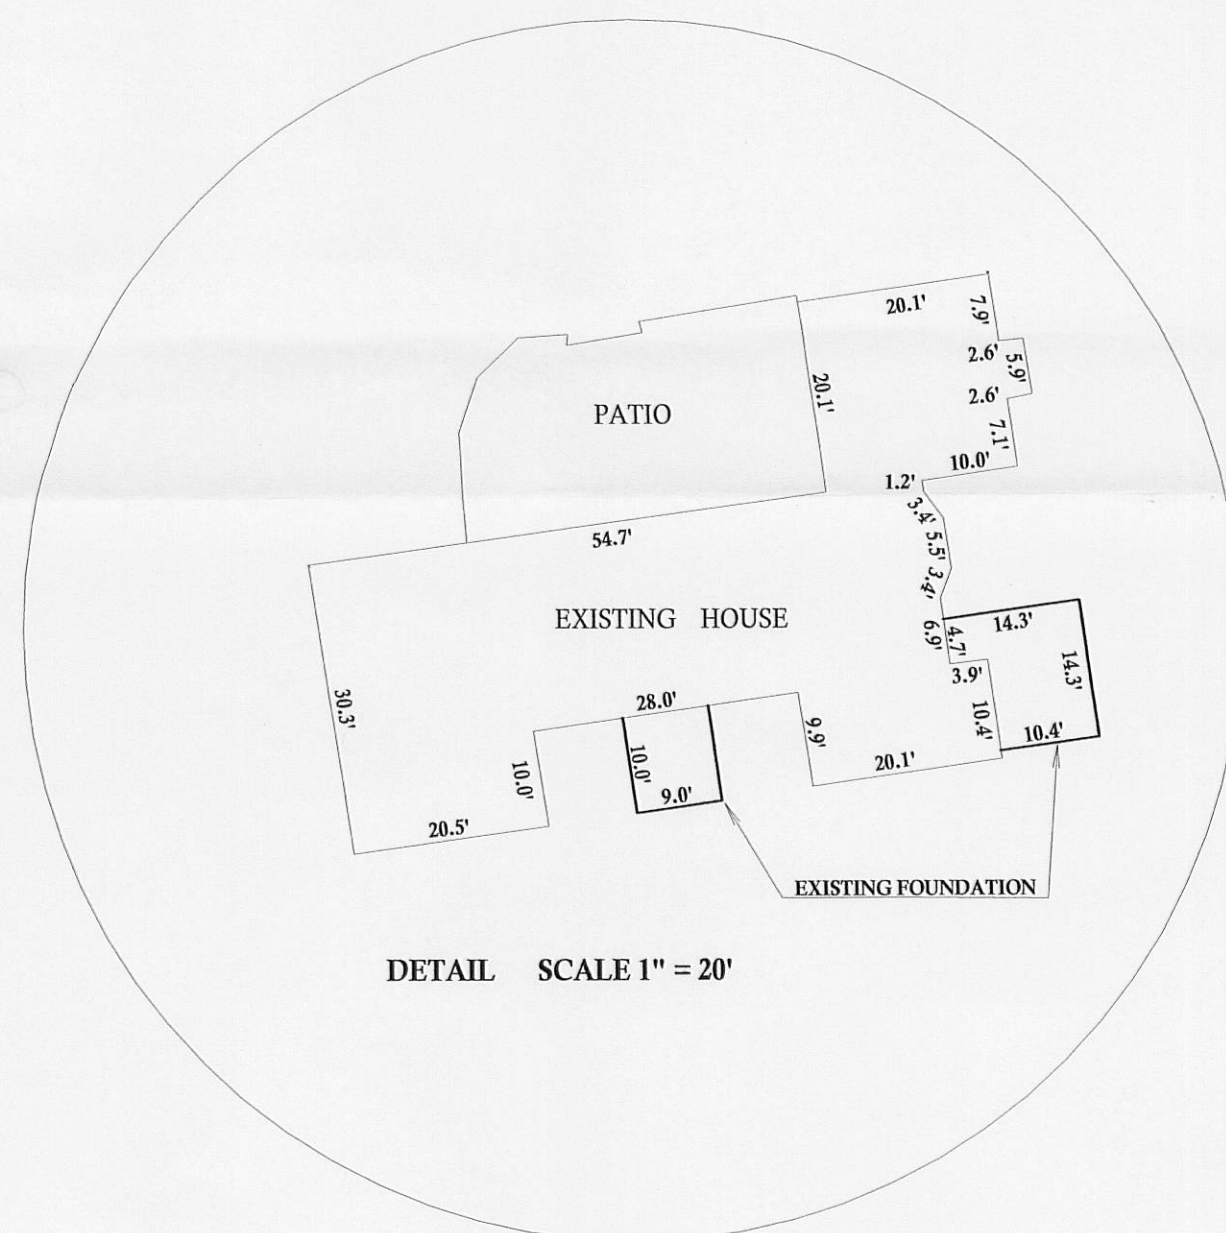

DETAIL SCALE 1" = 20'

	FOUND 5" DIA CONCRETE MONUMENT WITH IRON ROD IN CENTER
	FOUND CONCRETE MONUMENT WITH BRASS CAP
	FOUND IRON PIPE
	SET IRON PIPE
	FOUND RAIL ROAD SPIKE IN BLACKTOP DRIVE
	UTILITY POLE
	OVER HEAD UTILITIES
	CONCRETE ACCESS COVER
	PUBLIC SANITARY SEWER MANHOLE
(XXXX)	RECORDED AS
	SANITARY SEWER LINE

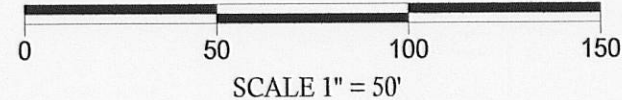


SOUTH WEST CORNER OF
THE NORTHEAST 1/4 OF
SECTION 13, T.1.N. , R.16.E

SOUTHEAST CORNER OF THE
NORTHEAST 1/4 OF SECTION
13, T.1.N. , R.16.E.


This survey is made for the exclusive use of the present owners of the property, and also those who purchase, mortgage, or insure the title thereto within one (1) year from date hereof; and as to them I warrant the accuracy of said survey map.

JOB # 99-017UD 2010

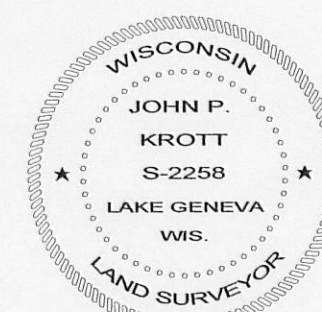

John P. Holt

JOHN KROTT S - 2258
Wisconsin Registered Land Surveyor
(original if signed in red)

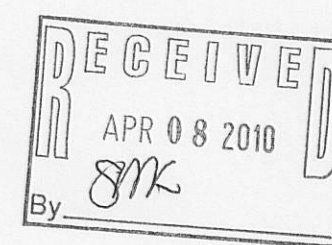

005-2721