

PREPARED FOR
AMY J. GIOVANNONI
GODFREY, LEIBSLE, BLACKBOURN & HOWARTH, S.C.
354 SEYMOUR COURT
ELKHORN WI. 53121




PLAT OF SURVEY

-OF-

UNIT 590 OF ABBEY SPRINGS CONDOMINIUM NO. 13, LOCATED IN
THE SOUTHEAST 1/4 OF SECTION 13, TOWN 1 NORTH, RANGE 16
EAST, WALWORTH COUNTY, WISCONSIN.

KROTT SURVEYING INC.

N3705 WILLOW BEND LANE
LAKE GENEVA WI. 53147
PHONE # (262)248-3697
FAX # (262)249-0639

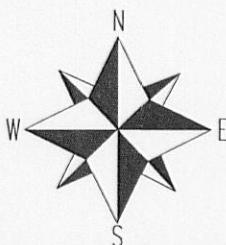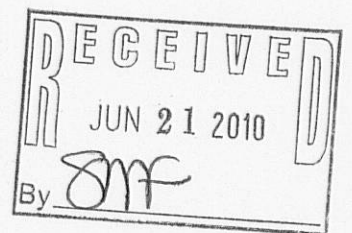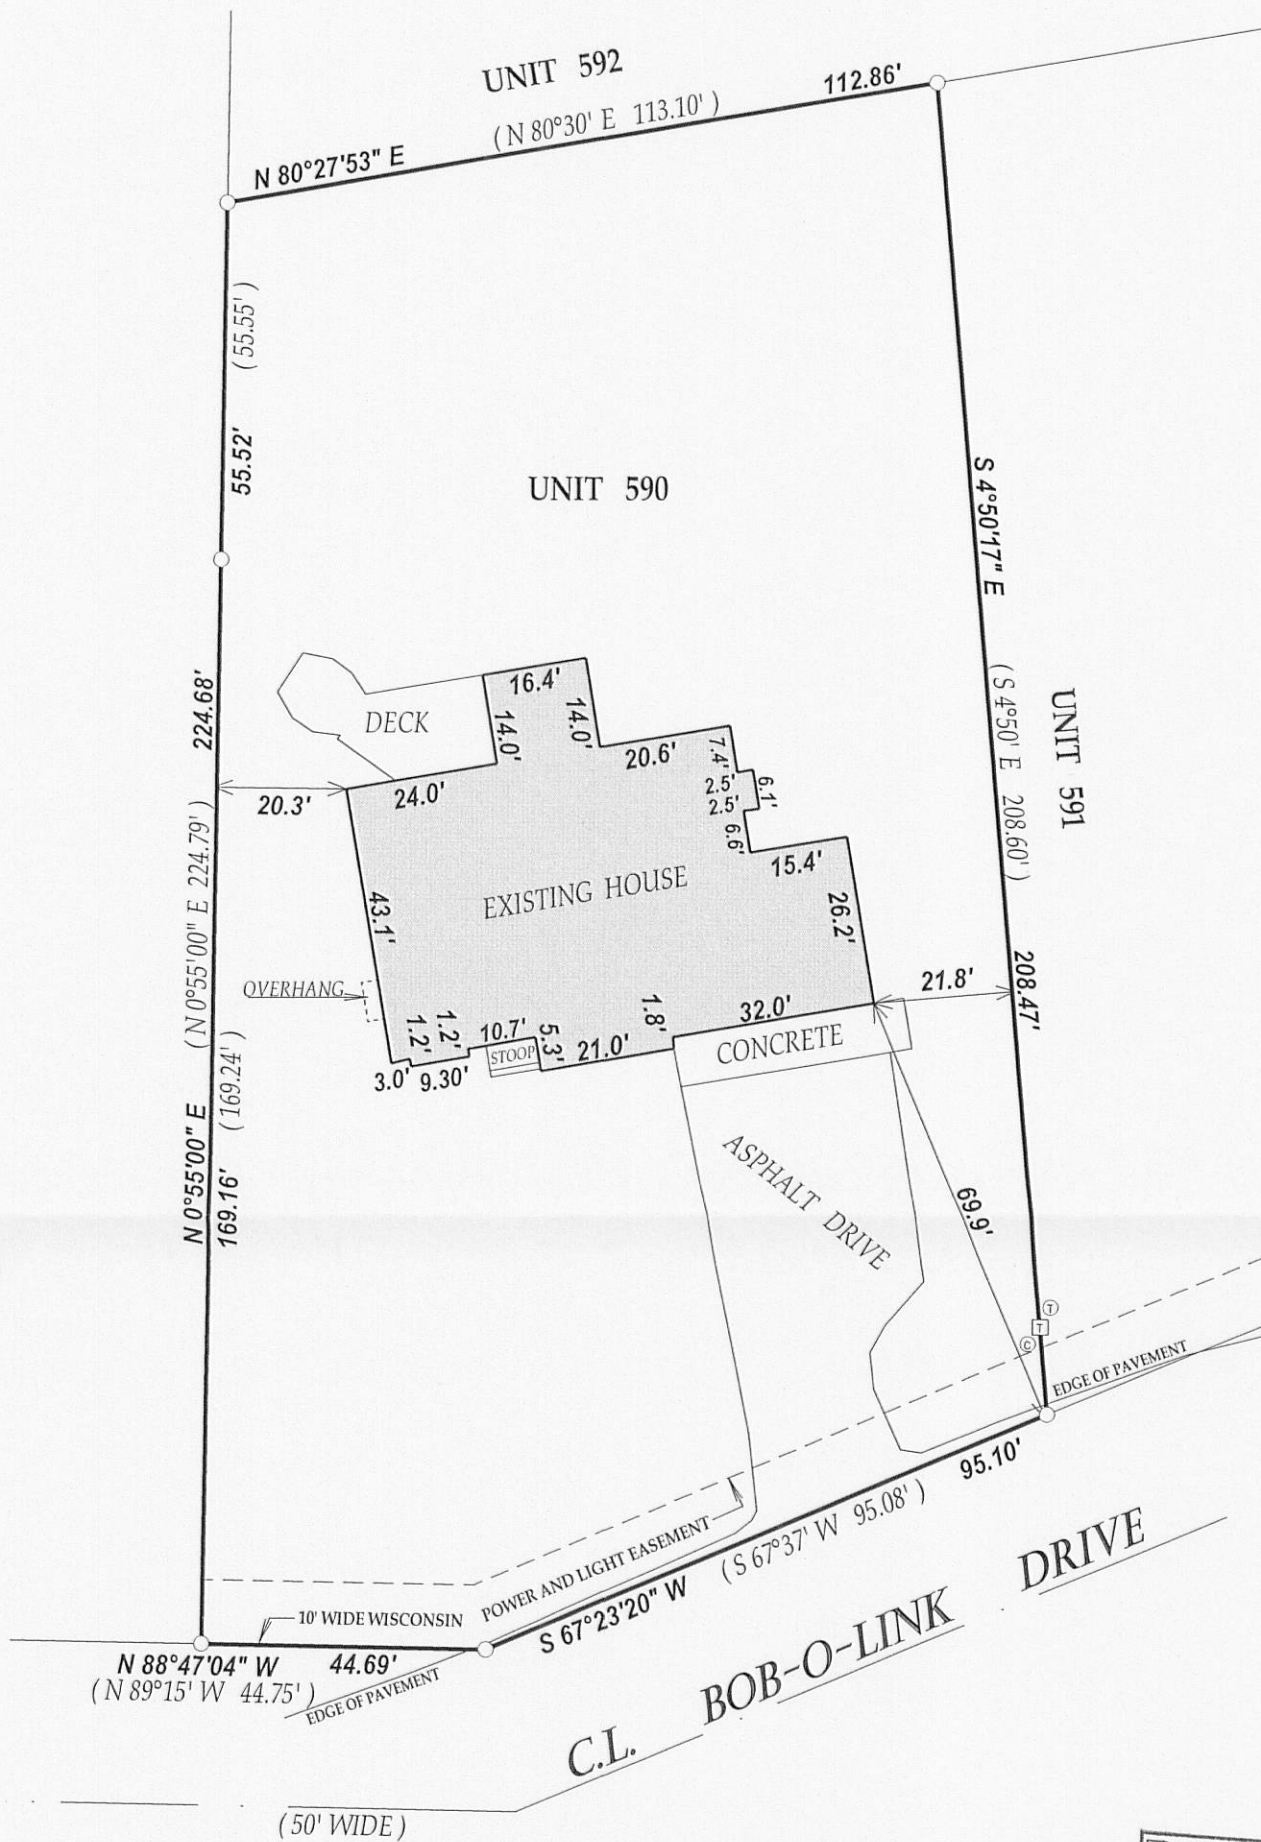


SCALE 1" = 30'

0 30 60 90

NOTE: BEARINGS REFERENCED TO THE RECORDED PLAT

I have surveyed the above-described property and the above map is a true representation thereof and shows the size and location of the property, its exterior boundaries, the location and dimensions of all structures thereon, fences apparent easements and roadways and visible encroachments, if any.

This survey is made for the exclusive use of the present owners of the property, and also those who purchase, mortgage, or insure the title thereto within one (1) year from date hereof; and as to them I warrant the accuracy of said survey map.

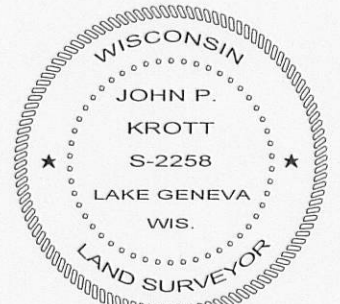

DATED THIS 16th DAY OF JUNE 2010.

John P. Krott

JOHN KROTT S - 2258
Wisconsin Registered Land Surveyor
(original if signed in red)

LEGEND

- FOUND IRON PIPE
- ⊞ ELECTRICAL TRANSFORMER
- ⊙ CABLE PEDESTAL
- ⊙ TELEPHONE PEDESTAL

(XX) RECORDED AS
TAX ID # SCDB1300590
JOB # 10-097

005 - 2759