


TOPOGRAPHICAL MAPPING
BEING PART OF THE HARVARD GENEVA LAKE CLUB
776 SOUTH LAKE SHORE DRIVE, FONTANA
LOCATED IN PART OF THE SE 1/4 OF THE NW 1/4 OF SECTION 13,
TOWN 1 NORTH, RANGE 16 EAST, WALWORTH COUNTY, WISCONSIN

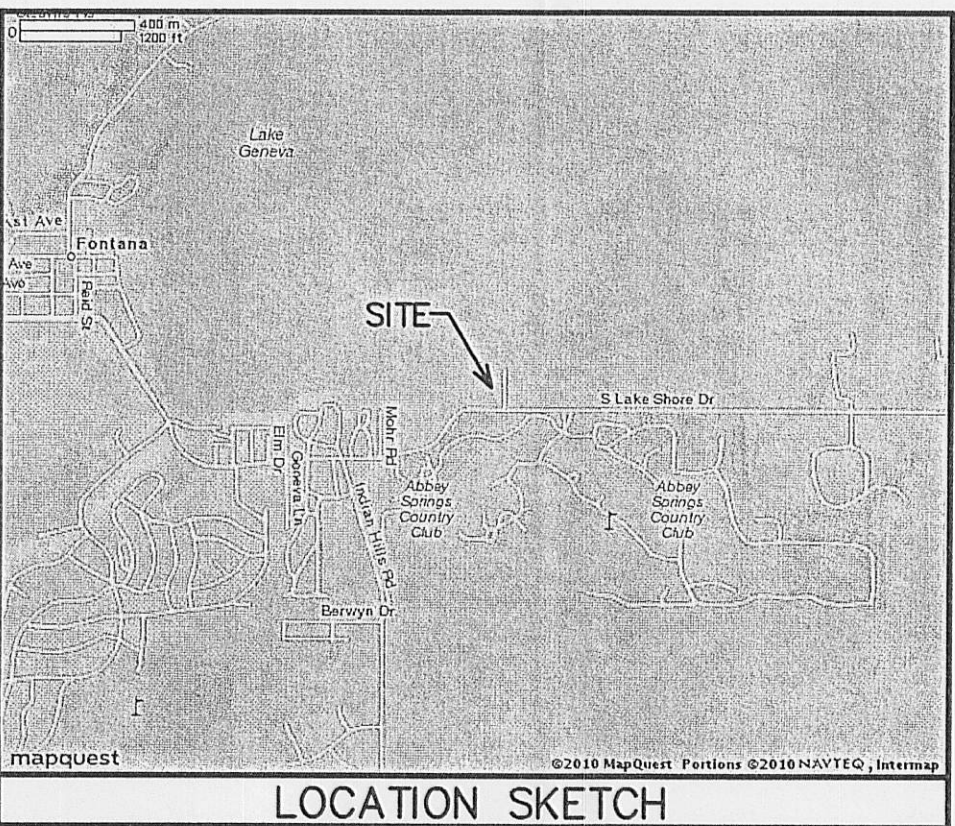

ROBERT GARDNERS SUBDIVISION
(HARVARD GENEVA LAKE CLUB)
TAX PARCEL SGE 00001



NOTE:
MULTIPLE OVERHEAD WIRES
CROSS EAST TO WEST
THROUGH TREES TO SERVE
RESIDENCES, AND LIGHT POLES

NOTE: COPIES OF THIS MAP TO WHICH THE FOLLOWING CERTIFICATE WILL APPLY SHOW SURVEYOR'S ORIGINAL SEAL AND SIGNATURE IN RED INK. COPIES BY ANY OTHER MEANS MAY HAVE ALTERATIONS WHICH DO NOT REPRESENT THE SURVEYOR'S WORK PRODUCT.

I HEREBY CERTIFY THAT THIS MAP IS A TRUE AND ACCURATE REPRESENTATION OF THE LOCATION OF THE THREE RESIDENCES SHOWN IN RELATION TO THE EAST LINE OF HARVARD CLUB, AS SHOWN AND THE TOPOGRAPHIC FEATURES ARE CORRECT TO THE BEST OF MY PROFESSIONAL KNOWLEDGE AND BELIEF. NOTE THIS IS NOT A PLAT OF SURVEY AS DEFINED IN CHAPTER A-E 7 OF WISCONSIN ADMINISTRATIVE CODE

DATED: SEPT. 22, 2010

PETER S. GORDON RLS 2101

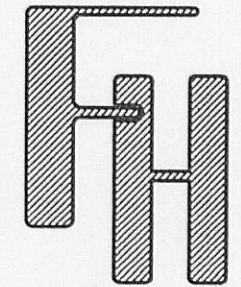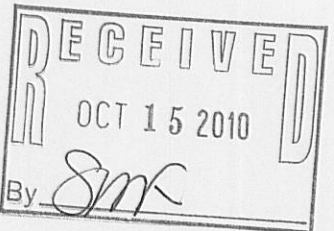

WORK ORDERED BY -
KEVIN & CARROLL HENNING
1130 BRIARWOOD
NORTH BROOK, WISCONSIN 60062

FARRIS, HANSEN & ASSOCIATES, INC.
ENGINEERING - ARCHITECTURE - SURVEYING
7 RIDGWAY COURT P.O. BOX 437
ELKHORN, WISCONSIN 53121
OFFICE: (262) 723-2098 FAX: (262) 723-5886

REVISIONS

PROJECT NO.
8233

DATE
9/21/2010

SHEET NO.
1 OF 1

005-2793