

PREPARED FOR
FRED GELDERMANN
REMAX GENEVA REALTY
101 BRAOD ST.
SUITE 102
LAKE GENEVA WI 53147



PLAT OF SURVEY

-OF-

KROTT SURVEYING INC.


N3705 WILLOW BEND LANE
LAKE GENEVA WI. 53147
PHONE # (262)248-3697
FAX # (262)249-0639

LOTS 22 AND 23, BLOCK 6 INDIAN HILLS SUBDIVISION BEING
LOCATED IN SECTION 14 TOWN 1 NORTH, RANGE 16 EAST, VILLAGE
OF FONTANA-ON- GENEVA LAKE, WALWORTH COUNTY,
WISCONSIN.

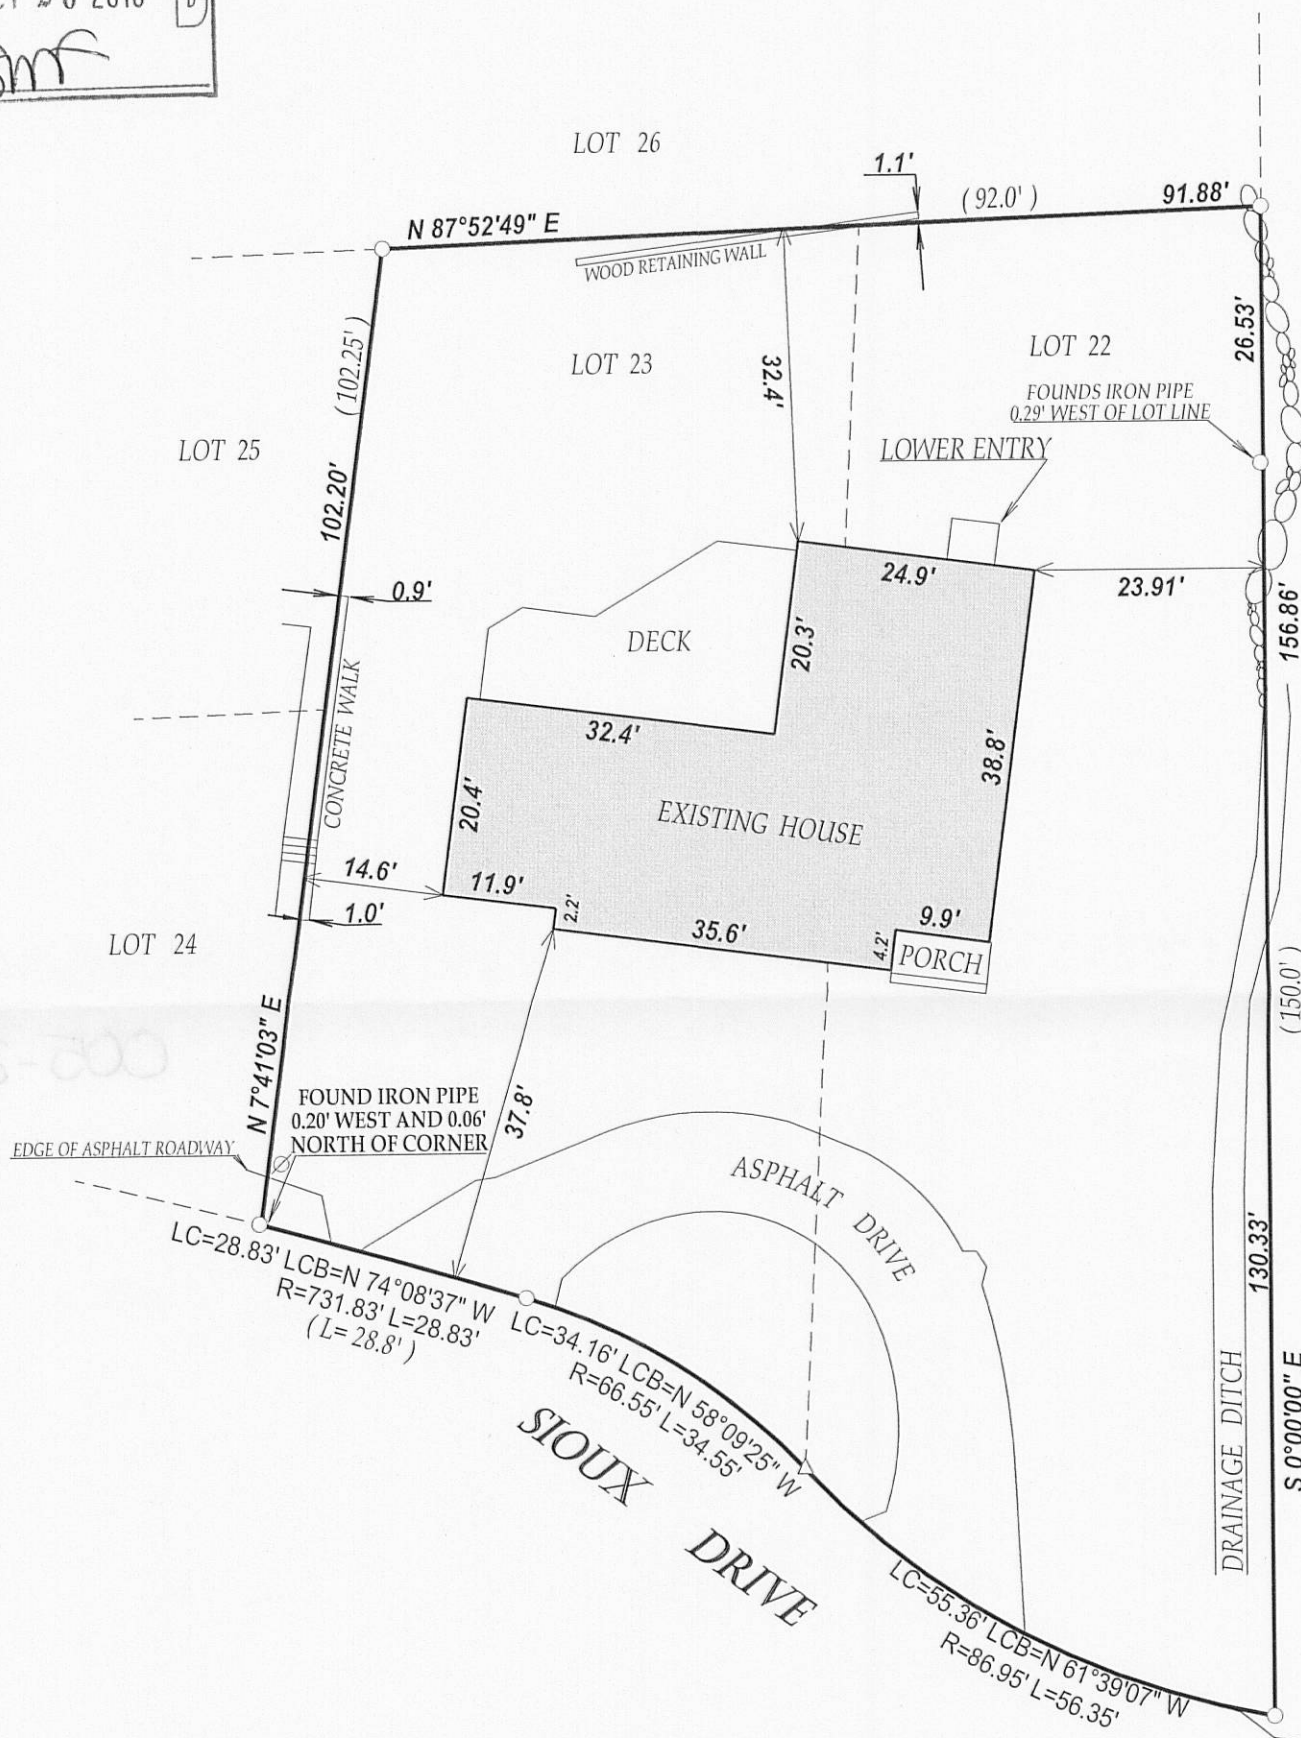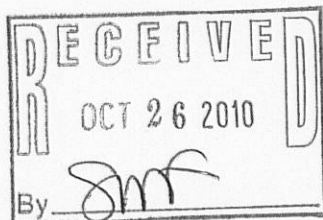

LEGEND
○ FOUND IRON PIPE
△ FOUND P.K. NAIL
Ø UTILITY POLE
(xx) RECORDED AS
TAX ID # SIHB00015
JOB # 10-150


SCALE 1" = 20'

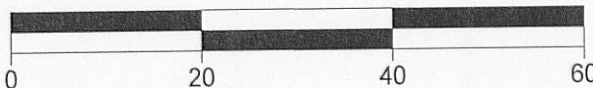

I have surveyed the above-described property and the above map is a true representation thereof and shows the size and location of the property, its exterior boundaries, the location and dimensions of all structures thereon, fences apparent easements and roadways and visible encroachments, if any.

This survey is made for the exclusive use of the present owners of the property, and also those who purchase, mortgage, or insure the title thereto within one (1) year from date hereof; and as to them I warrant the accuracy of said survey map.

NOTE: THE EAST LINE OF LOT 22
WAS ASSUMED TO BEAR SOUTH.

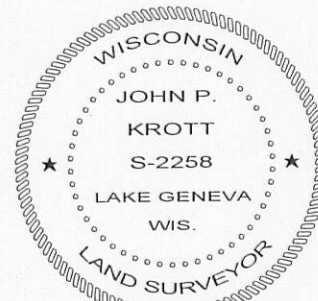

DATED THIS 14th DAY OF SEPTEMBER 2010.

John P. Krott
JOHN KROTT S - 2258
Wisconsin Registered Land Surveyor
(original if signed in red)