

ROBERS & BOYD, INC.
CONSULTING ENGINEERS & LAND SURVEYORS


PHONE (414) 763-2652

116 E. CHESTNUT ST.

BURLINGTON, WIS. 53105

PLAT OF SURVEY & HOUSE LOCATION
OF

THE WEST 1/2 OF LOT 84 OF
BURLINGTON PARK SUBDIVISION, VILLAGE OF
BURLINGTON - GENERAL LAKE, WAUWATOSH
COUNTY, WISCONSIN

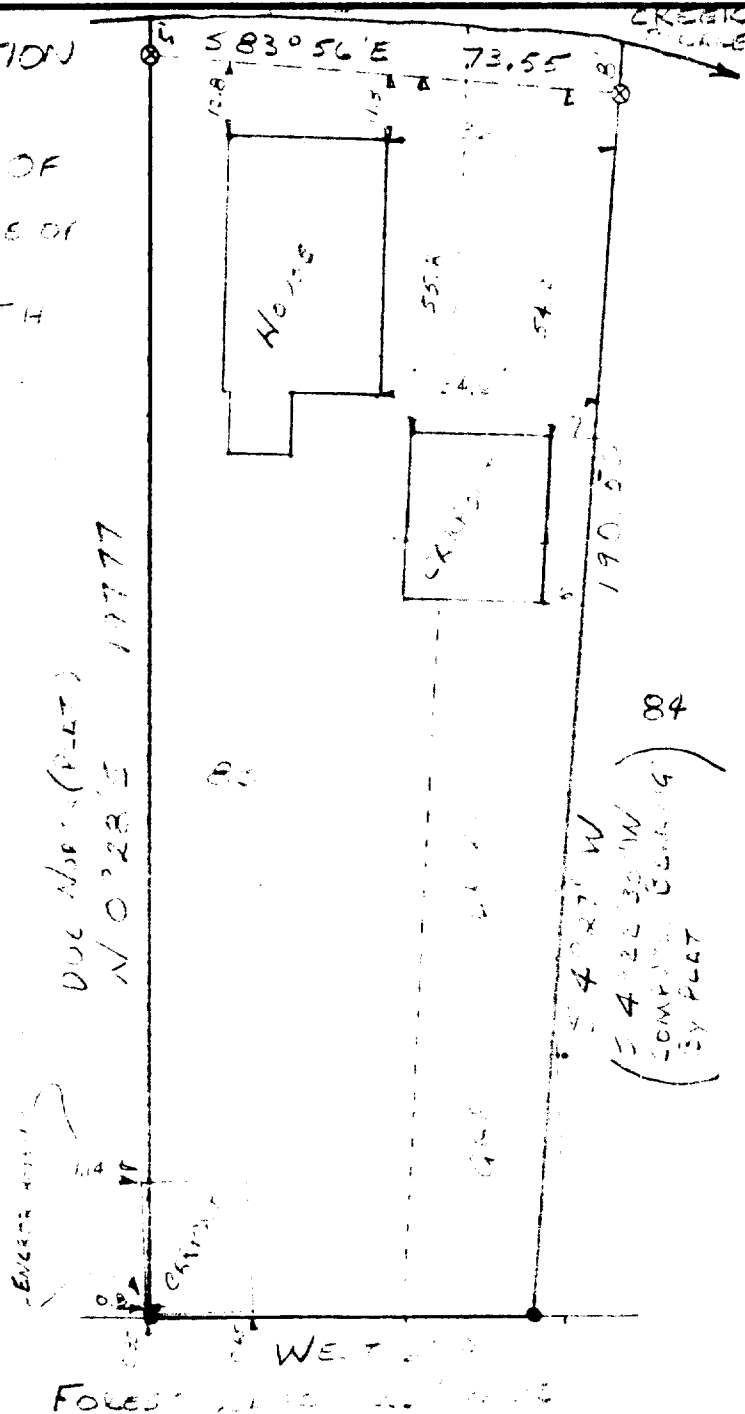

- LEGEND -

- SET POINT
 - ⊗ CORNER POINT
- SCALE 1"=50'

I HEREBY CERTIFY THAT WE HAVE SURVEYED THE LANDS DESCRIBED
ABOVE ACCORDING TO OFFICIAL RECORDS AND THAT THE PLAT
DRAWN HEREON IS A CORRECT REPRESENTATION OF SAID SURVEY.

WIS. REG. LAND SURVEYOR

DATE

5-27-73

JOB NO.

73048