

BOUNDARY SURVEY



UNIT 51 OF
ABBEY SPRINGS CONDOMINIUM
LOCATED IN THE S 1/2 OF SECTION 13,
TOWN 1 NORTH, RANGE 16 EAST
WALWORTH COUNTY, WISCONSIN

ORDERED BY:
MICHAEL RAYMOND CUSTOM HOMES
200 W. MAIS ST. SUITE E
ST CHARLES, IL. 60174



FARRIS, HANSEN & ASSOCIATES, INC.
ENGINEERING - ARCHITECTURE - SURVEYING
7 RIDGWAY COURT P.O. BOX 437
ELKHORN, WISCONSIN 53121
OFFICE: (262) 723-2098 FAX: (262) 723-5866

REVISIONS

PROJECT NO.
7829
DATE:
02-09-2009
SHEET NO.
1 OF 1

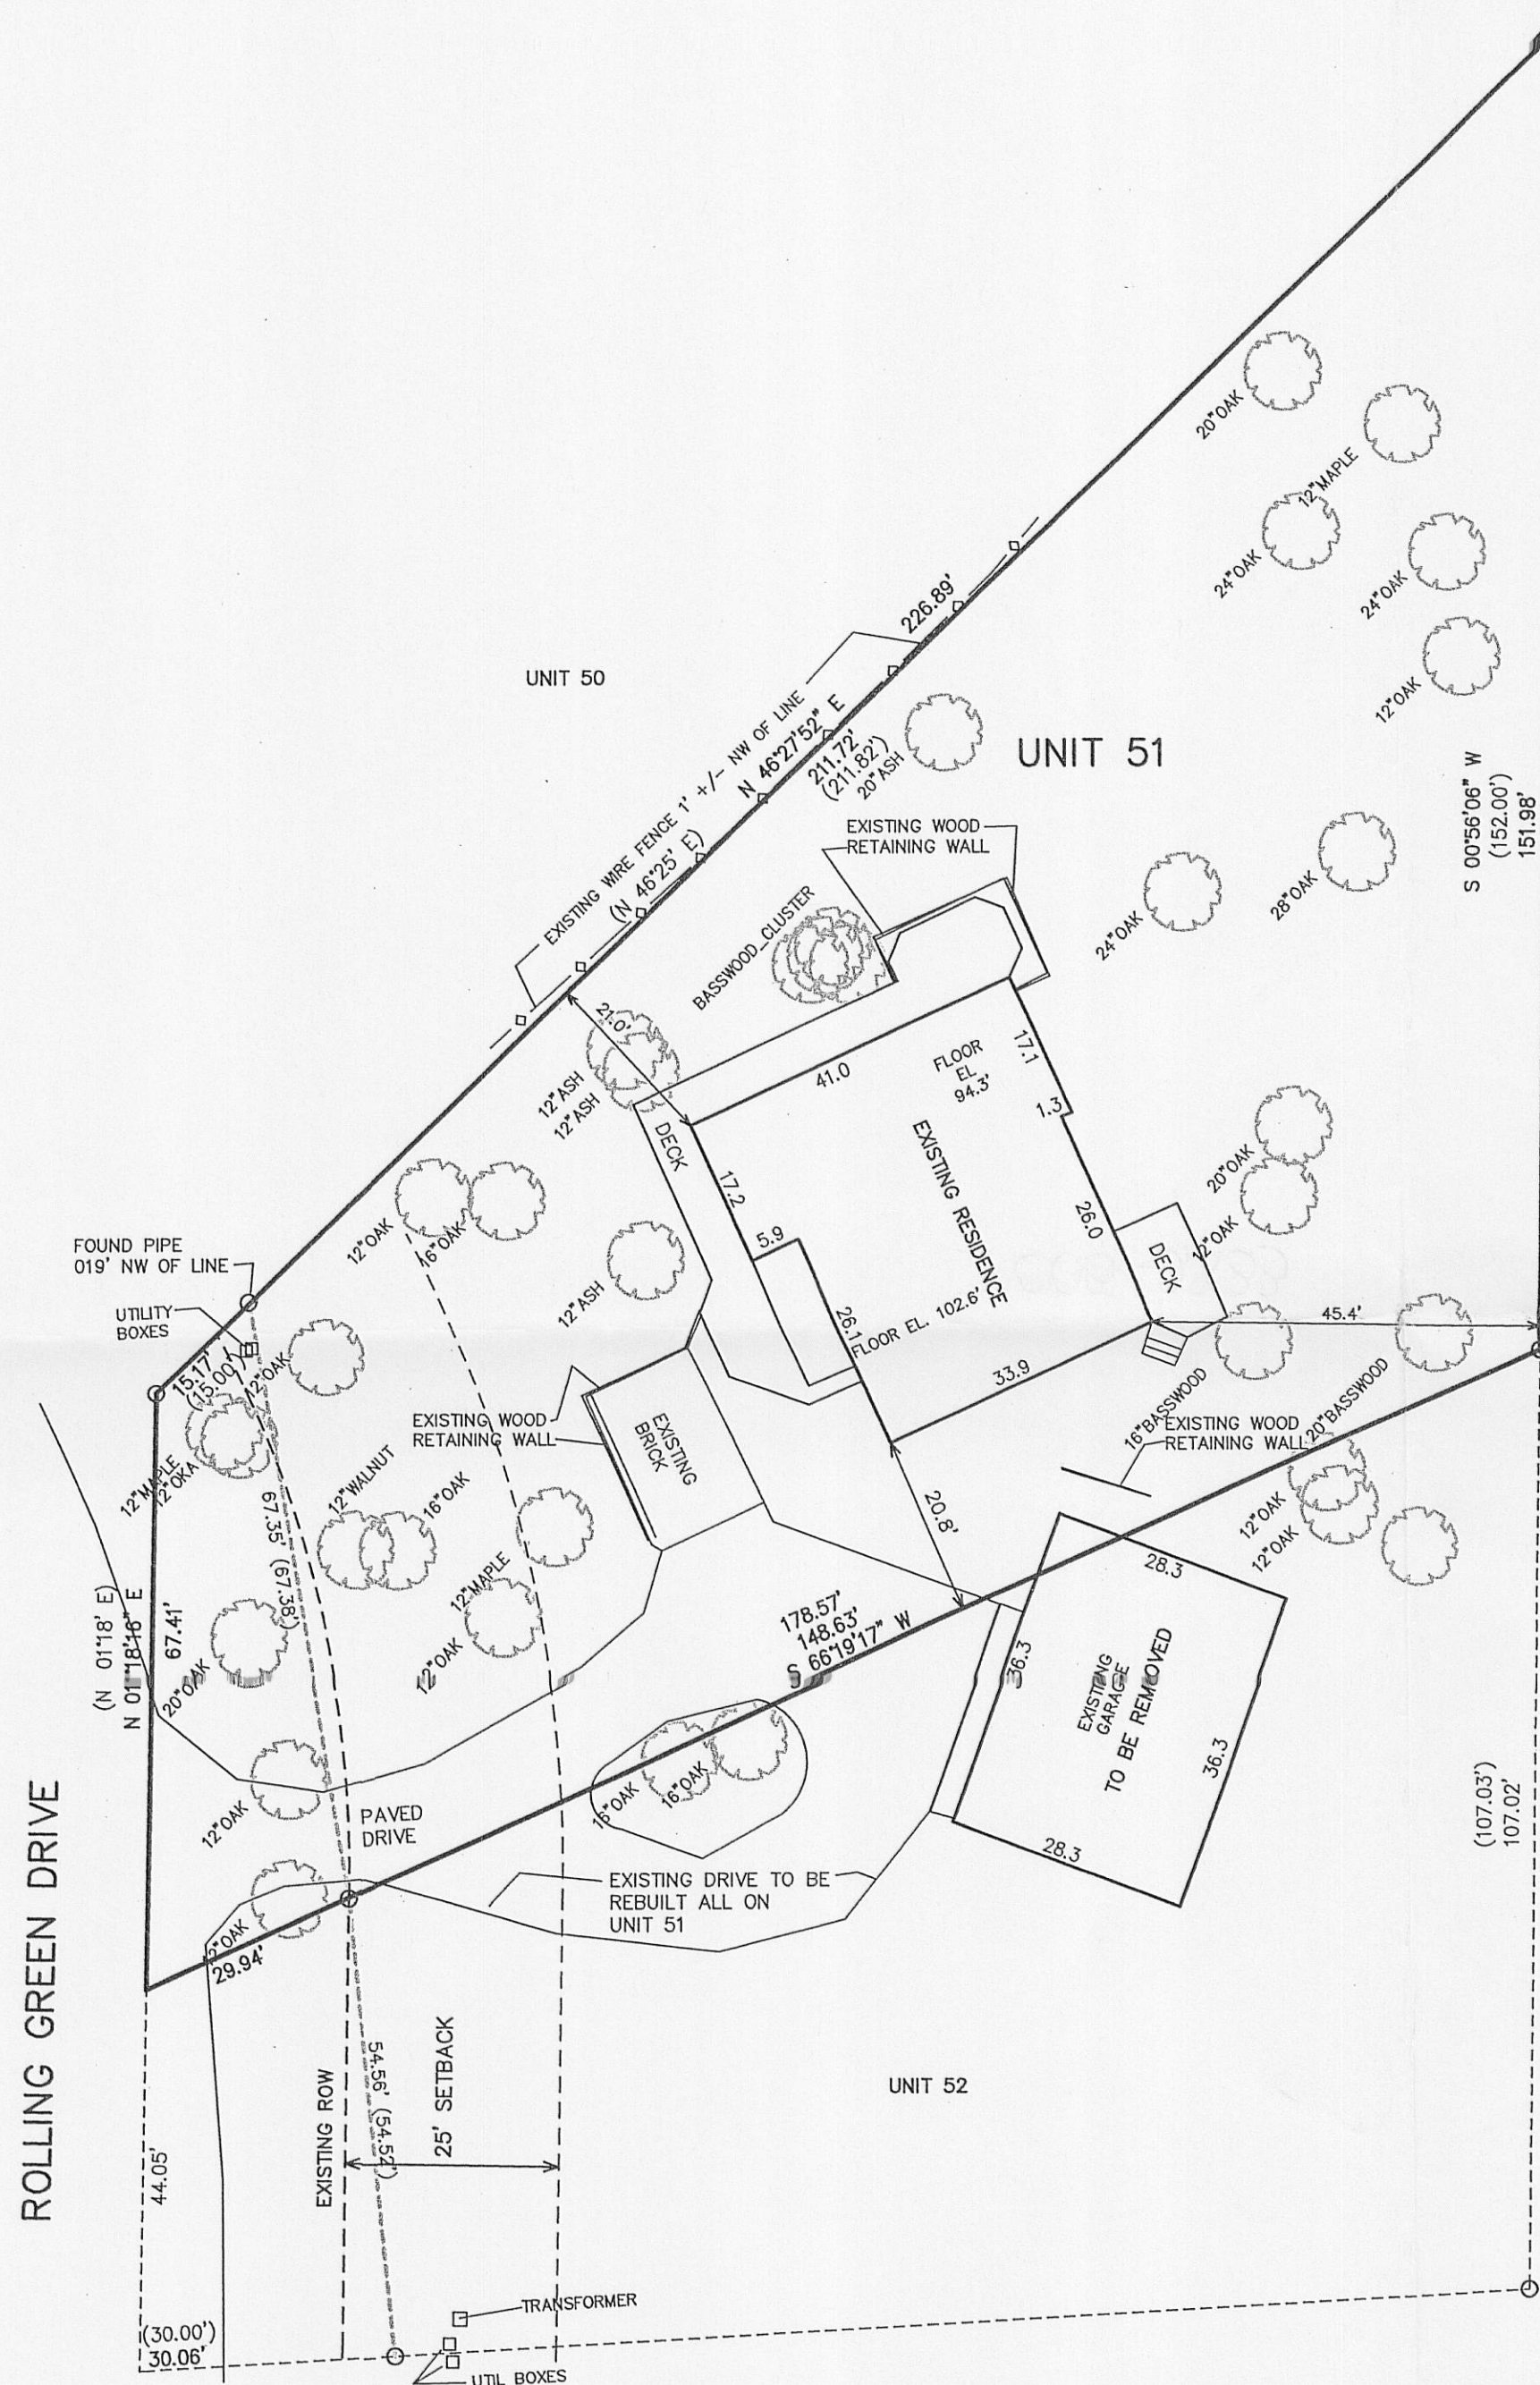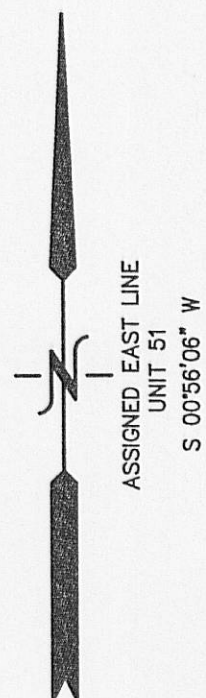

LEGEND
O = FOUND IRON PIPE STAKE
(XXX) = RECORDED AS
AREA = 17,760 S.F. 0.41 ACRES

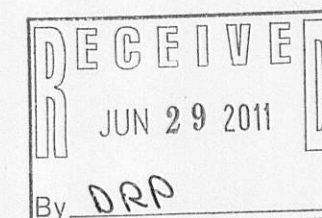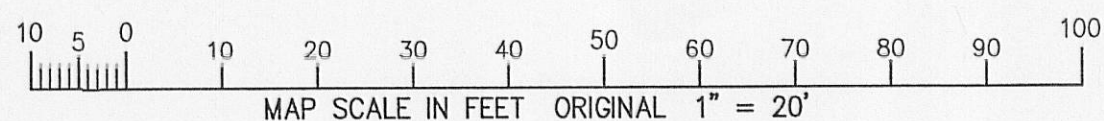


NOTE: COPIES OF THIS MAP TO WHICH THE FOLLOWING CERTIFICATE WILL APPLY SHOW SURVEYOR'S ORIGINAL SEAL AND SIGNATURE IN RED INK. COPIES BY ANY OTHER MEANS MAY HAVE ALTERATIONS WHICH DO NOT REPRESENT THE SURVEYOR'S WORK PRODUCT.

I HEREBY CERTIFY THAT THE ABOVE DESCRIBED PROPERTY HAS BEEN SURVEYED UNDER MY DIRECTION AND THAT THE ABOVE MAP IS A TRUE REPRESENTATION THEREOF AND SHOWS THE SIZE AND LOCATION OF THE PROPERTY AND ITS EXTERIOR BOUNDARIES. THIS SURVEY IS MADE FOR THE USE OF THE PRESENT OWNERS OF THE PROPERTY, AND ALSO THOSE WHO PURCHASE, MORTGAGE, OR GUARANTEE THE TITLE THERETO WITHIN ONE YEAR FROM THE DATE HEREOF.

DATED: APRIL 27, 2011

Peter S. Gordon
PETER S. GORDON R.L.S. 2101

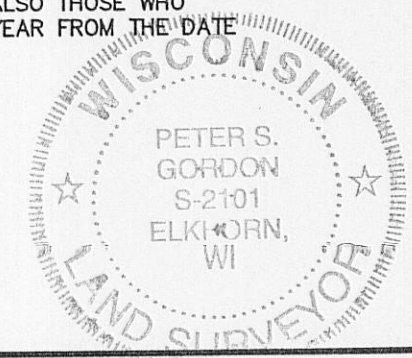

005-2833