



FARRIS, HANSEN & ASSOCIATES, INC.

ENGINEERING - ARCHITECTURE - SURVEYING
7 RIDGWAY COURT - P.O. BOX 437 - ELKHORN, WISCONSIN 53121
PHONE: (262) 723-2098 FAX: (262) 723-5886

- WORK ORDERED BY -
CLAIR LAW OFFICE
617 E. WALWORTH AVE
DELAVAN, WI. 53115


PLAT OF SURVEY

Lot 43, Unit 2, Country Club Estates, Village of Fontana on Geneva Lake, Walworth County, Wisconsin.
Tax Key No: SC0200041

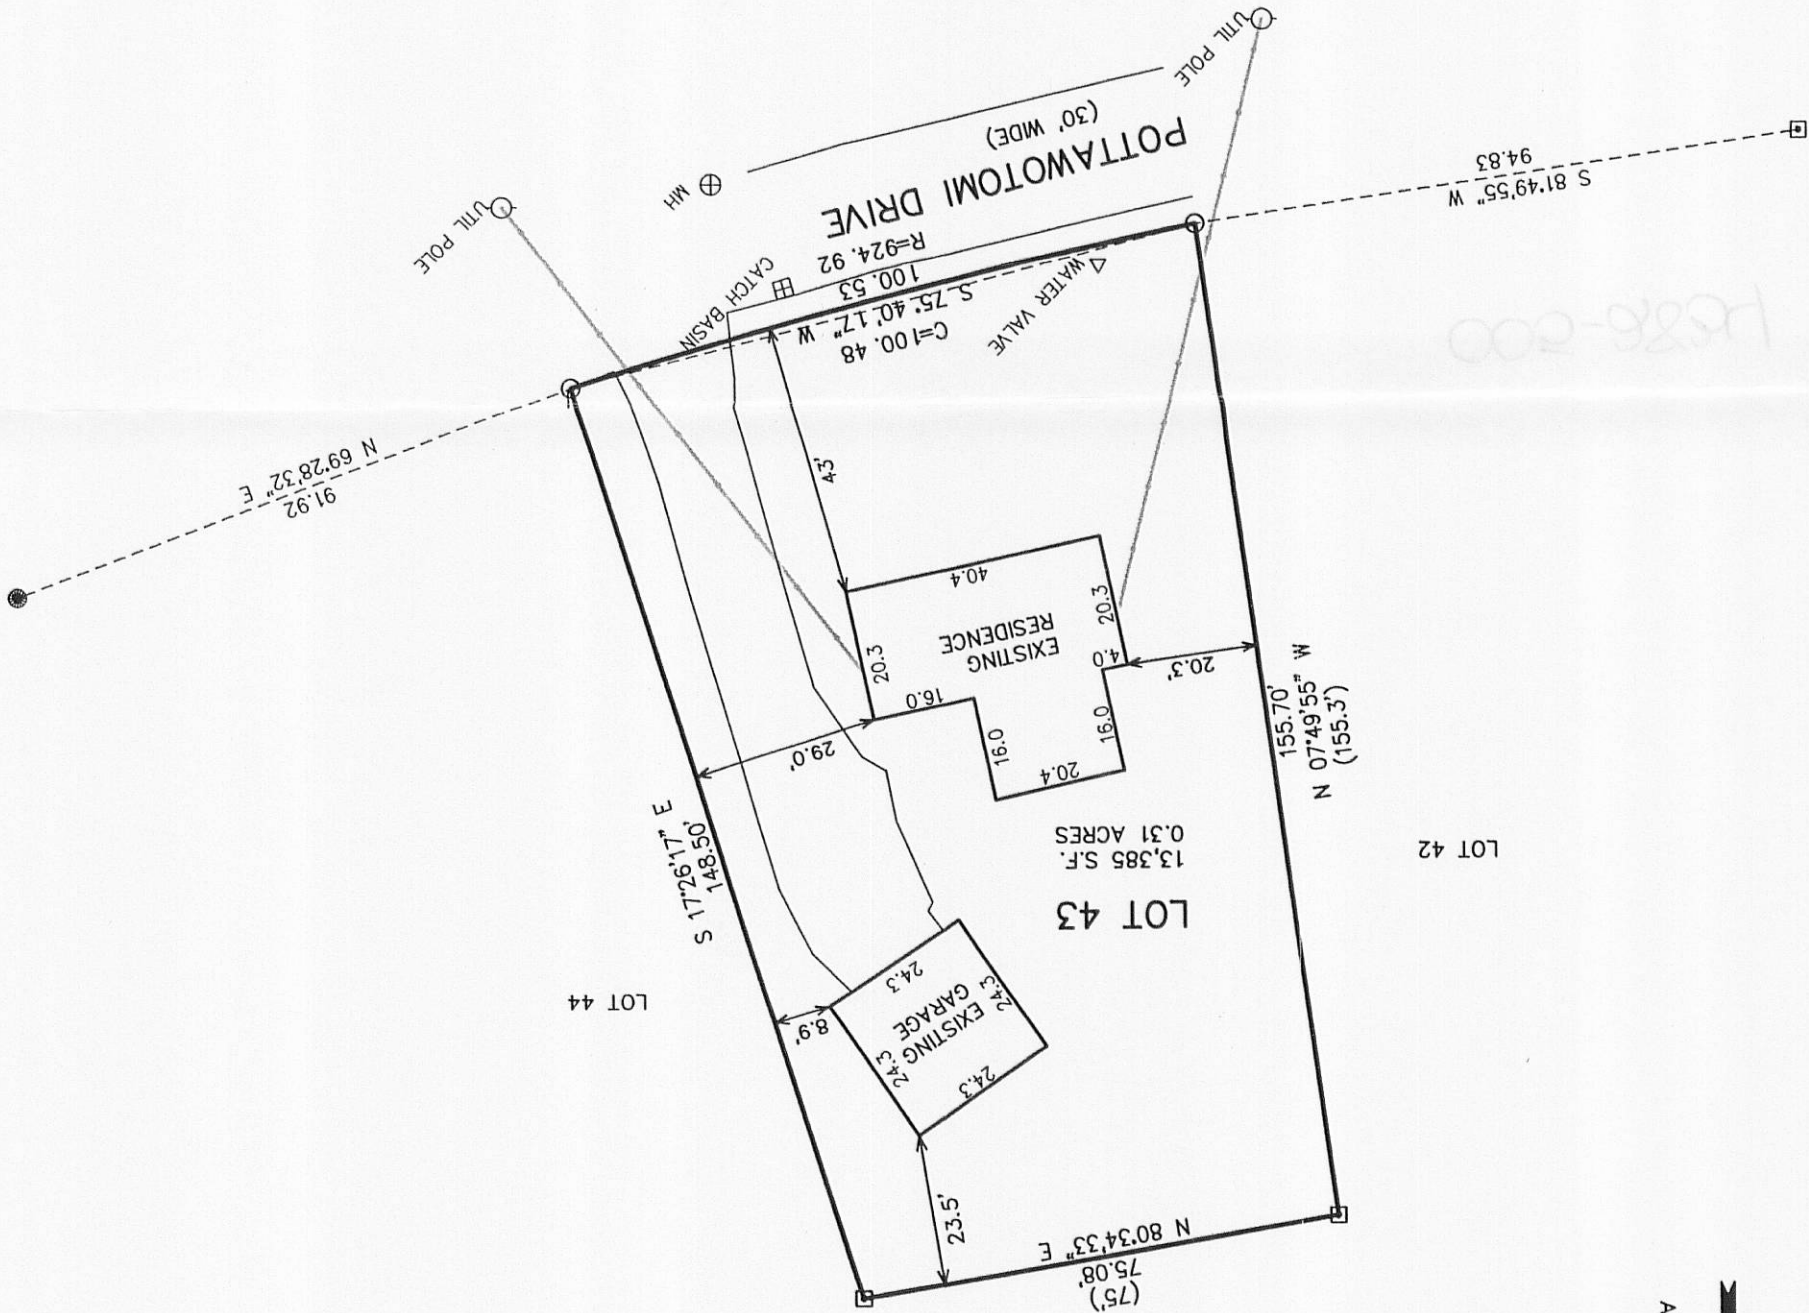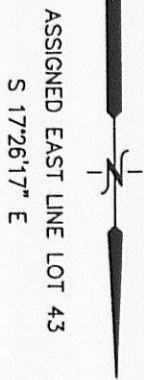

LEGEND

- = SET IRON PIPE STAKE
 - = FOUND IRON REBAR STAKE
 - = FOUND CONCRETE MONUMENT W/ IRON PIPE
 - (XXX) = RECORDED AS
- EASEMENT TO W. SOUTHERN GAS REC. IN VOL. 210, PG 52
ALLOWS FOR GAS LINES TO BE INSTALLED AND MAINTAINED
WITHIN DRIVEWAYS.

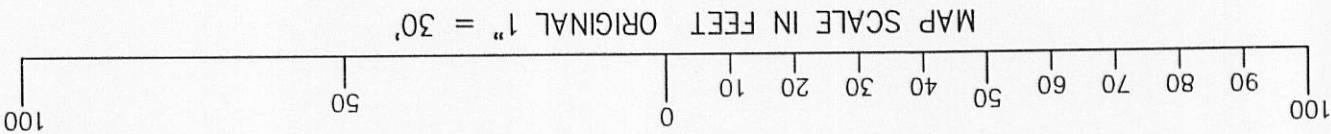


NOTE: COPIES OF THIS MAP TO WHICH THE FOLLOWING CERTIFICATE WILL APPLY SHOW SURVEYOR'S ORIGINAL SEAL AND SIGNATURE IN RED INK. COPIES BY ANY OTHER MEANS MAY HAVE ALTERATIONS WHICH DO NOT REPRESENT THE SURVEYOR'S WORK PRODUCT.

I HEREBY CERTIFY THAT THE ABOVE DESCRIBED PROPERTY HAS BEEN SURVEYED UNDER MY DIRECTION AND THAT THE ABOVE MAP IS A TRUE REPRESENTATION THEREOF AND SHOWS THE SIZE AND LOCATION OF THE PROPERTY, ITS EXTERIOR BOUNDARIES, THE LOCATION OF ALL VISIBLE STRUCTURES, AND DIMENSIONS OF ALL PRINCIPLE BUILDINGS THEREON, BOUNDARY FENCES, APPARENT EASEMENTS, ROADWAYS, AND VISIBLE ENCROACHMENTS, IF ANY. THIS SURVEY IS MADE FOR THE USE OF THE PRESENT OWNERS OF THE PROPERTY, AND ALSO THOSE WHO PURCHASE, MORTGAGE, OR GUARANTEE THE TITLE THERETO WITHIN ONE YEAR FROM THE DATE HEREOF.

DATED: JUNE 9, 2011

PETER S. GORDON R.L.S. 2101

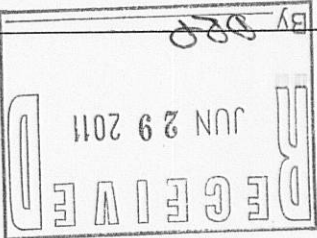

PROJECT: 8374
DATE: 06-09-2011
SHEET 1 OF 1

005-2834

JUN 09 2011 SC02-41