


Plat of Survey

of


Lot 26 of the subdivision of Block 6 of Indian Hills,

located in the Southeast 1/4 of Section 14, Town 1 North, Range 16 East,
Village of Fontana-on-Geneva Lake, Walworth County, Wisconsin.

Surveyed for: **Tom & Laura Day**
442 Harvard Avenue
Fontana, Wisconsin. 53125

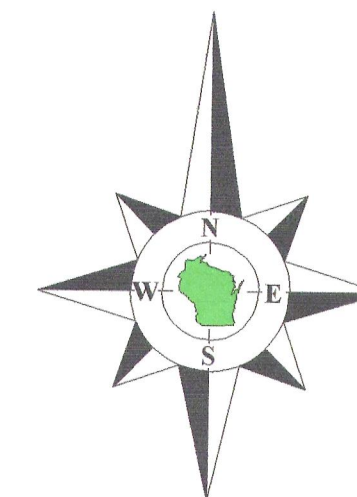


Bearings reference to the North line of Lot 27, recorded as N87°30'E on previous surveys of record.

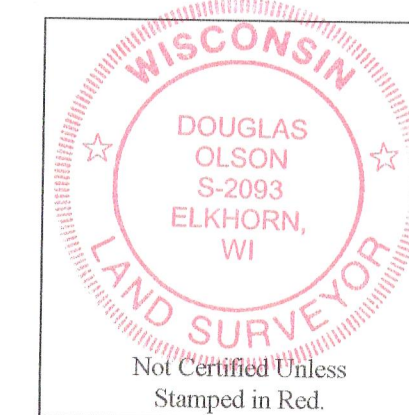

Notes:

- 1) This survey plat is not certified unless signed and sealed in red ink.
- 2) This survey is subject to Wisconsin lien laws. This Plat of Survey is the notice of intent to file lien. Lien waiver required.

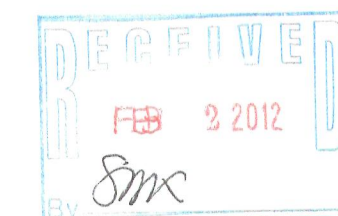

Copyright 2010 by Jensen & Olson Land Surveying, LLC.

All rights reserved. No part of this survey plat may be reproduced or transmitted in any form by any means - graphic, electronic, or mechanical, including photocopying, tracing, or information storage and retrieval systems - without permission in writing from Douglas G. Olson, Jensen & Olson Land Surveying, LLC.

I hereby certify that I have surveyed the above described property and the map hereon is correct to the best of my professional knowledge and belief and shows the size and location of the property, its exterior boundaries, the location and dimensions of all visible structures thereon, boundary fences, apparent easements and roadways and visible encroachments, if any.

This survey is made for the exclusive use of the present owners of the property, and also those who purchase, mortgage or guarantee title thereto, within one year from the date hereof.

Douglas G. Olson
Wisconsin Registered Land Surveyor - 2093

Survey Date: May 18, 2010.

Revisions: No. 1 - Proposed house, entry porch, deck & stairs
No. 2 - Concrete Foundation

Scale in Feet
1" = 20'



Jensen & Olson Land Surveying, LLC
45 South Wisconsin Street * P.O. Box 322 * Elkhorn, Wisconsin. 53121
Telephone: (262) 723-3434 * Facsimile: (262) 723-8044
Email: jensen.olson@elknet.net



Legend
☐ Found Iron Pipe
☐ Found Iron Rod
☐ Found Road Spike
☐ Set Iron Rod
☐ Recorded Information
☐ Manhole
☐ Utility Pole
☐ Easement
☐ Asphalt Surface
☐ Control Box
☐ PVC Pipe

Sheet 1 of 1 Sheets
Drawing Name: (I:\r16c-2011\064-2011\064.dwg)

Job Reference Number
2011.064

2011.064

SIHB-18

005-2883