


Lot 14
Unit 1, Country
Club Estates

Cutlot 31

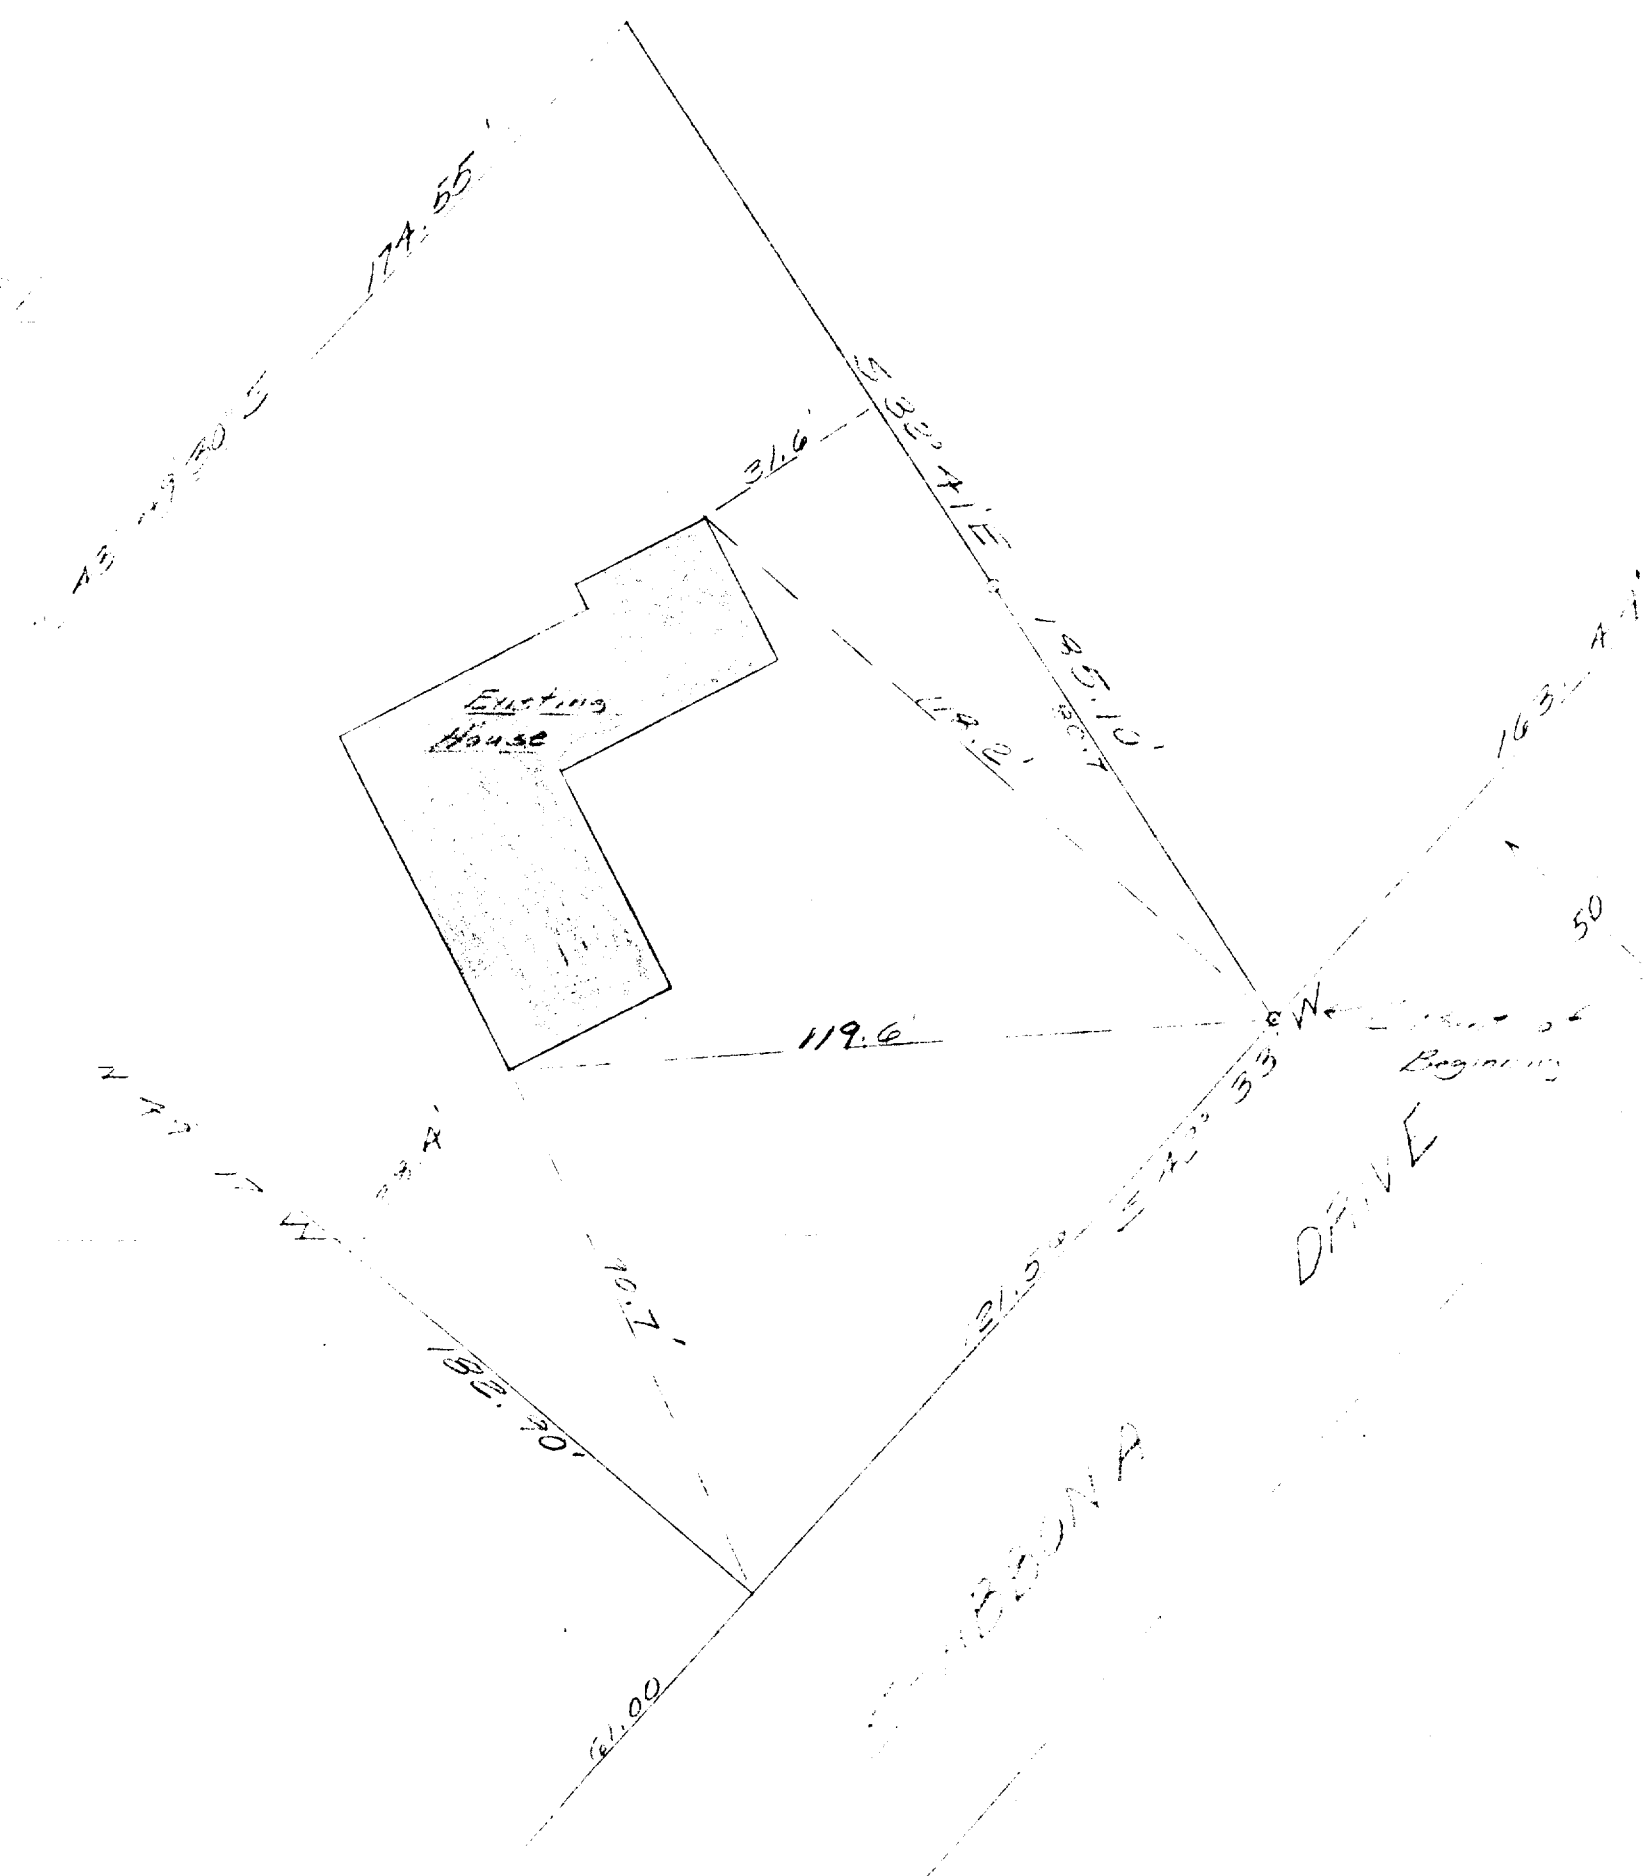

DESCRIPTION OF LAND SHOWN ON THIS PLAT

All that part of the south-east 1/4 of Section 14 also located in Cutlot 31 of the Assessor's Plat of the Village of Fontana-en-Renev, Lake, Township 1 North, Range 16 East, bounded and described as follows:

Commencing at the south-east corner of Lot 14, Unit 1 of the Country Club Estates Subdivision and run thence South $42^{\circ}33'$ West along the northerly right of way line of Shasbona Drive, 163.44 feet to the point of beginning of the parcel of land hereinafter described; thence continue South $42^{\circ}33'$ West along said right of way line, 121.56 feet; thence North $49^{\circ}17'$ West, 182.90 feet; thence North $45^{\circ}49'30''$ East, 174.55 feet; thence South $32^{\circ}41'$ East, 185.10 feet to the point of beginning.

**PLAT OF SURVEY
OF**

Part of the South-east 1/4 of Section 14, Township 1 North, Range 16 East, also located in Cutlot 31 of the Assessor's Plat of the Village of Fontana-en-Renev, Lake, Township 1 North, Range 16 East, Walworth County, Wisconsin.

Lloyd Jensen
SURVEYOR

SCALE 1" = 30'

DATE 16 Feb. 1973