

FARRIS, HANSEN & ASSOC. INC.



7 RIDGWAY COURT- P.O. BOX 437
ELKHORN, WISCONSIN 53121
PHONE (262) 723-2098
FAX (262) 723-5886

ORDERED BY: KIRK CHRISTENSEN
388 HILLCREST DRIVE
FONTANA, WI. 53125

STAKING REPORT
LOT 19 COUNTRY CLUB ESTATES BLOCK A UNIT 3
LOCATED IN THE SW 1/4 SEC. 14, T1N, R16E
VILLAGE OF FONTANA-ON-GENEVA LAKE
WALWORTH COUNTY, WI.

LEGEND

- O = FOUND IRON PIPE STAKE
- * = SET NAIL IN PAVEMENT
- (XXX) = RECORDED AS

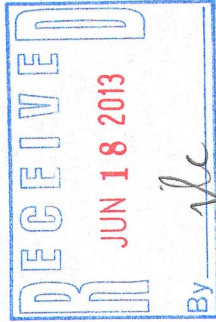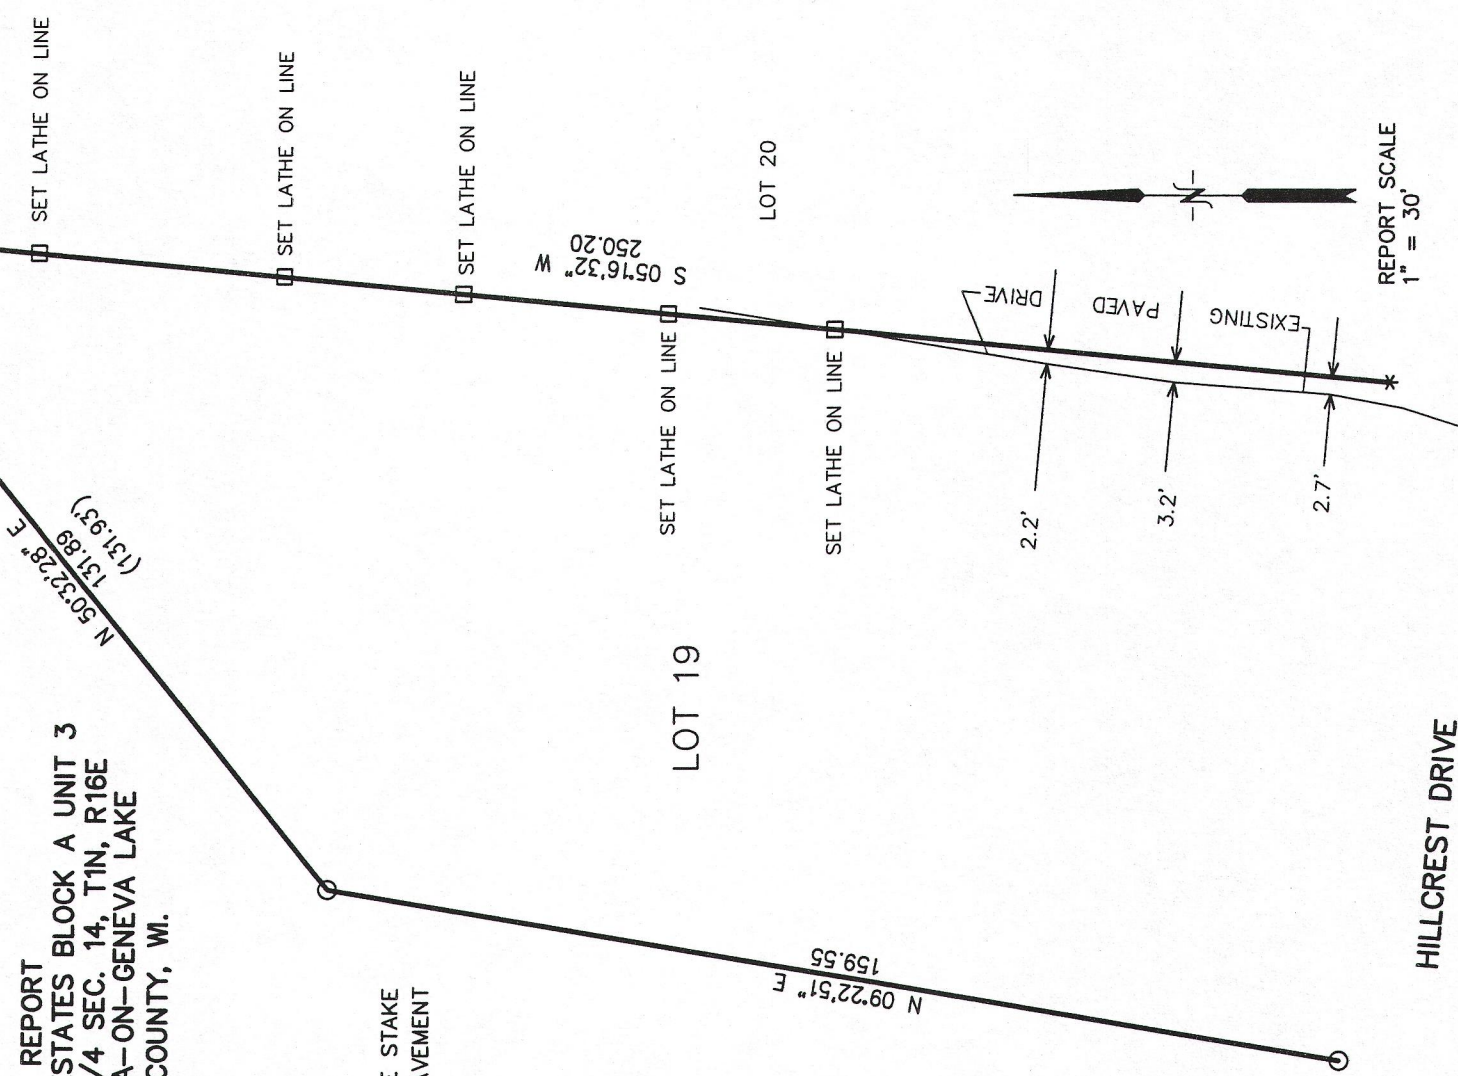

HILLCREST DRIVE

NOTE: COPIES OF THIS MAP TO WHICH THE FOLLOWING CERTIFICATE WILL APPLY SHOW THE SURVEYOR'S ORIGINAL SEAL AND SIGNATURE IN RED INK. COPIES BY ANY OTHER MEANS MAY HAVE ALTERATIONS WHICH DO NOT REPRESENT THE SURVEYOR'S WORK PRODUCT.

I HEREBY CERTIFY THAT THIS REPORT IS A TRUE AND ACCURATE REPRESENTATION OF THE LOCATION OF THE EAST PROPERTY LINE OF LOT 19 IN RELATION TO THE NORTHEAST, NORTHWEST, AND SOUTHWEST CORNERS FOUND AS SHOWN TO THE BEST OF MY PROFESSIONAL KNOWLEDGE AND BELIEF. NOTE: THIS IS NOT A SURVEY AS DEFINED IN CHAPTER A-E 7 OF WISCONSIN ADMINISTRATIVE CODE.

DATED: MAY 15, 2013

Peter S. Gordon
PETER S. GORDON RLS 2101



PROJECT NO. 8793
DATED: 05-15-2013
SHEET 1 OF 1 SHEETS

MAY 15 2013

SC03-19

005-2976