


PLAT OF SURVEY

PREPARED FOR
JASON BERNARD
201 BROAD ST
LAKE GENEVA WI. 53147


-OF-
LOT 83 AND THE WEST 1/2 OF LOT 84 BUENA VISTA SUBDIVISION LOCATED
IN THE VILLAGE OF FONTANA, COUNTY OF WALWORTH, STATE OF WISCONSIN

KROTT SURVEYING INC.
N3705 WILLOW BEND LANE
LAKE GENEVA WI. 53147
PHONE # (262)248-3697
FAX # (262)249-0639

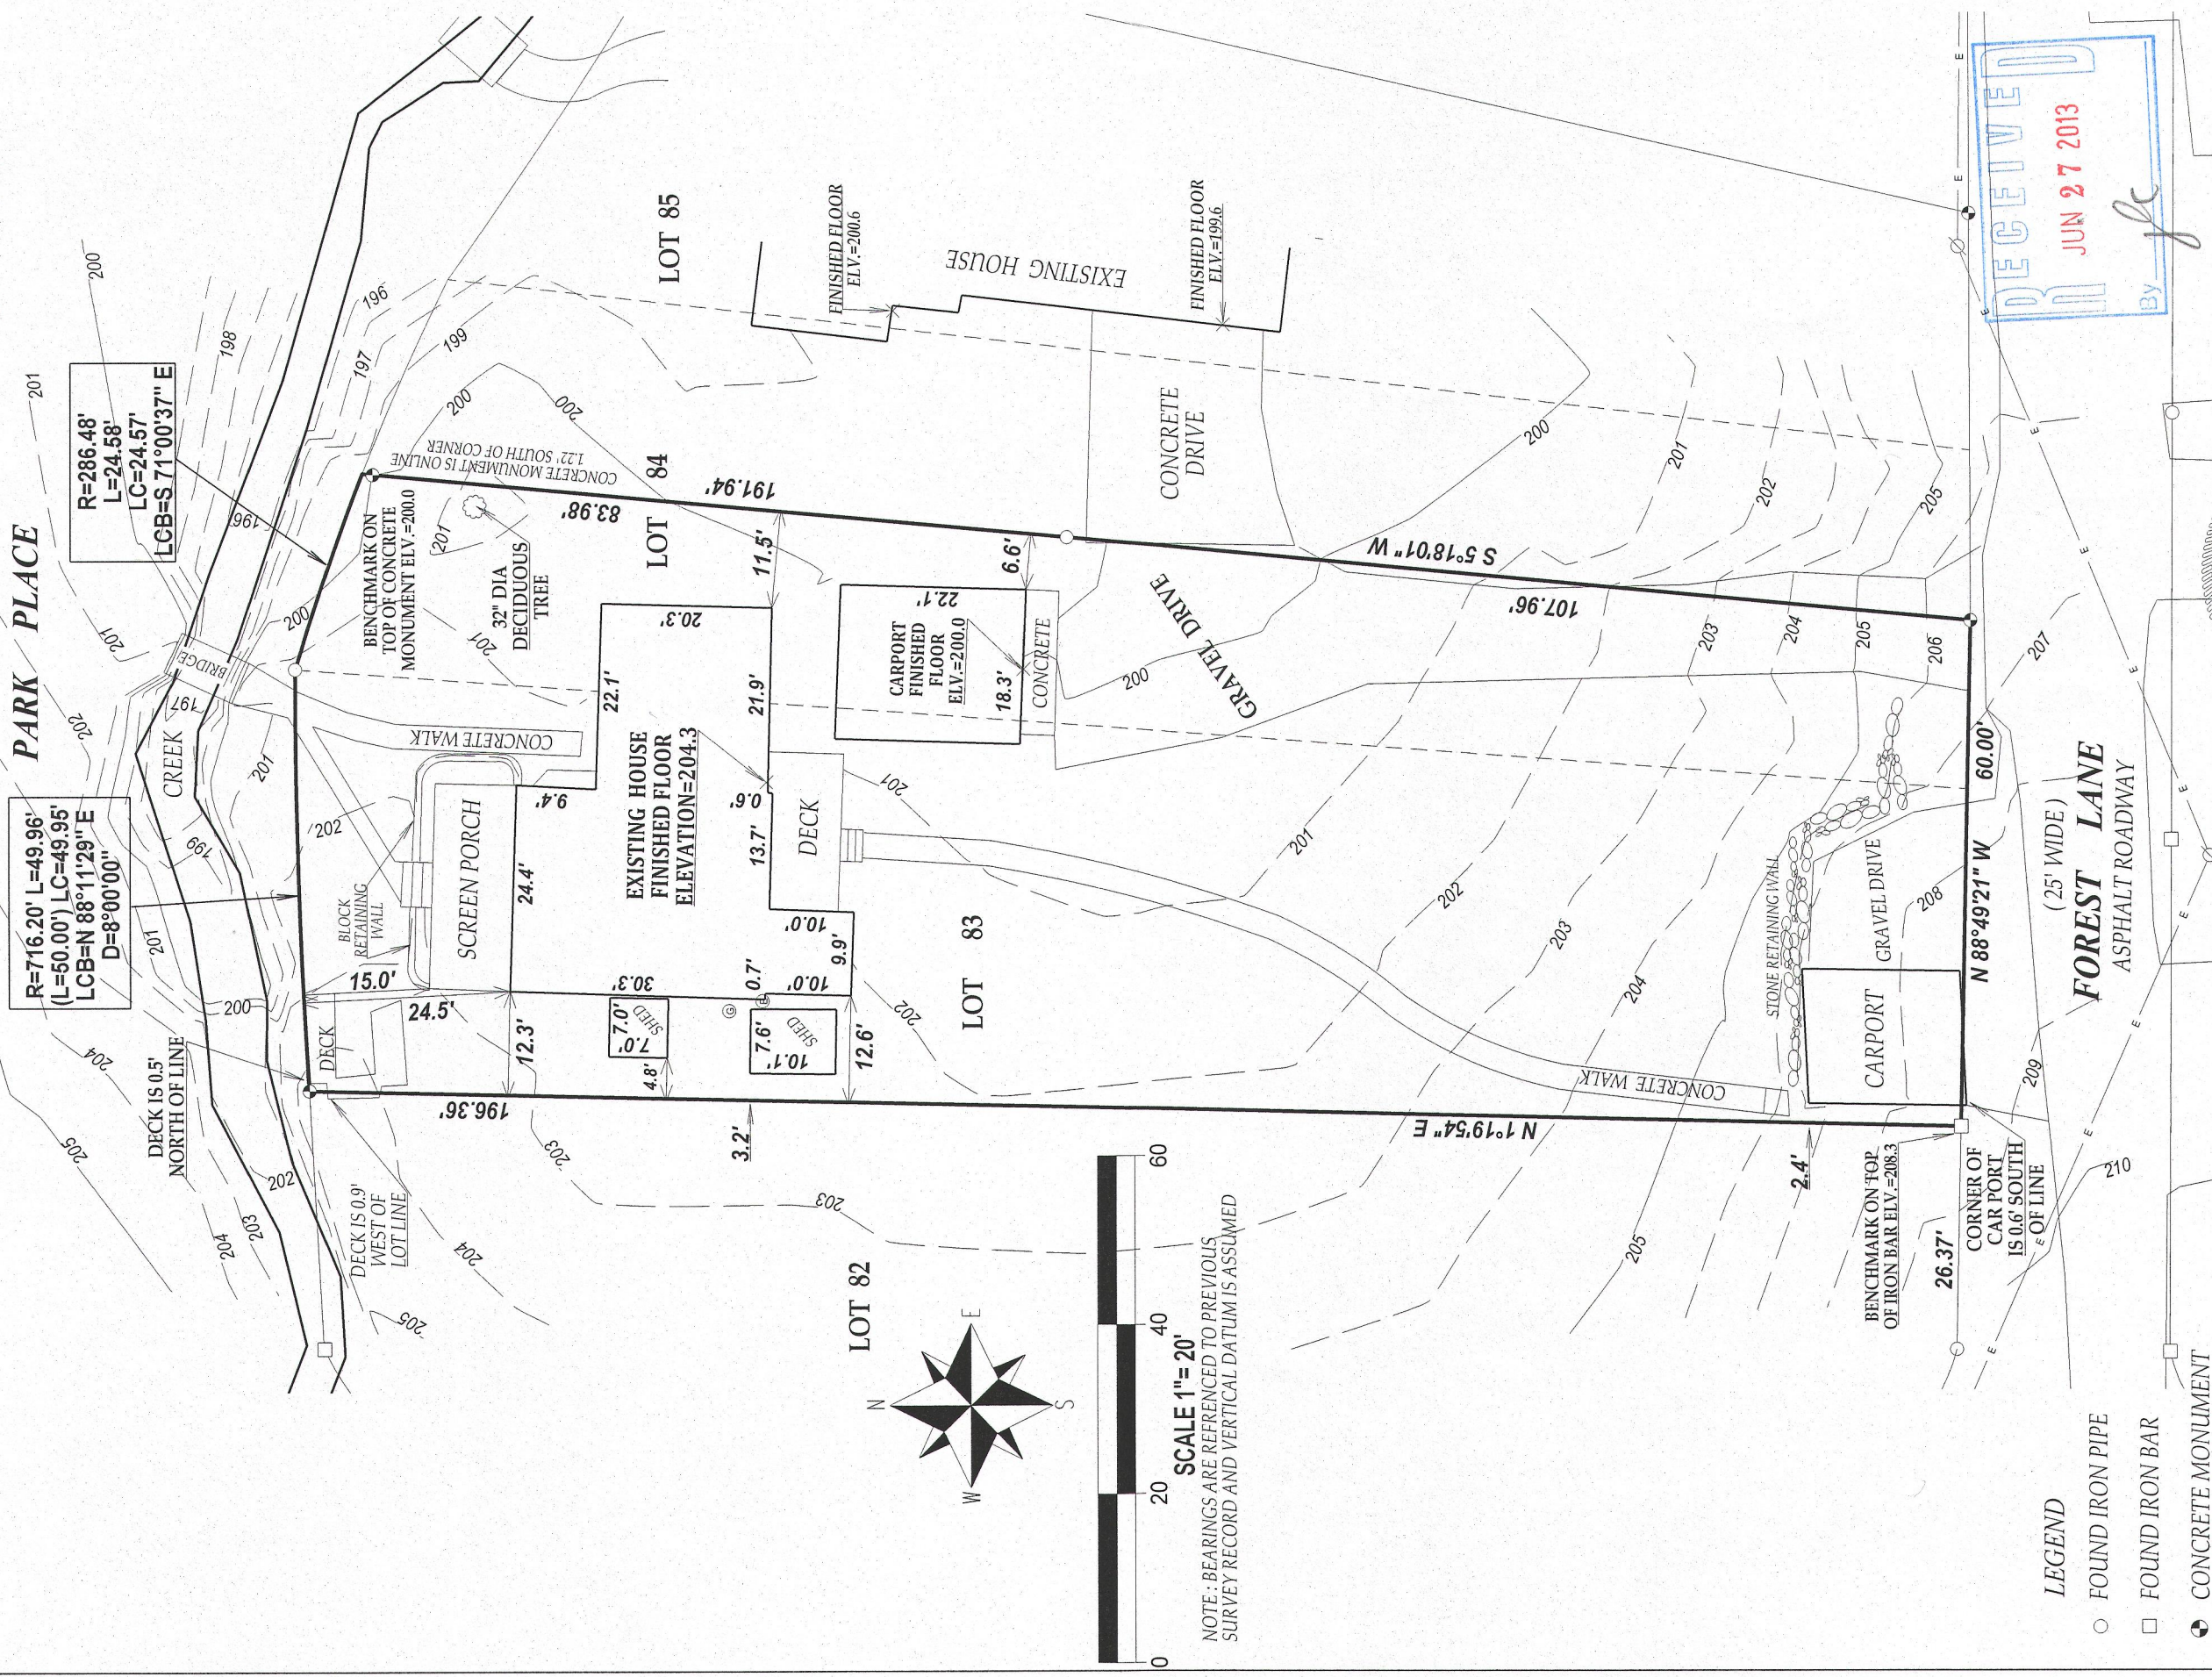

I have surveyed the above-described property and the above map is a true representation thereof and shows the size and location of the property, its exterior boundaries, the location and dimensions of all structures thereon, fences apparent easements and roadways and visible encroachments, if any.

This survey is made for the exclusive use of the present owners of the property, and also those who purchase, mortgage, or insure the title thereto within one (1) year from date hereof; and as to them I warrant the accuracy of said survey map.

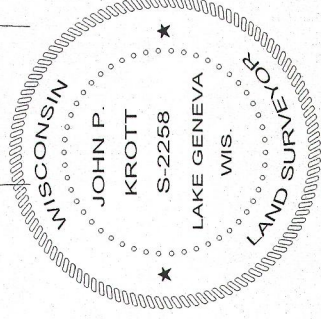

DATED THIS 21st DAY OF JUNE 2013

JOHN KROTT S - 2258
Wisconsin Registered Land Surveyor
(original if signed in red)

8BV-61 005-2987