

PREPARED FOR
PATTI KIRCHHOFF
KEEFE REAL ESTATE
751 GENEVA PARKWAY
LAKE GENEVA WI.

PLAT OF SURVEY

-OF-

KROTT SURVEYING INC.
N3705 WILLOW BEND LANE
LAKE GENEVA WI. 53147
PHONE # (262)248-3697
FAX # (262)249-0639

LOTS 14 AND 15, BLOCK 1, INDIAN HILLS FIRST ADDITION, A SUBDIVISION
RECORDED AUGUST 20, 1927 IN VOLUME 8 OF PLATS, PAGE 138, SECTION
14, TOWN 1 NORTH, RANGE 16 EAST, VILLAGE OF FONTANA, WALWORTH
COUNTY, WISCONSIN.




LEGEND

- FOUND IRON PIPE
- △ FOUND MAG NAIL
- SET IRON BAR

(XX) RECORDED AS

TAX ID # SIHF00011

JOB # 13-016

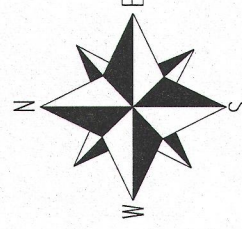


SCALE 1" = 20'



NOTE: BEARINGS ARE REFERENCED TO THE RECORD PLAT

I have surveyed the above-described property and the above map is a true representation thereof and shows the size and location of the property, its exterior boundaries, the location and dimensions of all structures thereon, fences apparent easements and roadways and visible encroachments, if any.

This survey is made for the exclusive use of the present owners of the property, and also those who purchase, mortgage, or insure the title thereto within one (1) year from date hereof; and as to them I warrant the accuracy of said survey map.

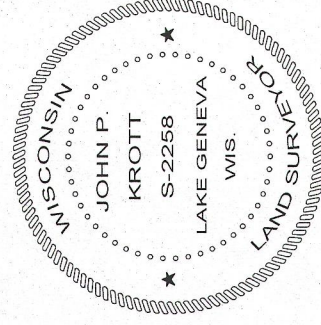

DATED THIS 4th DAY OF FEBRUARY 2013.

JOHN KROTT S - 2258
Wisconsin Registered Land Surveyor
(original if signed in red)

005-2992