


PLAT OF SURVEY

- OF -

This plat map illustrates the boundaries and features of three adjacent lots. The map includes the following details:

- Lot 10:** Located on the left, it contains a 'SHED' with dimensions 11.2' x 8.9' x 11.9' x 4.5'. The boundary with Lot 11 is 129.34' (130.7'). The boundary with Lot 12 is 129.31'.
- Lot 11:** The central lot, containing an 'EXISTING HOUSE' and a 'CARPORT' with an 'ASPHALT DRIVE'. The house has dimensions 30.6' x 24.4' x 36.7' x 9.4'. The carport has dimensions 18.7' x 18.0' x 17.9' x 13.2'. The boundary with Lot 10 is 129.34' (130.7'). The boundary with Lot 12 is 126.9'.
- Lot 12:** Located on the right, it is bounded by Van Slyke Drive to the north and east. The boundary with Lot 10 is 129.83'.
- Van Slyke Drive:** A curved boundary to the north of the lots, defined by the equation $R=621.00' L=109.92' LC=109.77' LCB=S 17^{\circ}27'01'' W$ (30' WIDE).
- Other Features:** A 'STOOP' is shown on the east side of the existing house. A 'SOUTH LINE OF LOT 10' is indicated by a dashed line. A north arrow is located in the upper right corner.

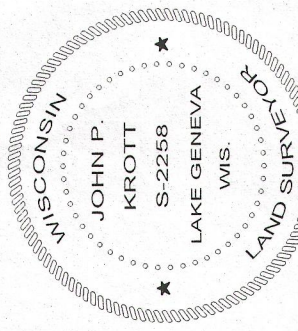

I have surveyed the above-described property and the above map is a true representation thereof and shows the size and location of the property, its exterior boundaries, the location and dimensions of all structures thereon, fences apparent easements and roadways and visible encroachments, if any.

This survey is made for the exclusive use of the present owners of the property, and also those who purchase, mortgage, or insure the title thereto within one (1) year from date hereof; and as to them I warrant the accuracy of said survey map.

TAX ID # SCO3 00063

JOHN KROTT S - 2258
Wisconsin Registered Land Surveyor
(original if signed in red)

005-3013