
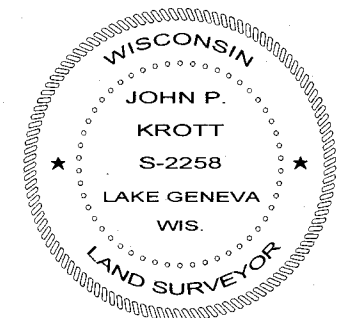
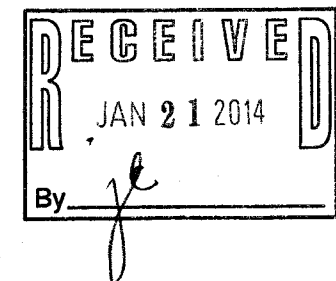


PREPARED FOR
MARK LARKIN
KEEFE REAL ESTATE
751 GENEVA PARKWAY
LAKE GENEVA WI. 53147

PLAT OF SURVEY OF

KROTT SURVEYING INC.
(262) 248-3697
N 3705 WILLOW BEND LANE
LAKE GENEVA WI. 53147

LOT 4 CERTIFIED SURVEY NO. 1523 RECORDED IN VOLUME 7
OF CERTIFIED SURVEYS ON PAGE 136, WALWORTH COUNTY
RECORDS, LOCATED IN THE SOUTHEAST 1/4 OF THE
NORTHWEST 1/4 OF SECTION 11, TOWN 1 NORTH, RANGE 16
EAST, VILLAGE OF FONTANA, WALWORTH COUNTY, WISCONSIN.

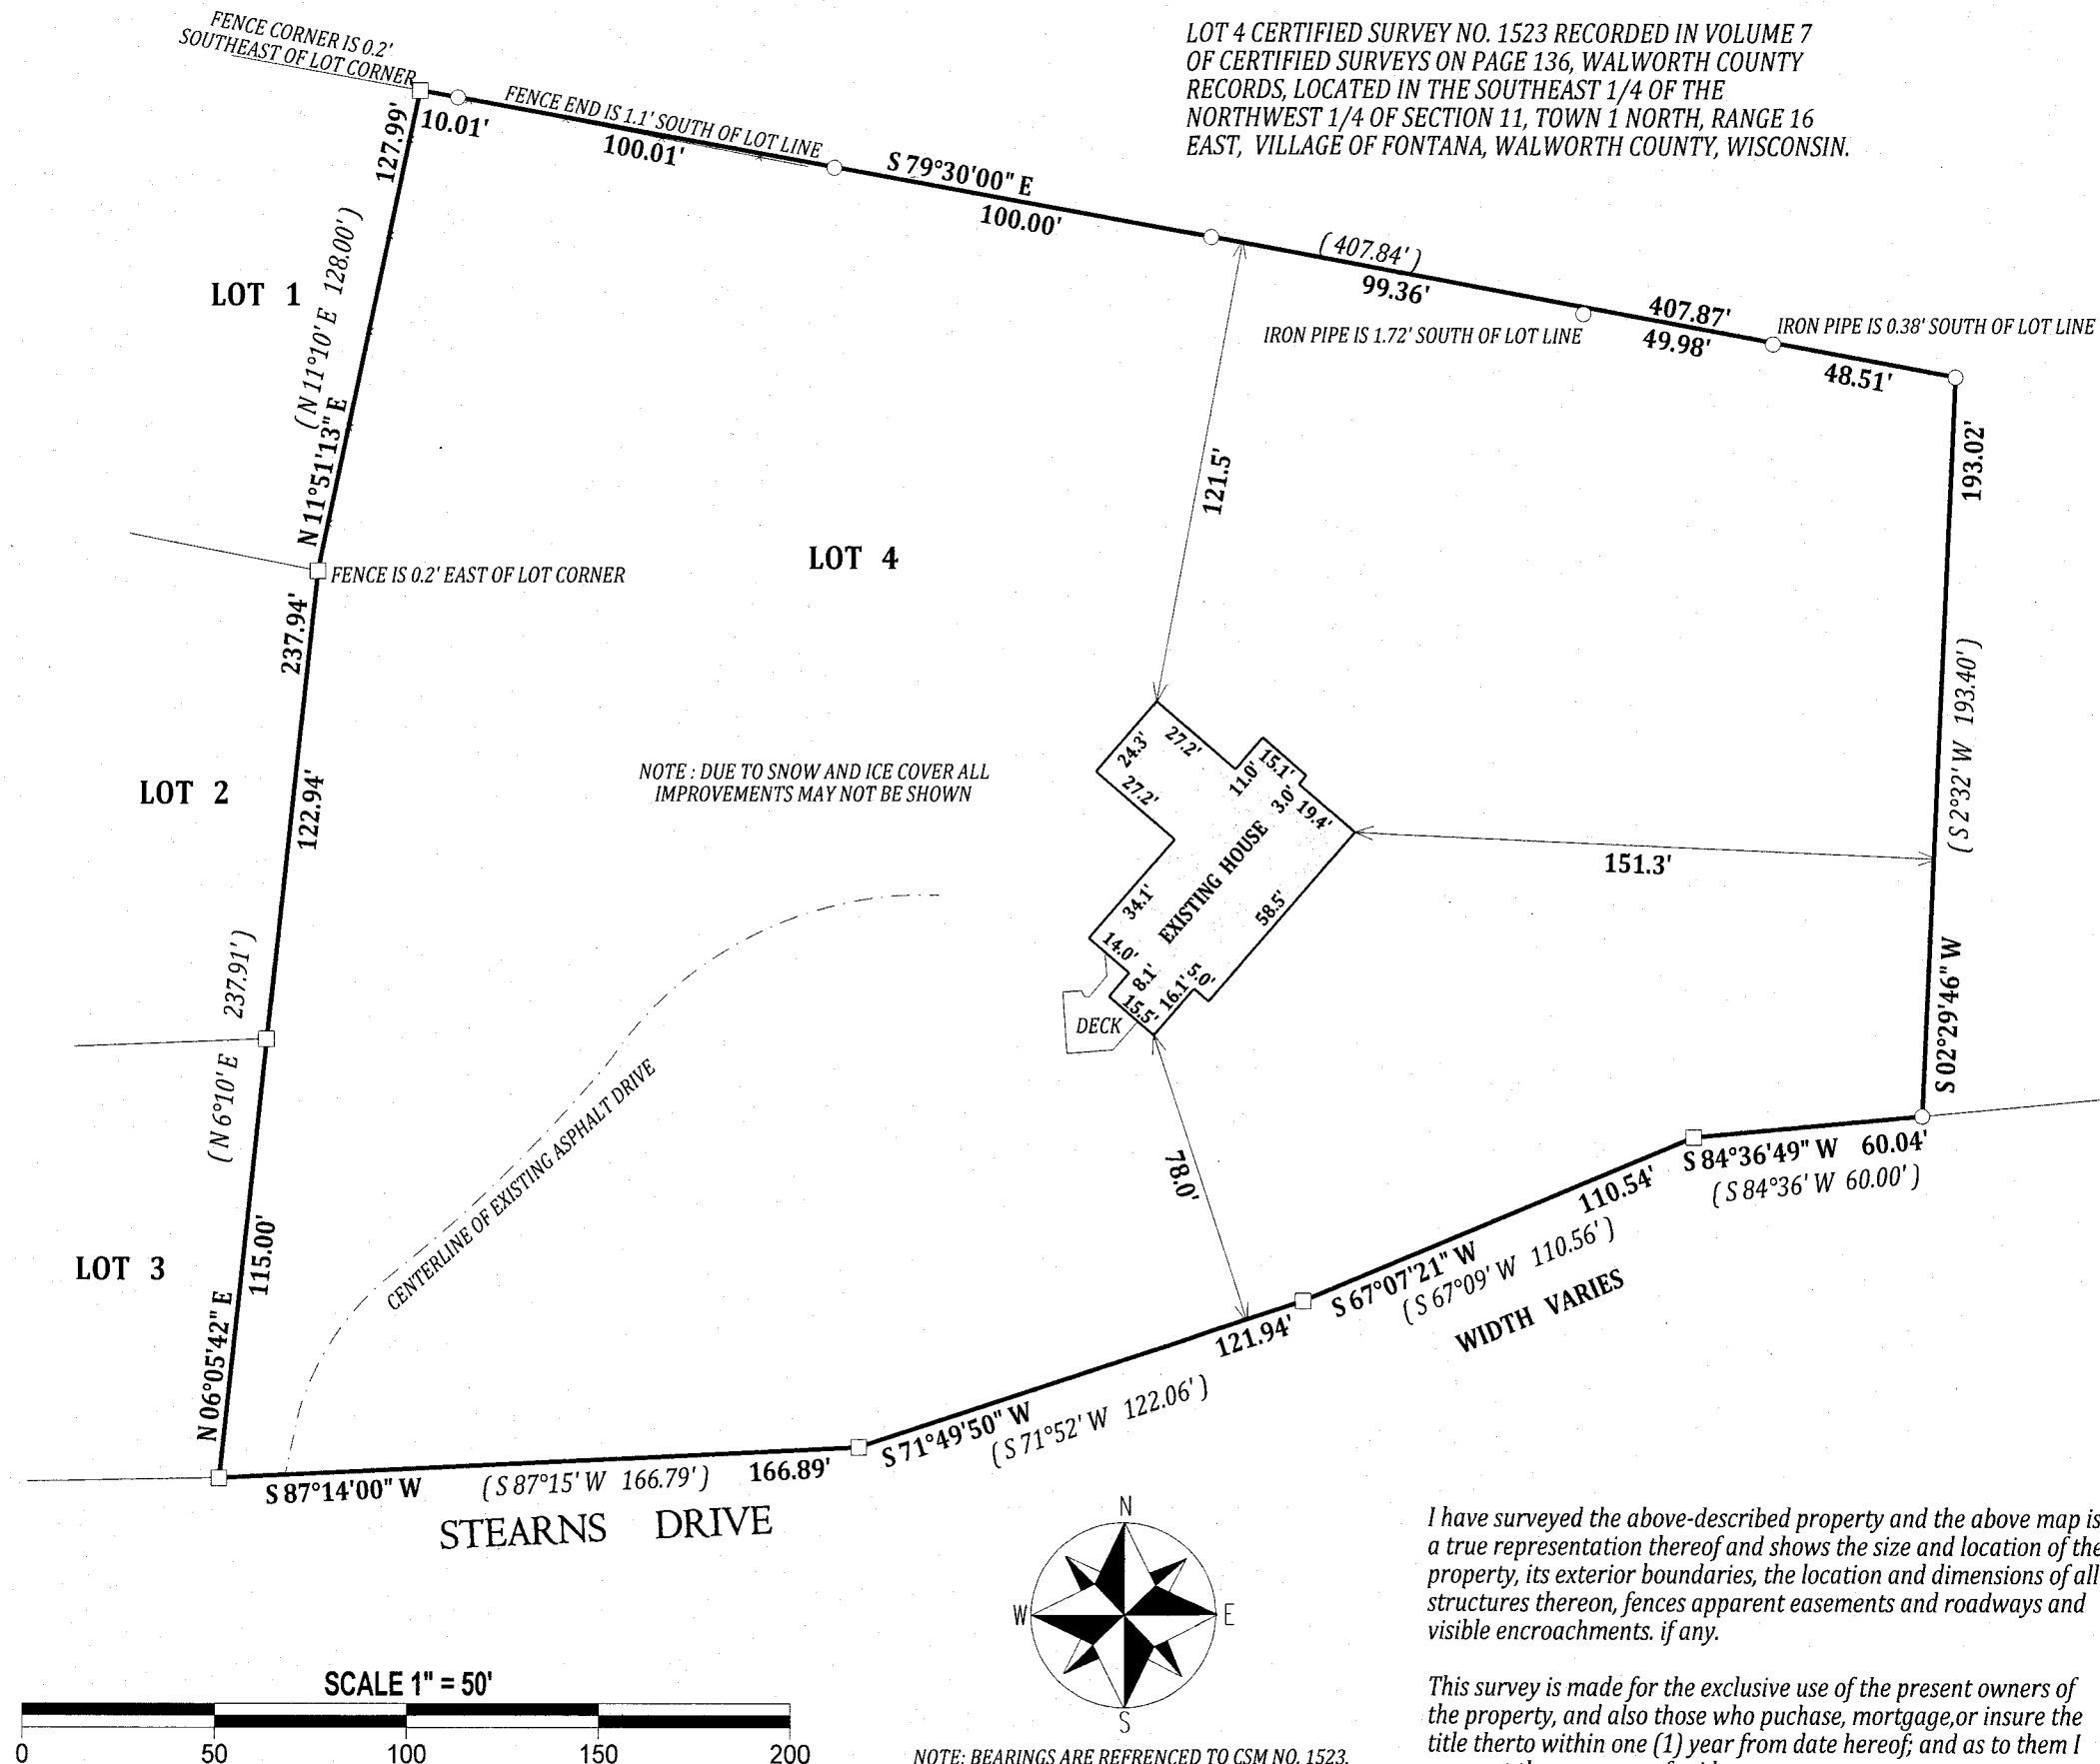

DATED THIS 27th DAY OF DECEMBER 2013

John P. Krott

JOHN P. KROTT S-2258

WISCONSIN REGISTERED LAND SURVEYOR

(NOTE: THIS IS NOT A CERTIFIED COPY UNLESS SIGNED IN RED INK)

I have surveyed the above-described property and the above map is a true representation thereof and shows the size and location of the property, its exterior boundaries, the location and dimensions of all structures thereon, fences apparent easements and roadways and visible encroachments, if any.

This survey is made for the exclusive use of the present owners of the property, and also those who purchase, mortgage, or insure the title thereto within one (1) year from date hereof; and as to them I warrant the accuracy of said survey map.

SA1523-4

005-3033