

PREPARED FOR
TOM SULLIVAN
308 KINZIE AVE.
FONTANA WI. 53125


PLAT OF SURVEY

KROTT SURVEYING INC.
N3705 WILLOW BEND LANE
LAKE GENEVA WI. 53147
PHONE # (262)248-3697
FAX # (262)249-0639

LOT 2 OF PARTRIDGE COURT SUBDIVISION, LOCATED IN THE
SOUTHWEST 1/4 OF SECTION 14, TOWN 1 NORTH, RANGE 16
EAST, VILLAGE OF FONTANA-ON-GENEVA LAKE, WALWORTH
COUNTY, WISCONSIN.


GENEVA LAKE

SEA WALL

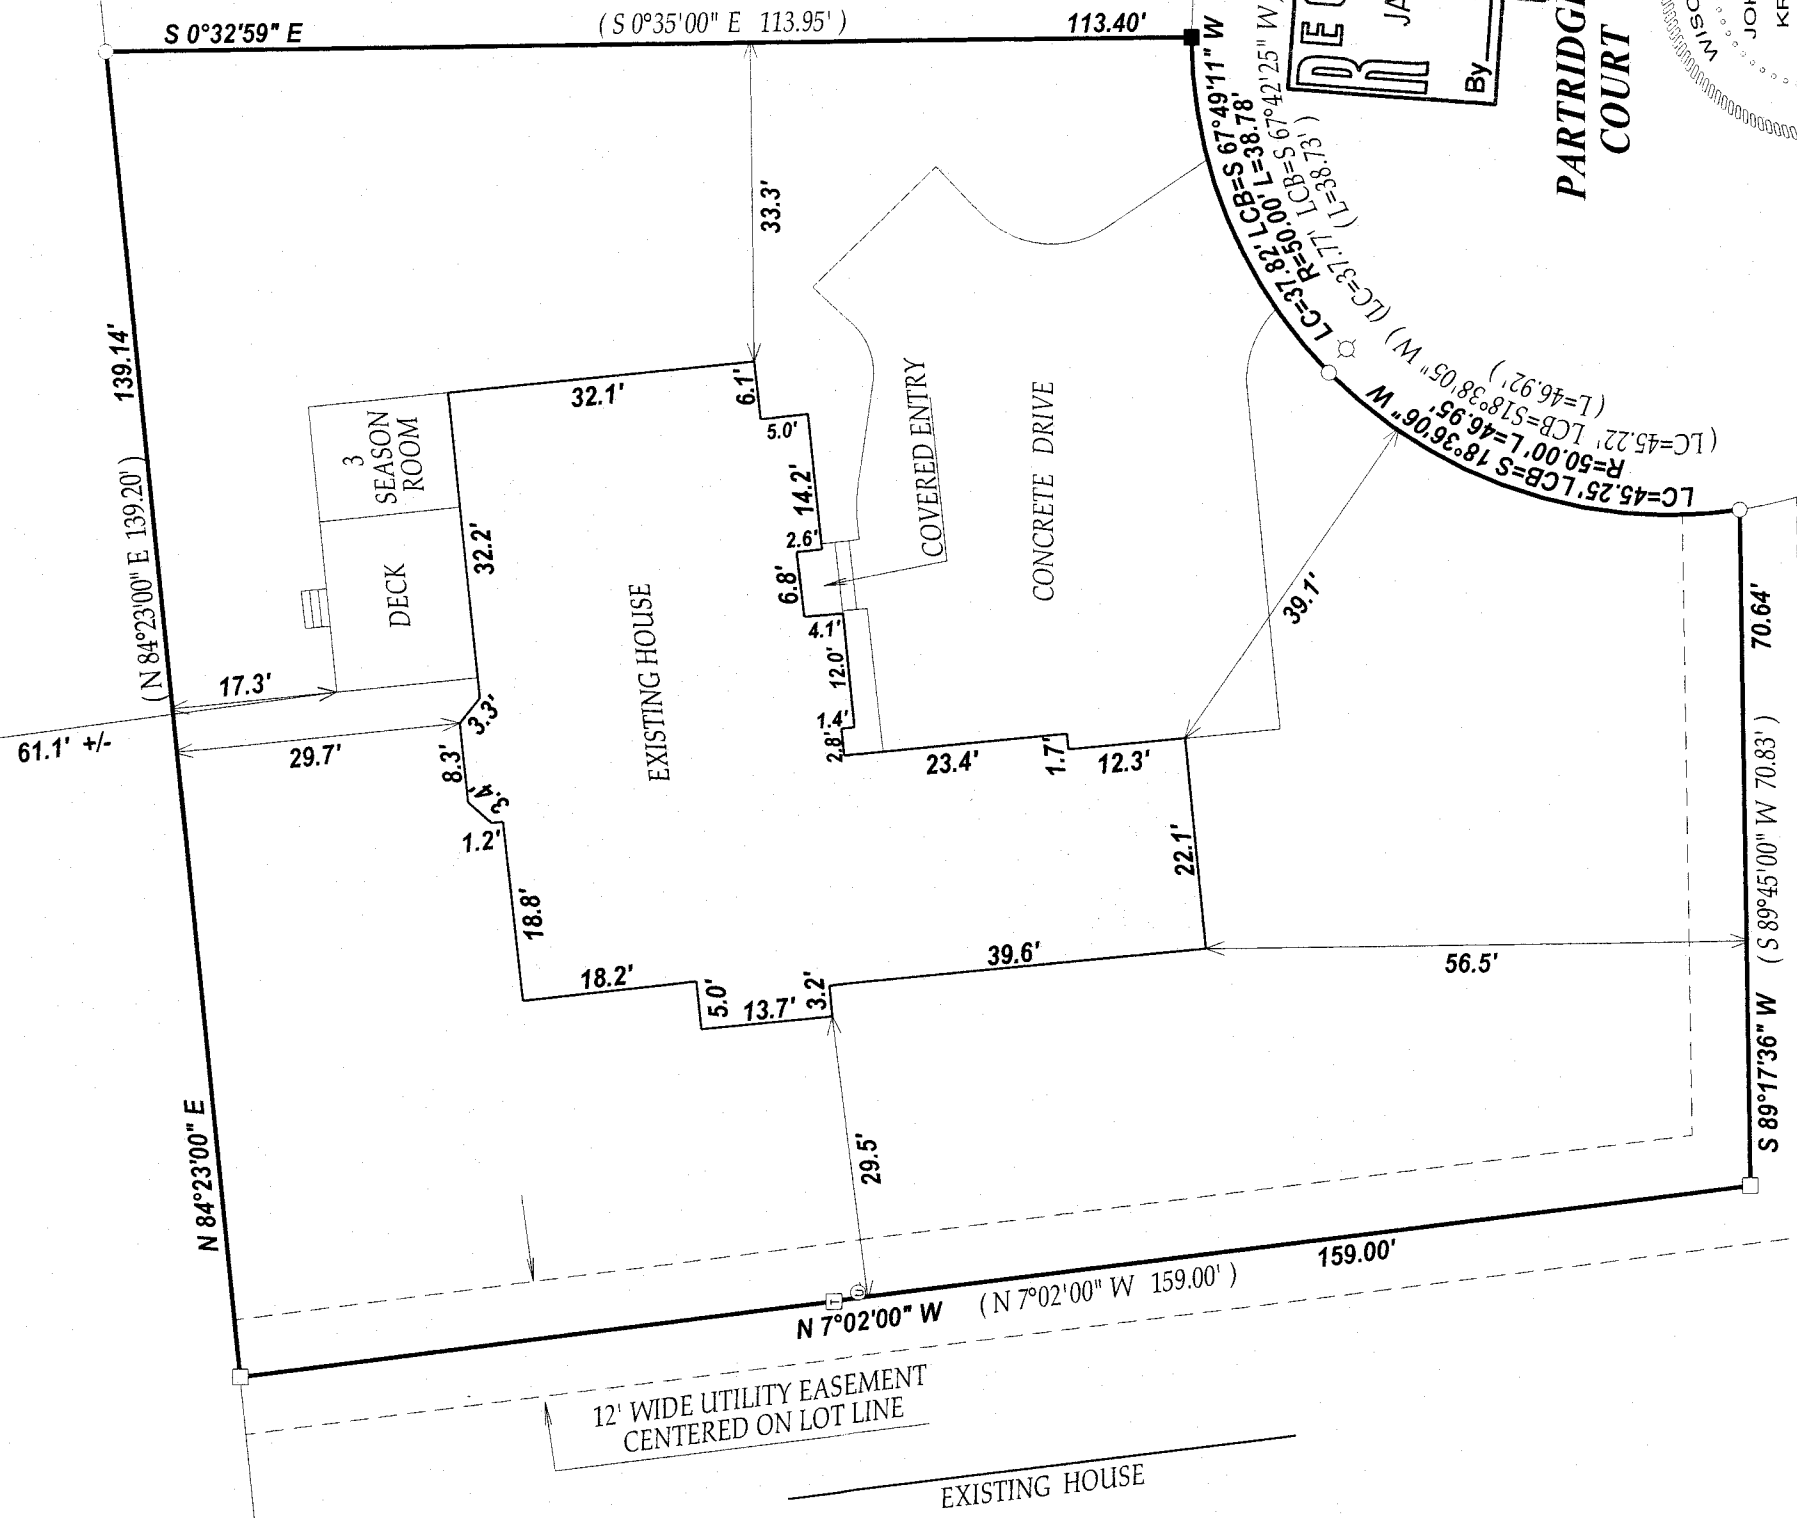

LEGEND

- FOUND IRON PIPE
- FOUND IRON BAR
- SET IRON BAR
- ⊞ ELECTRIC TRANSFORMER
- ⊙ UTILITY PEDESTAL
- ⊞ FIRE HYDRANT
- (XX) RECORDED AS

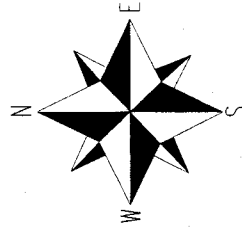


NOTE: BEARINGS ARE REFERENCED TO THE RECORD PLAT OF
PARTRIDGE COURT SUB. AND THE NORTH LINE OF LOT 2 WAS
ASSUMED TO BEAR N 84°23'00" E.

I have surveyed the above-described property and the above map is
a true representation thereof and shows the size and location of the
property, its exterior boundaries, the location and dimensions of all
structures thereon, fences apparent easements and roadways and
visible encroachments, if any.


This survey is made for the exclusive use of the present owners of
the property, and also those who purchase, mortgage, or insure the
title thereto within one (1) year from date hereof, and as to them I
warrant the accuracy of said survey map.

DATED THIS 9th DAY OF FEBRUARY 2010.
DATE OF LAST REVISION: 10/08/2013
REVISED 05/12/2010
REVISED 02/15/2010
REVISED 2/12/2010

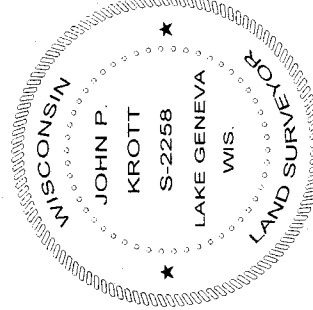

John P. Krott

JOHN KROTT S-2258
Wisconsin Registered Land Surveyor
(original if signed in red)

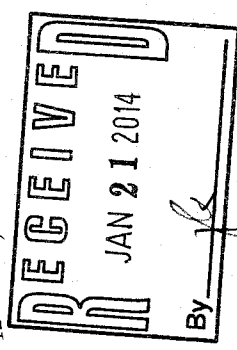

PARTRIDGE
COURT