


PREPARED FOR
LOWELL MANAGEMENT
401 GENEVA NATIONAL AVE. SO.
LAKE GENEVA WI. 53147

PLAT OF SURVEY

-OF-
LOT 1, BLOCK 1 BROOKWOOD SUBDIVISION, LOCATED IN THE VILLAGE OF
FONTANA - ON - GENEVA LAKE, WALWORTH COUNTY, WISCONSIN.


KROTT SURVEYING INC.
N3705 WILLOW BEND LANE
LAKE GENEVA WI. 53147
PHONE # (262)248-3697
FAX # (262)249-0639

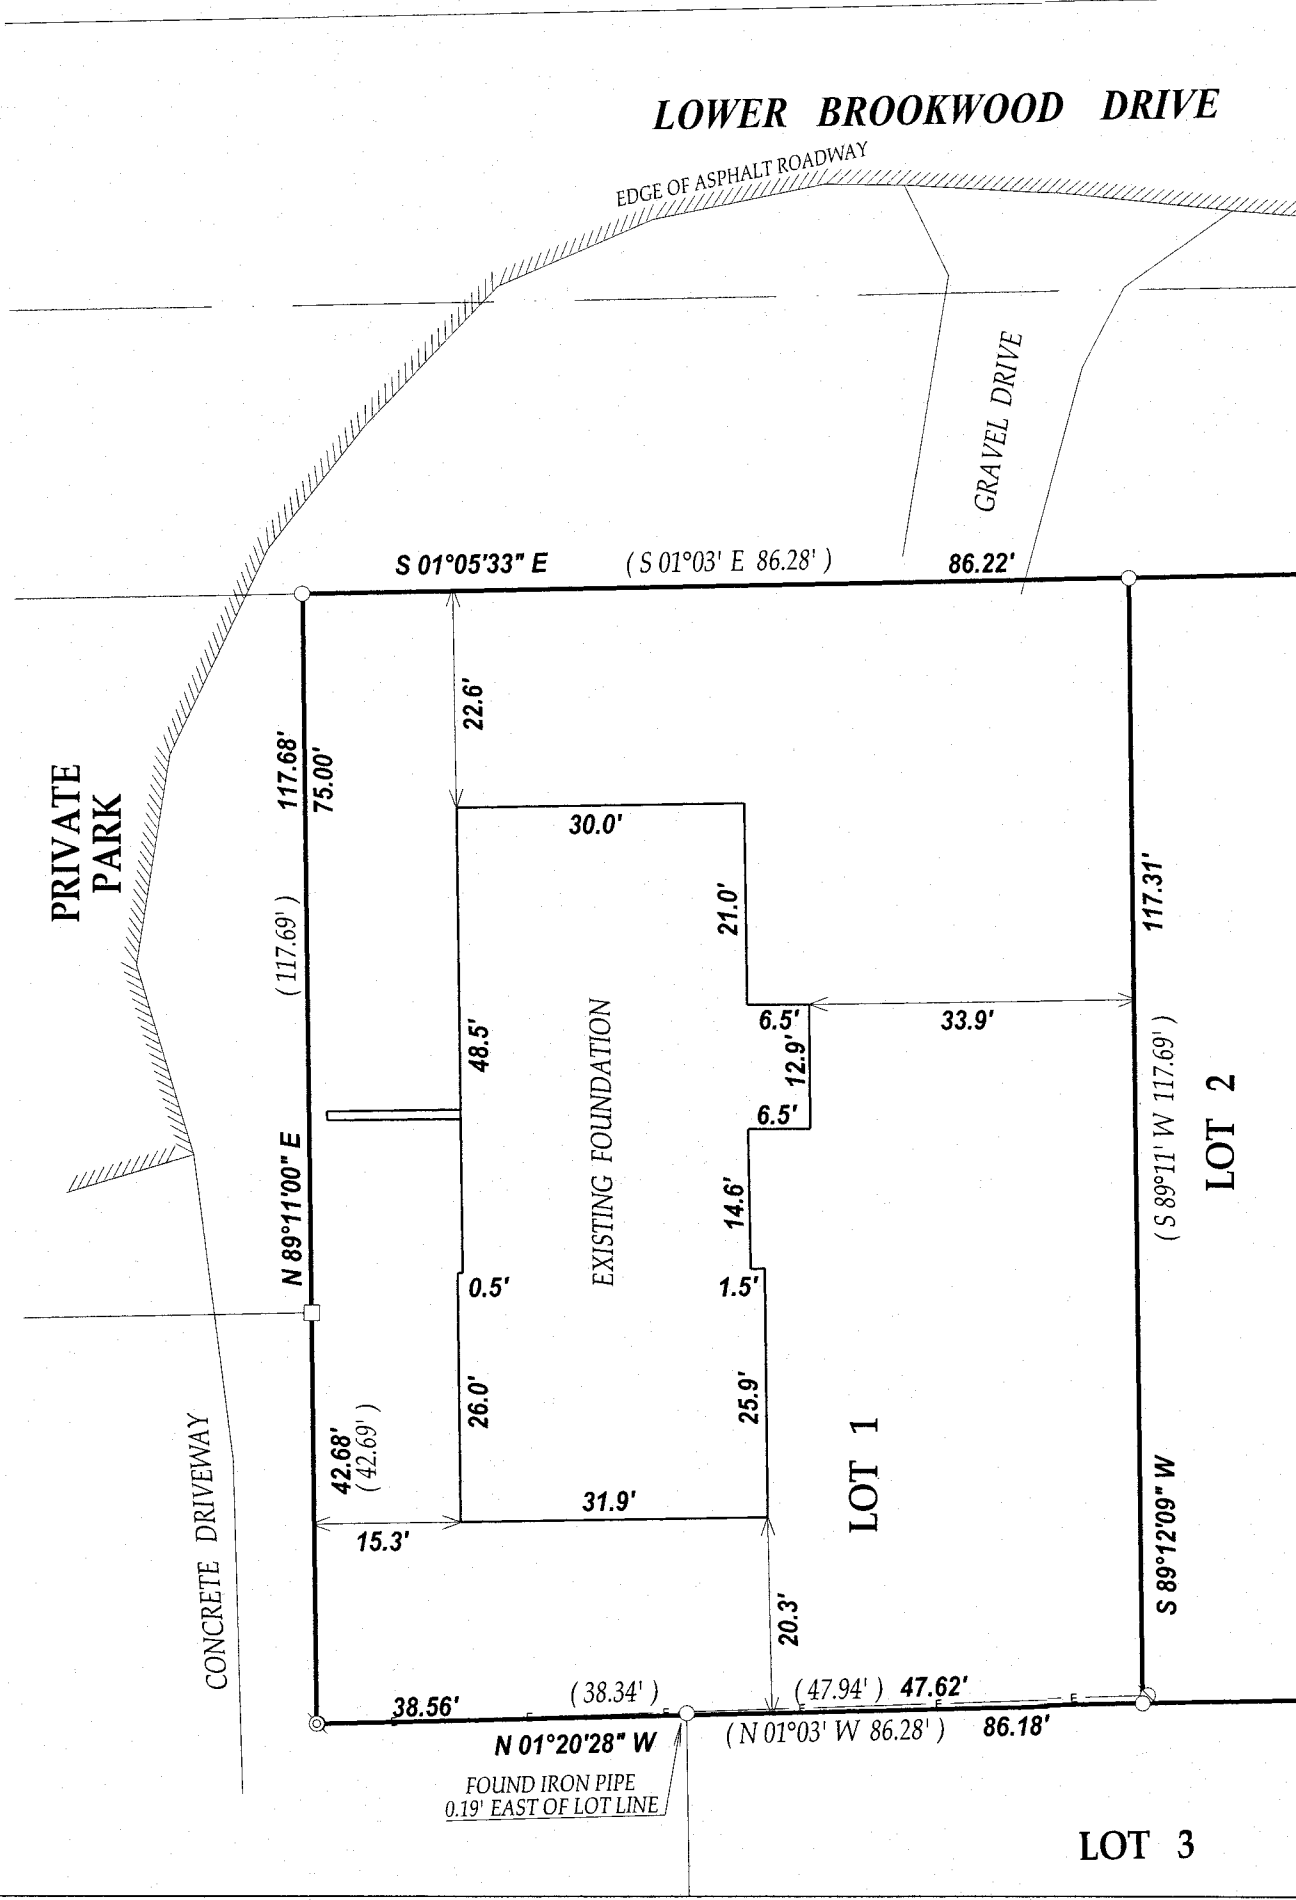

LEGEND

- FOUND 1" DIA. IRON PIPE
- ⊙ FOUND 2" DIA. IRON PIPE
- FOUND IRON BAR
- ⊕ ELECTRIC METER
- ⊗ GAS METER
- ∅ UTILITY POLE
- OVERHEAD WIRES
- ⊙ DECIDUOUS TREE
- ✱ CONIFER TREE
- (XX) RECORDED AS

TAX ID # SBS00001
JOB # 12-011PH


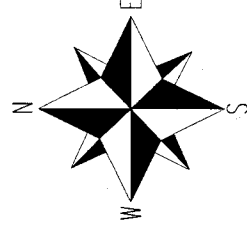


SCALE 1"=20'



NOTE: BEARINGS ARE REFERENCED TO THE RECORD PLAT
I have surveyed the above-described property and the above map is
a true representation thereof and shows the size and location of the
property, its exterior boundaries, the location and dimensions of all
structures thereon, fences apparent encumbrances and roadways and
visible encroachments, if any.

This survey is made for the exclusive use of the present owners of
the property, and also those who purchase, mortgage, or insure the
title thereto within one (1) year from date hereof; and as to them I
warrant the accuracy of said survey map.

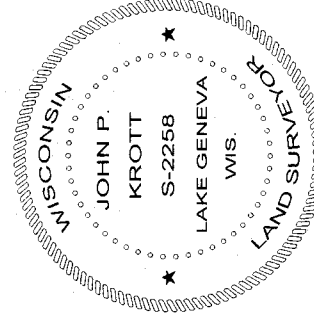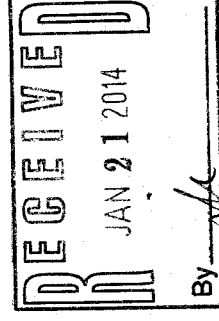

DATED THIS 15th DAY OF FEBRUARY 2012.
DATE OF LAST REVISION 12/09/2013
REVISED 10/23/2013

John P. Krott

JOHN KROTT S - 2258
Wisconsin Registered Land Surveyor
(original if signed in red)

BB8-1 005-3036