


LAND-MARK SURVEYING
Mark L. Miritz
Wisconsin Registered Land Surveyor S-2582

N9330 Knuteson Drive
Whitewater, WI 53190
Phone: (262) 495-3284
MARKMIRITZ@
LAND-MARKSURVEYING.COM


PLAT OF SURVEY

LOT 6, BLOCK 7, INDIAN HILLS FIRST ADDITION
TO THE VILLAGE OF FONTANA, LOCATED IN THE
SOUTHEAST 1/4 OF THE SOUTHEAST 1/4 OF
SECTION 14, TOWN 1 NORTH, RANGE 16 EAST,
VILLAGE OF FONTANA, WALWORTH COUNTY,
WISCONSIN.

ORDERED BY: JULIE SARTON
KEEFE REAL ESTATE
751 GENEVA PARKWAY
LAKE GENEVA, WI 53147

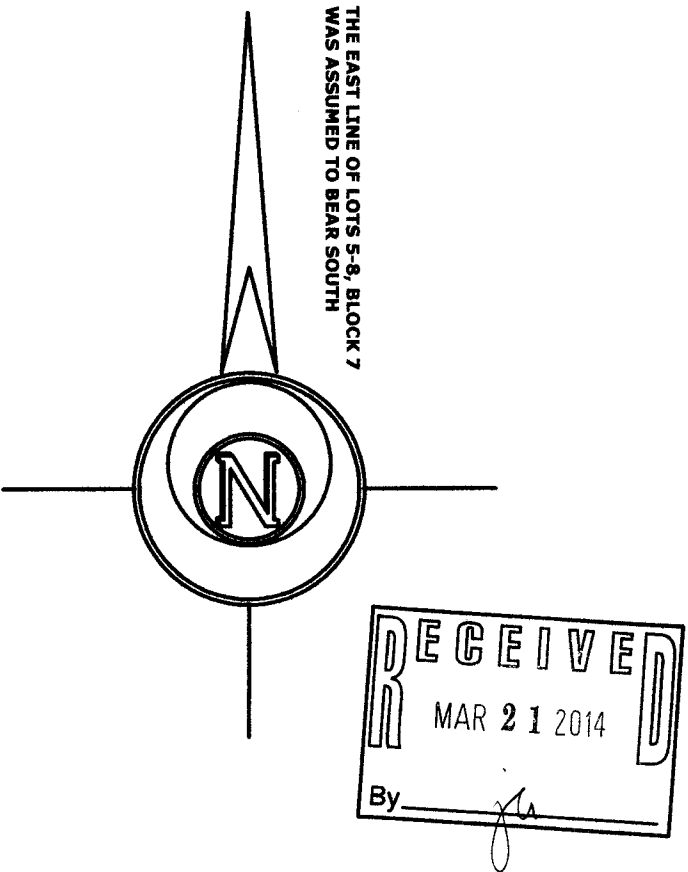

ADSILA WAY A.K.A. ODSILA WAY
(20' WIDE)

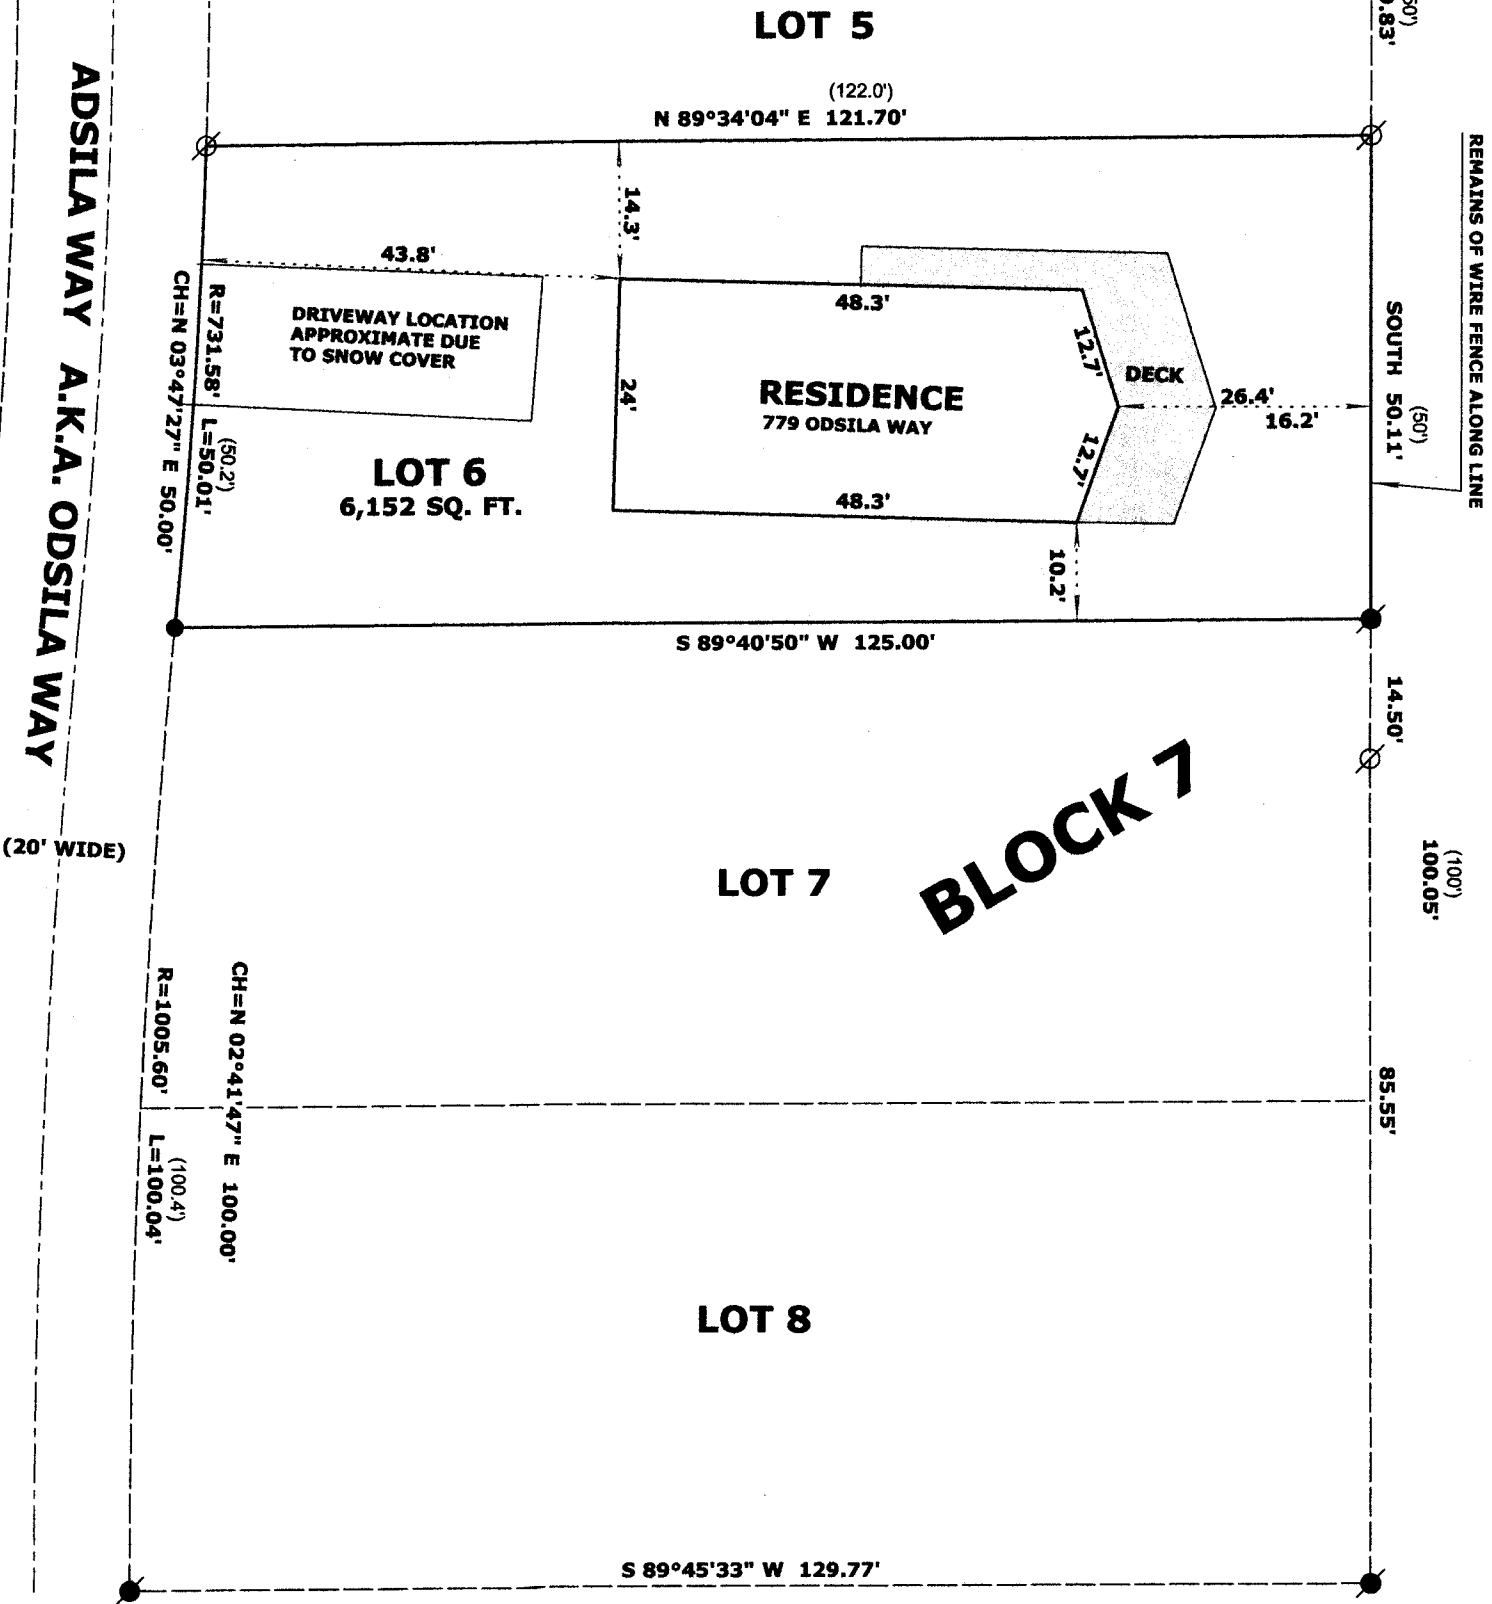

LEGEND

- FOUND IRON PIPE 1.5"
- FOUND IRON PIPE 0.75"
- SET IRON ROD, 18" LONG, WEIGHING 1.5 LBS./LINEAL FT., 3/4" DIA.
- (x x) RECORDED AS DIMENSION

SCALE: 1 INCH = 20 FEET

"I hereby certify that the above described property has been surveyed by me or under my direction and that the above map is a true representation thereof and shows the size and location of the property, its exterior boundaries, the location of all visible structures and dimensions of all principal buildings thereon, boundary fences, apparent easements, roadways and visible encroachments, if any."
"This survey is made for the use of the present owners of the property, and also those who purchase, mortgage, or guarantee the title thereto within one year from date hereof."

Mark L. Miritz
MARK L. MIRITZ
WISCONSIN REGISTERED
LAND SURVEYOR S-2582

DATE: FEB. 19, 2014 JOB NO. 14.204

8IHF -73

005 - 3037