


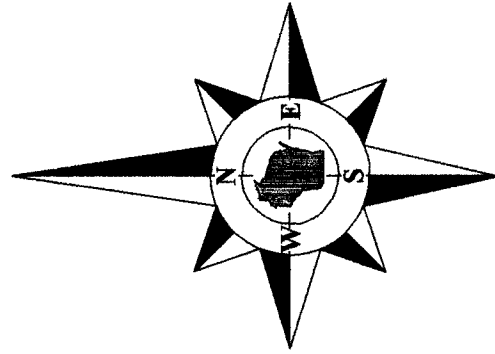

Bearings reference to the plat of Buena Vista.



Plat of Survey

of

Lots 44 and 63 of Buena Vista,
a subdivision located in the Southwest 1/4 of Section 11,
Town 1 North, Range 16 East, Village of Fontana-on-Geneva
Lake, Walworth County, Wisconsin.

Surveyed for: **Keefe Real Estate, Inc.**

751 Geneva Parkway North
Lake Geneva, Wisconsin. 53147

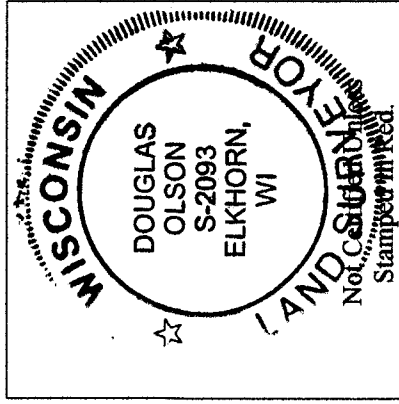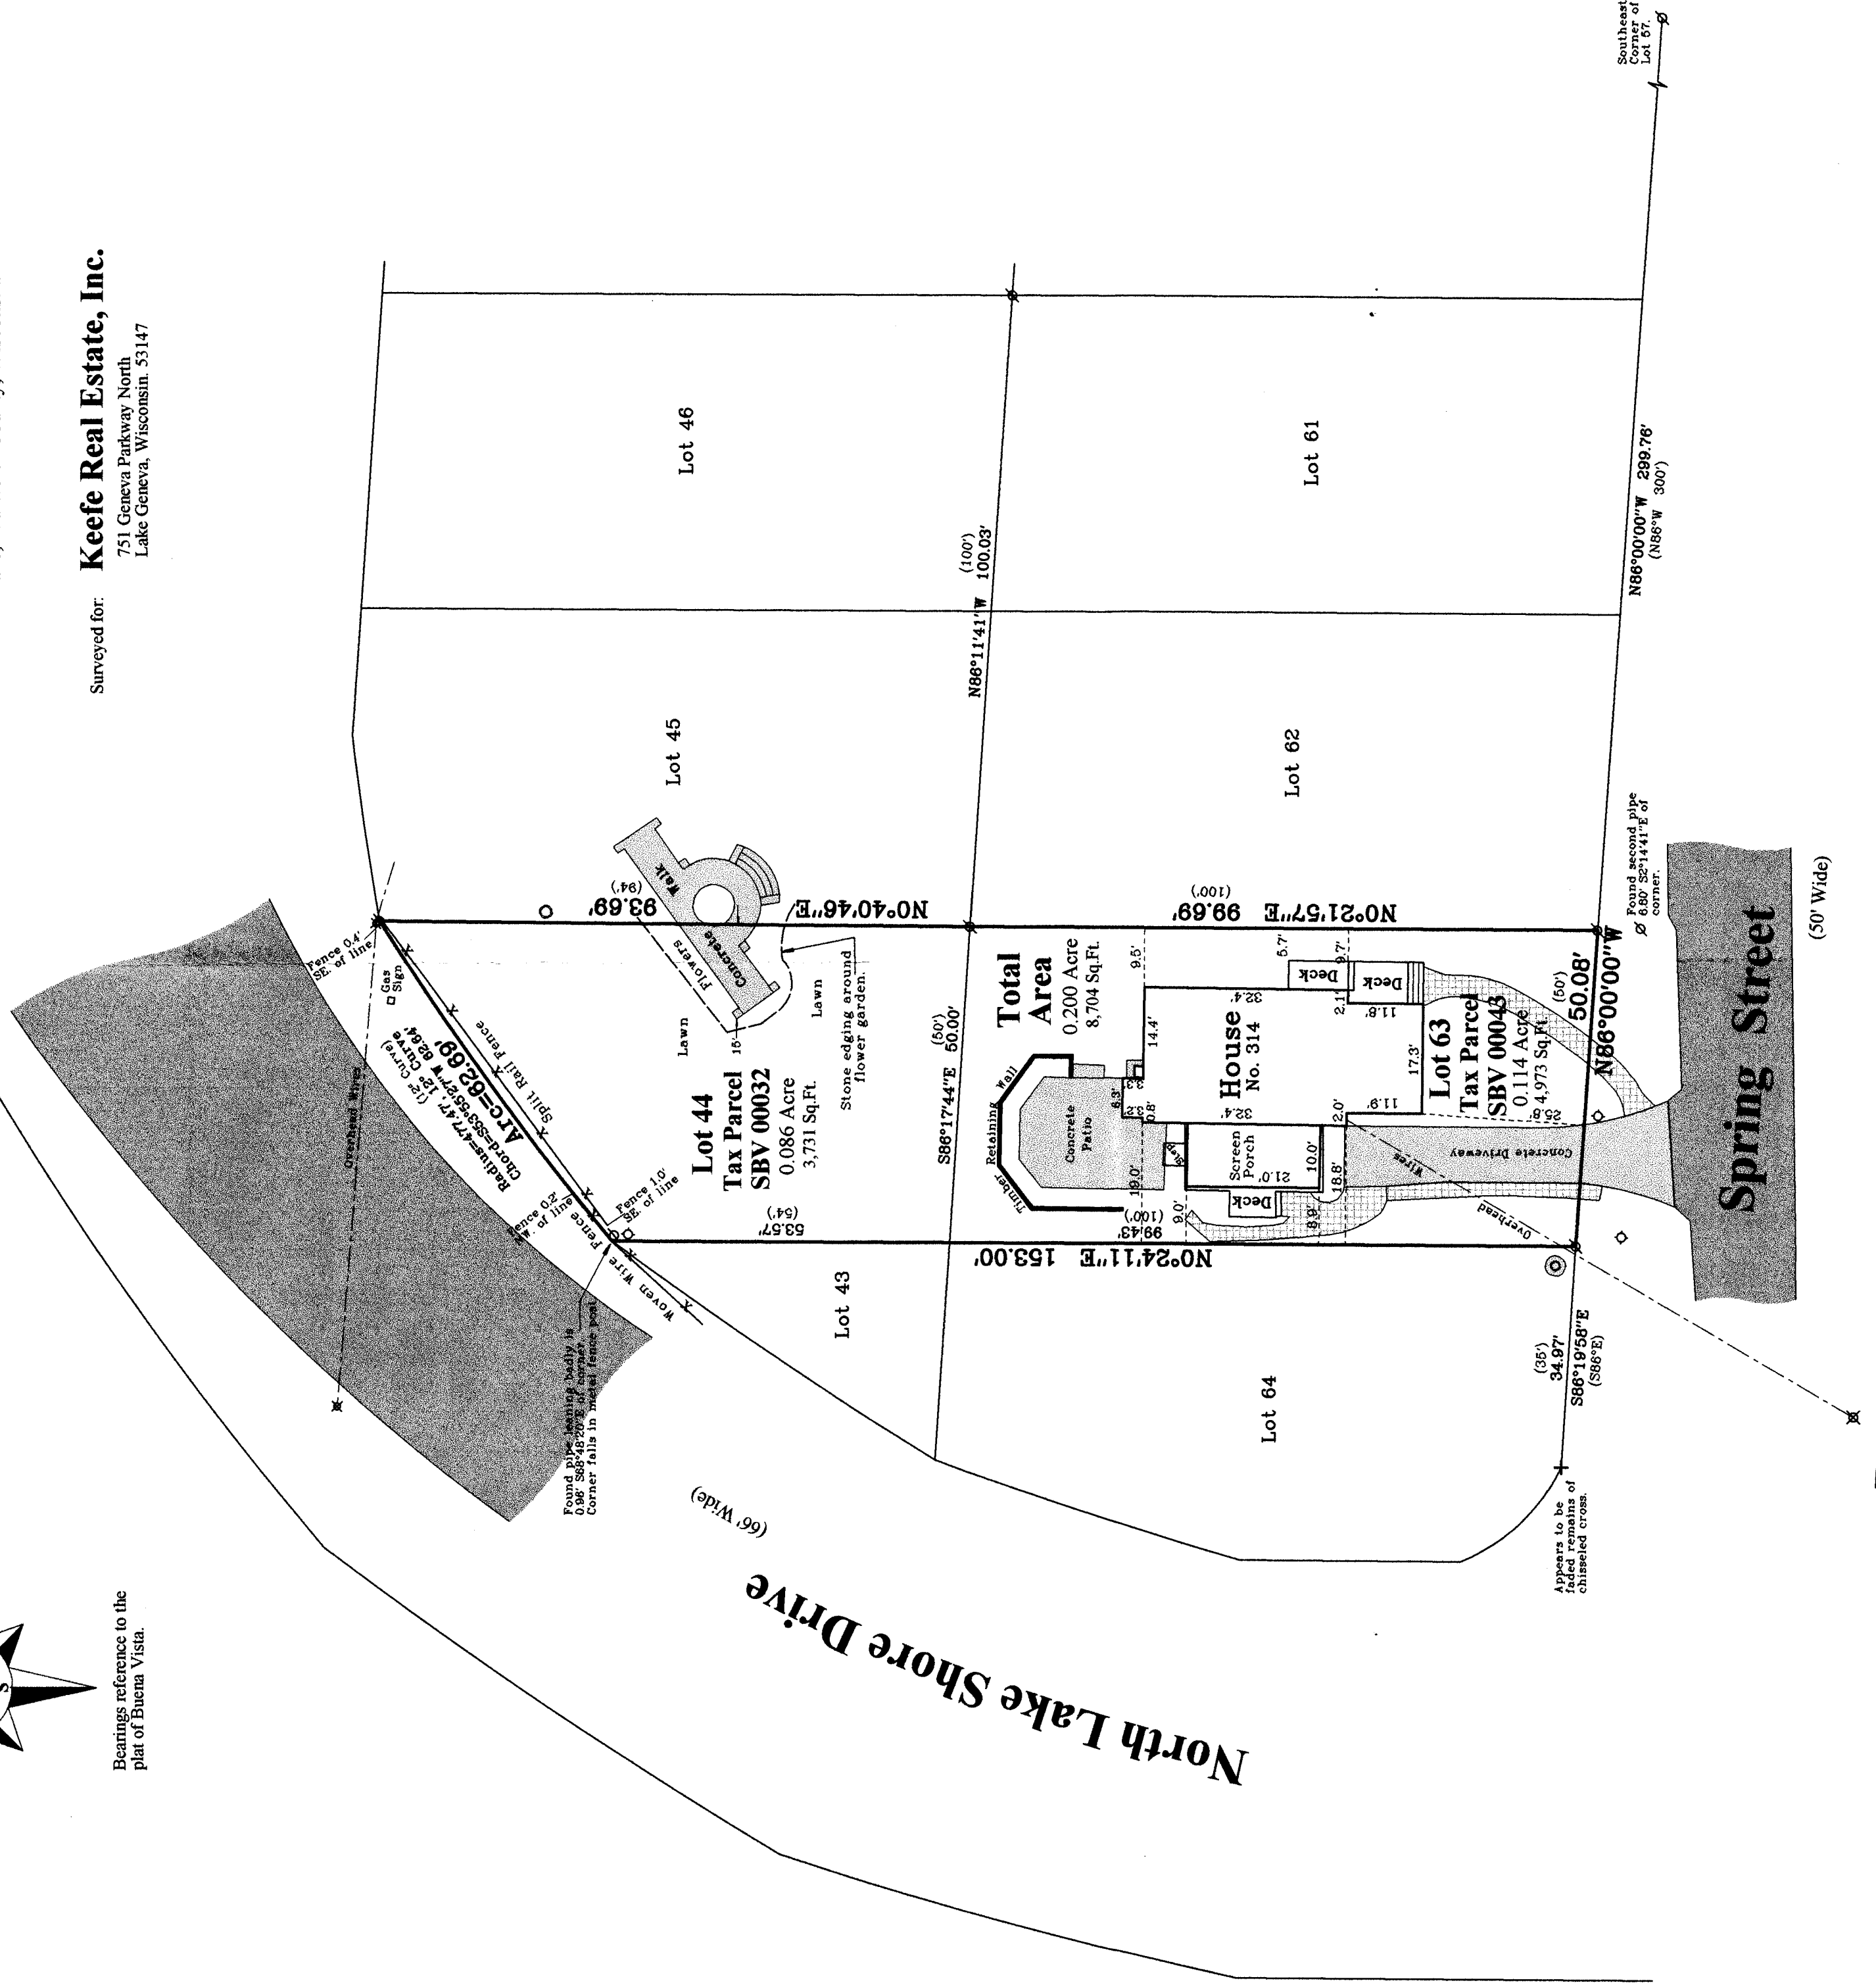

Notes:

- 1) This survey plat is not certified unless signed and sealed in red ink.
- 2) This survey is subject to Wisconsin lien laws. This Plat of Survey is the notice of intent to file lien. Lien waiver required.

Copyright 2014 by Jensen & Olson Land Surveying, LLC.

All rights reserved. No part of this survey plat may be reproduced or transmitted in any form by any means - graphic, electronic, or mechanical, including photocopying, tracing, or information storage and retrieval systems - without permission in writing from Douglas G. Olson, Jensen & Olson Land Surveying, LLC.

I hereby certify that I have surveyed the above described property and the map hereon is correct to the best of my professional knowledge and belief and shows the size and location of the property, its exterior boundaries, the location and dimensions of all visible structures thereon, boundary fences, apparent easements and roadways and visible encroachments, if any.

This survey is made for the exclusive use of the present owners of the property, and also those who purchase, mortgage or guarantee title thereto, within one year from the date hereof.

Douglas G. Olson
Wisconsin Registered Land Surveyor - 2093

Sheet 1 of 1 Sheets

Job Reference Number

2014.047

Legend

- Found Iron Pipe Cross
- Found Chiseled Information
- Recorded Information
- Utility Pole
- Metal Cover
- Asphalt Surface
- Concrete Surface
- Water Valve
- Stone or Brick


Jensen & Olson Land Surveying, LLC

45 South Wisconsin Street * P.O. Box 322 * Elkhorn, Wisconsin. 53121

Telephone: (262) 723-3434 * Facsimile: (262) 723-8044

Email: jensen.olson@elknet.net

Scale in Feet

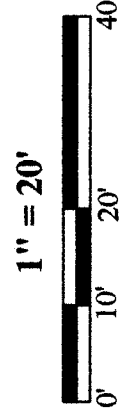

Survey Date: May 29, 2014.
Revisions:

2014.047

SBV-32 8BV-43 005-3045