


**OWNER:
RAFAELITA J. CANTALUPO TRUST
800 N. MICHIGAN AVE #4201
CHICAGO, IL 60611**

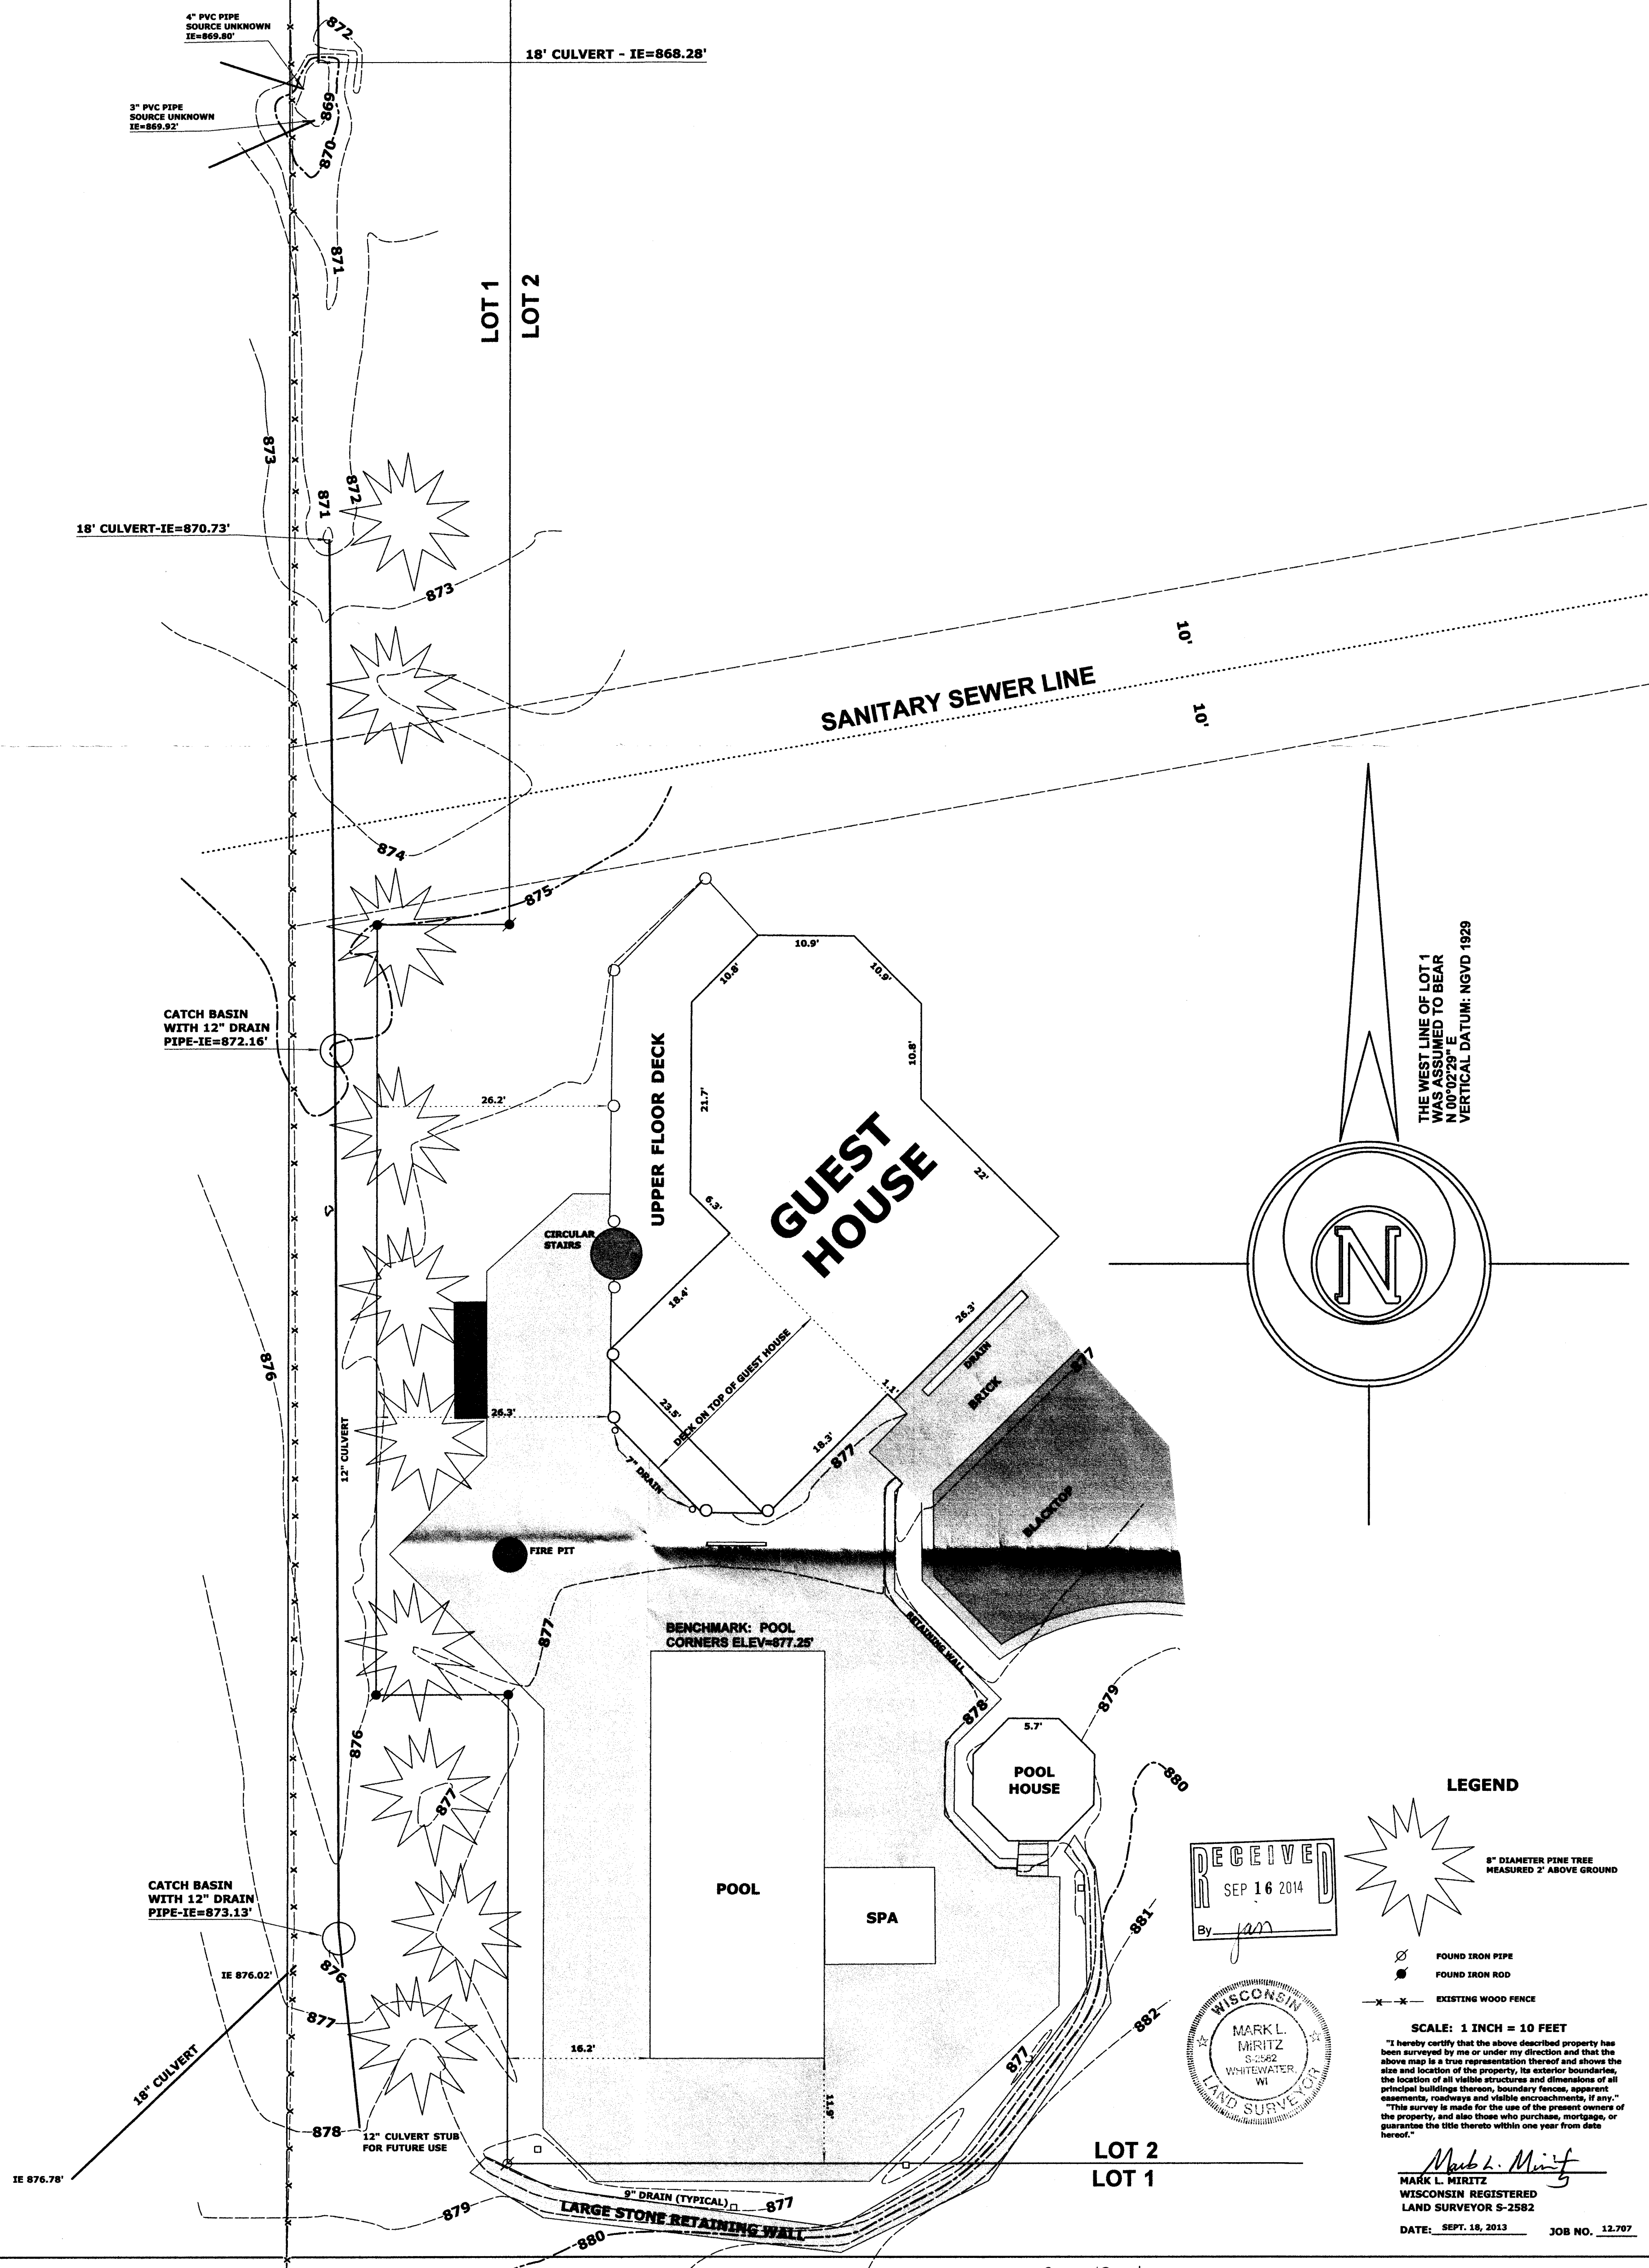

SA 713-1
SA 713-2

005-3066