



**REGISTERED PROFESSIONAL LAND SURVEYOR
LAKE GENEVA, WISCONSIN**

Lot 3, Block 3, Brookwood Sub-
division, Village of Fontana-on-
Geneva-Lake, Walworth County,
Wisconsin.

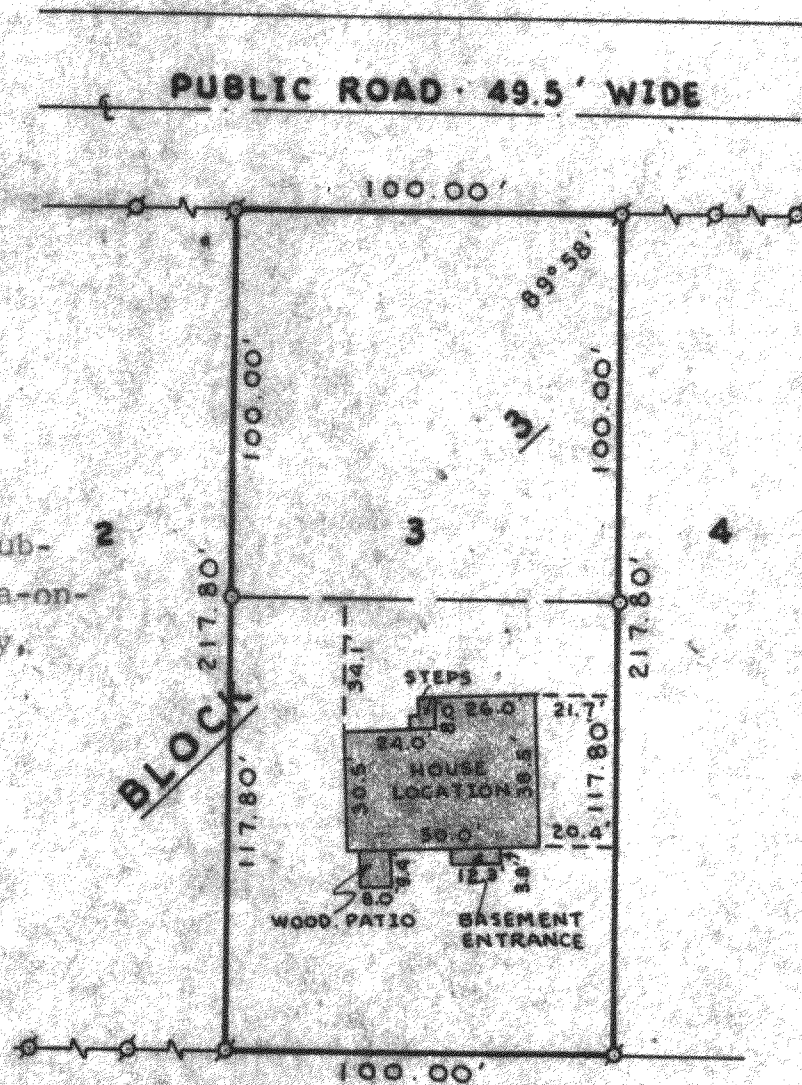

LEGEND

- ♂ — IRON PIPE FOUND
 ○ — IRON PIPE PLACED
 ● — CONCRETE MONUMENT
 X — SPIKE

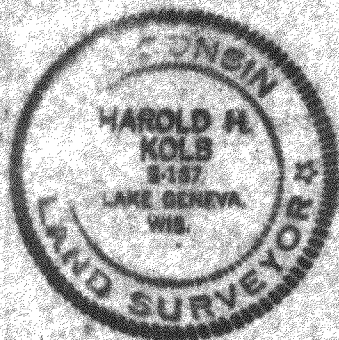

Harold H. Kolb
HAROLD H. KOLB
WISCONSIN REGISTERED LAND SURVEYOR, S-187
DATE October 10, 1973

SB 5-24

5-309