

FARRIS, HANSEN & ASSOCIATES, INC.




ENGINEERING — ARCHITECTURE — SURVEYING
7 RIDGWAY COURT — P.O. BOX 437 — ELKHORN, WISCONSIN 53121
PHONE: (262) 723-2098 FAX: (262) 723-5886

— WORK ORDERED BY —
KEN HARKNESS
1808A WILDBERRY DRIVE
GLENVIEW, IL 60025


RIPARIAN MAPPING

TAX PARCEL SS&G 00002 (HARKNESS PROPERTY)

BEING LOT 2 OF STEARNS & GEROULDS SUBDIVISION
VILLAGE OF FONTANA-ON-GENEVA LAKE, WALWORTH COUNTY, WISCONSIN

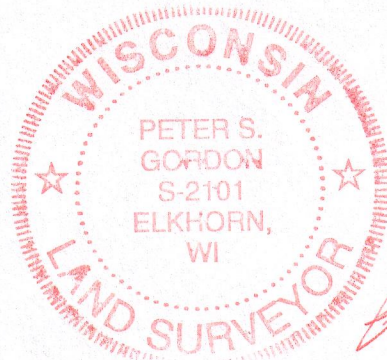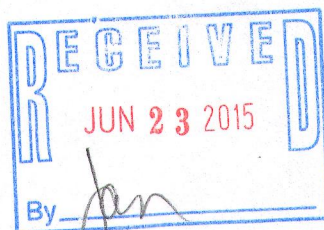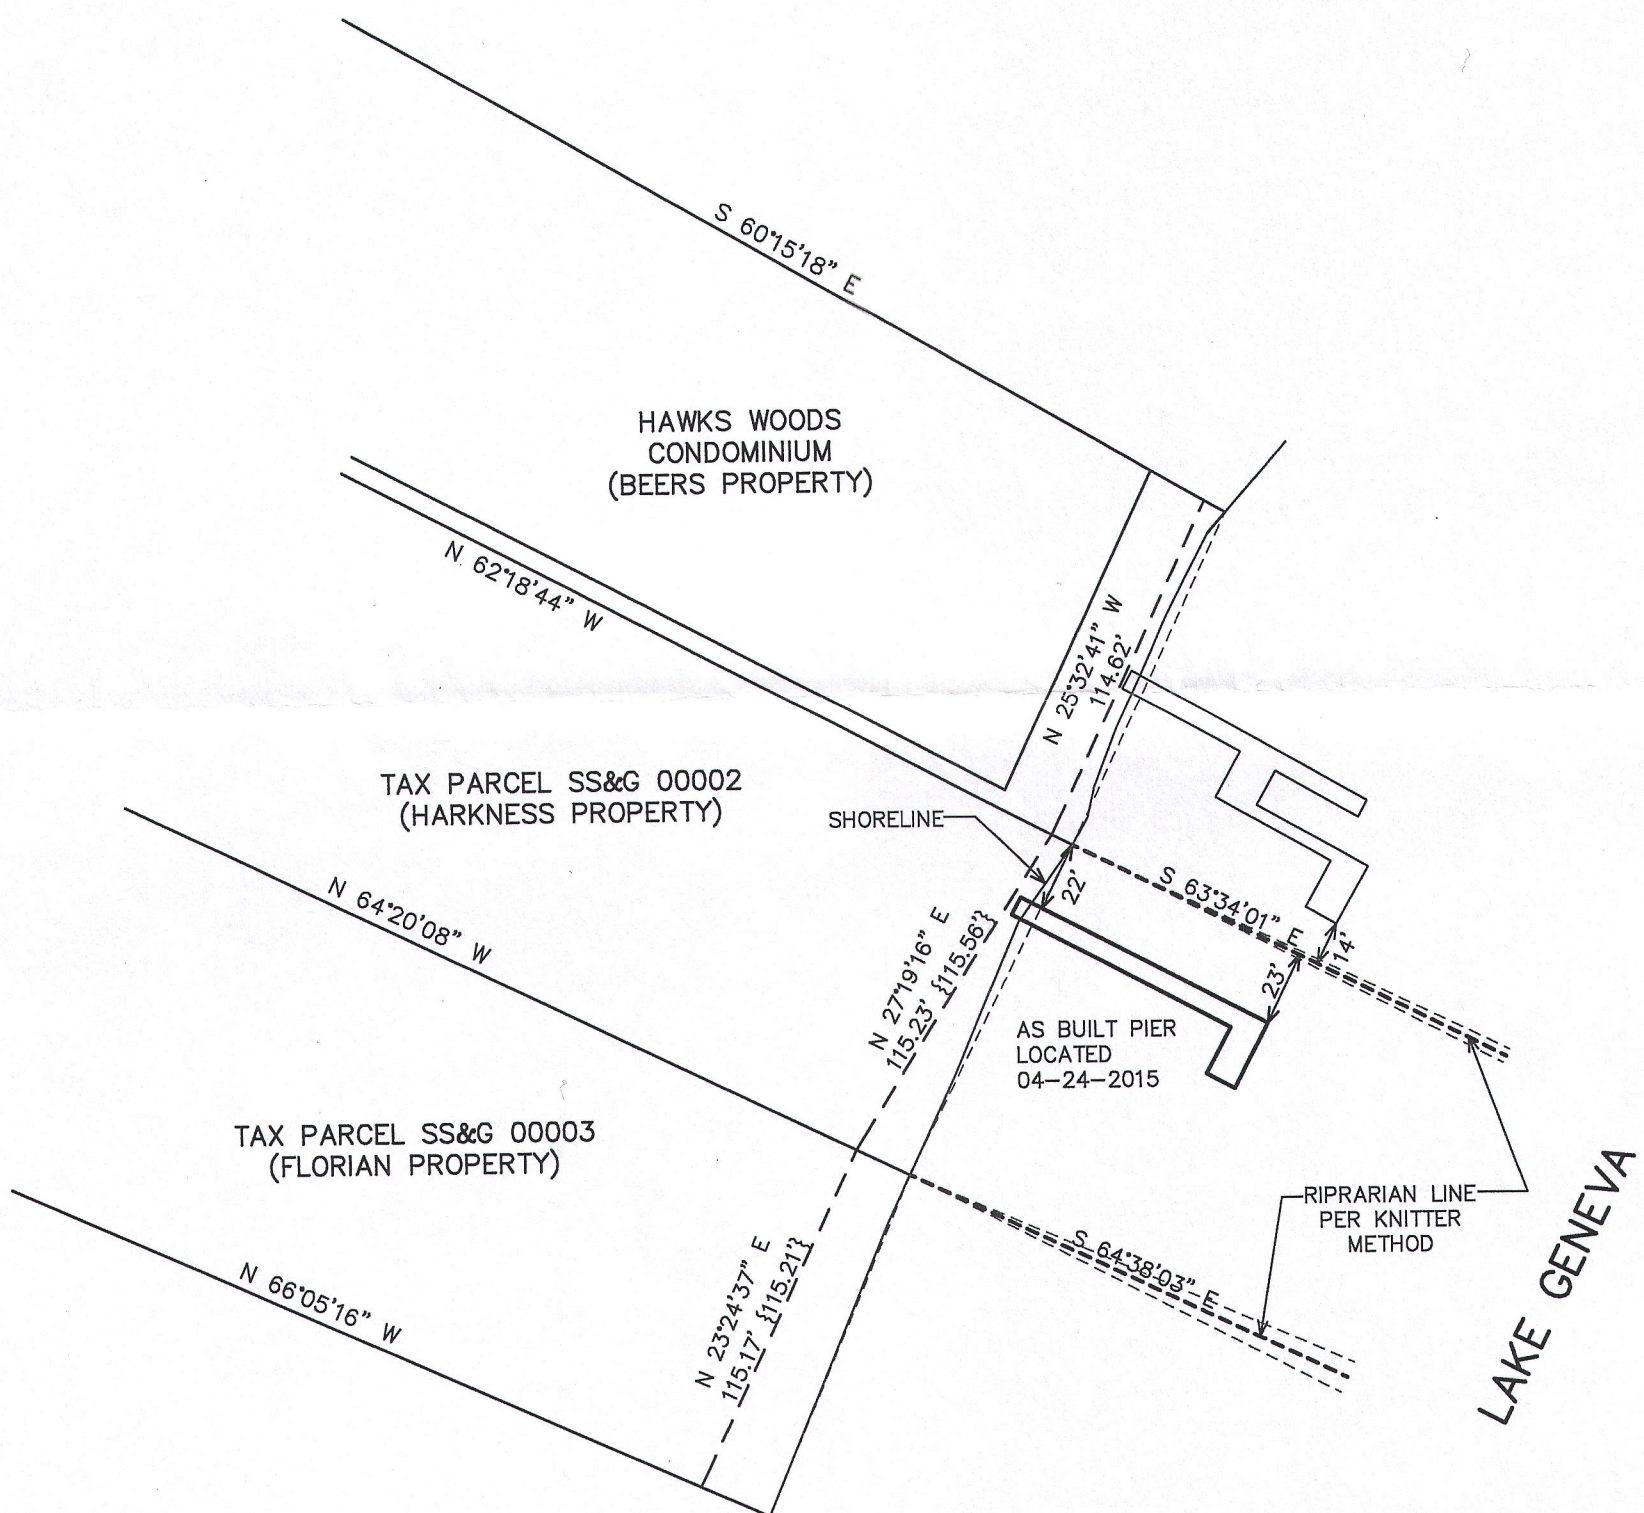

4/27/2015
[Signature]

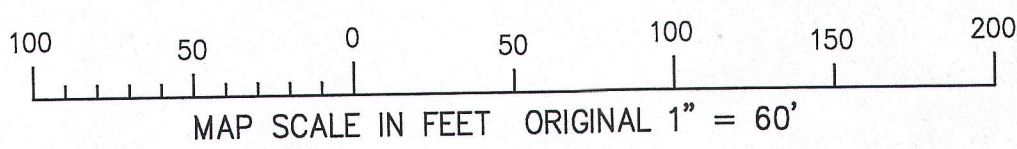

PROJECT: 9240
DATE: 3/23/2015
SHEET 1 OF 1

4/25/2015 X:\Projects\9240\Dead\RIPARIAN

APR 25 2015

884G-2 005-3134