

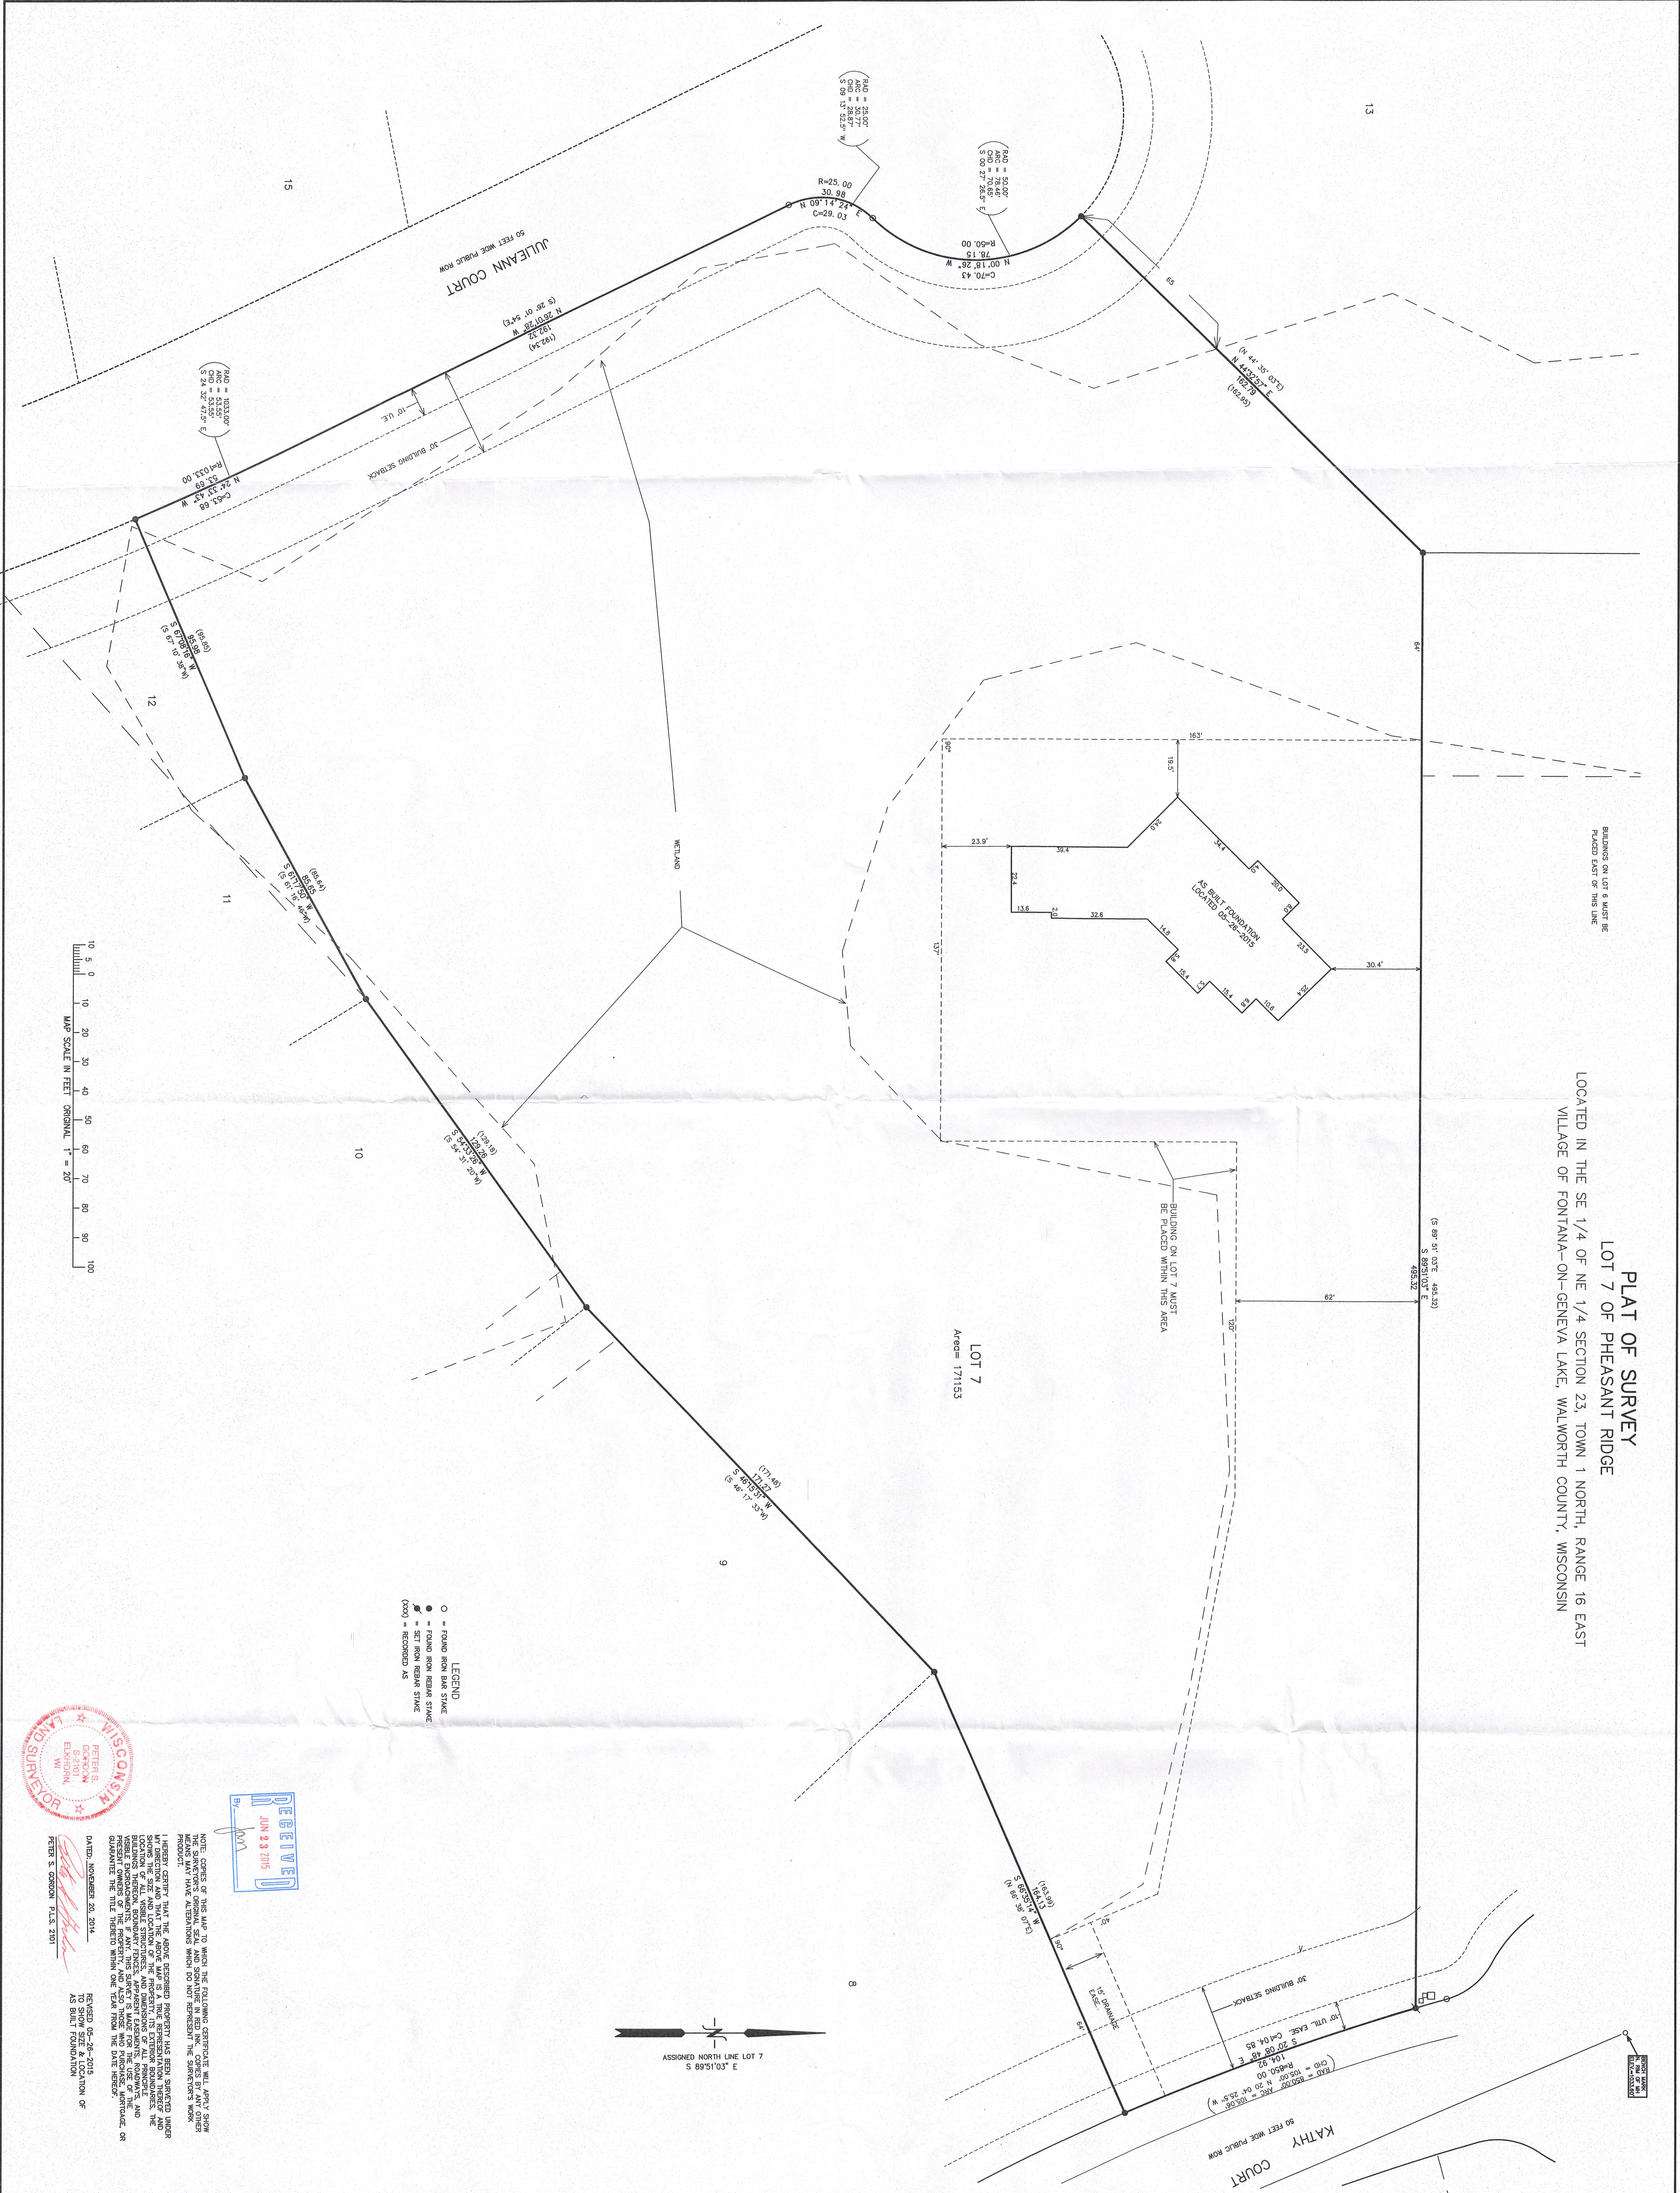


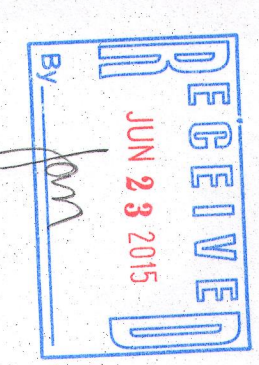


PLAT OF SURVEY
LOT 7 OF PHEASANT RIDGE
LOCATED IN THE SE 1/4 OF NE 1/4 SECTION 23, TOWN 1 NORTH, RANGE 16 EAST
VILLAGE OF FONTANA-ON-GENEVA LAKE, WALWORTH COUNTY, WISCONSIN

LEGEND
○ = FOUND IRON BAR STAKE
● = FOUND IRON REBAR STAKE
— = SET IRON REBAR STAKE
(XXX) = RECORDED AS

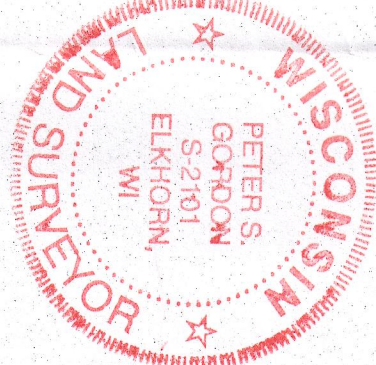

NOTE: COPIES OF THIS MAP TO WHICH THE FOLLOWING CERTIFICATE WILL APPLY SHALL BE THE PROPERTY OF THE SURVEYOR. ANY ALTERATIONS WHICH DO NOT REPRESENT THE SURVEYOR'S WORK SHALL BE AT THE RISK OF THE USER.
I HEREBY CERTIFY THAT THE ABOVE DESCRIBED PROPERTY HAS BEEN SURVEYED UNDER MY PERSONAL SUPERVISION AND THAT THE SURVEY WAS MADE IN ACCORDANCE WITH THE WISCONSIN SURVEYING ACT. I HAVE SHOWN THE SITE AND LOCATION OF THE PROPERTY, ITS EXISTING BOUNDARIES, THE EXISTING BUILDINGS, BOUNDARY LINES, APPARENT EASEMENTS, ROWS, AND OTHER FEATURES OF THE PROPERTY. I HAVE ALSO SHOWN THOSE WHO PURCHASED, ACQUIRED, OR GUARANTEED THE TITLE THEREIN WITHIN ONE YEAR FROM THE DATE HEREOF.
DATED: NOVEMBER 20, 2014
PETER S. GERSON P.L.S. 1201
RECEIVED: 05-26-2015
TO SHOW SIZE & LOCATION OF
AS BUILT FOUNDATION

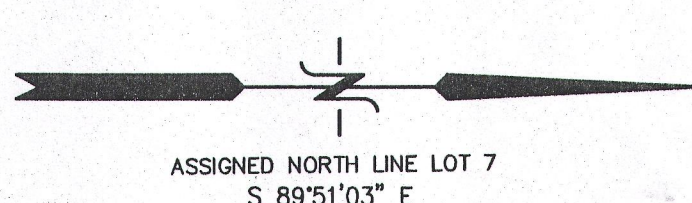

PROJECT NO. 3997.07.T	FARRIS, HANSEN & ASSOCIATES, INC. ENGINEERING - ARCHITECTURE - SURVEYING 7 RIDGWAY COURT P.O. BOX 437 ELKHORN, WISCONSIN 53121 OFFICE: (262) 723-2098 FAX: (262) 723-5886	WORK ORDERED BY: MARK GERARD 10033 N. WATERLEAF DRIVE MEQUON, WI 53092	GERARD RESIDENCE	
DATE 11-18-2014				
SHEET NO. 1 OF 1				

8PHR-7 005-34D