


N

SCALE 1"=20'  
O=IRON PIPE

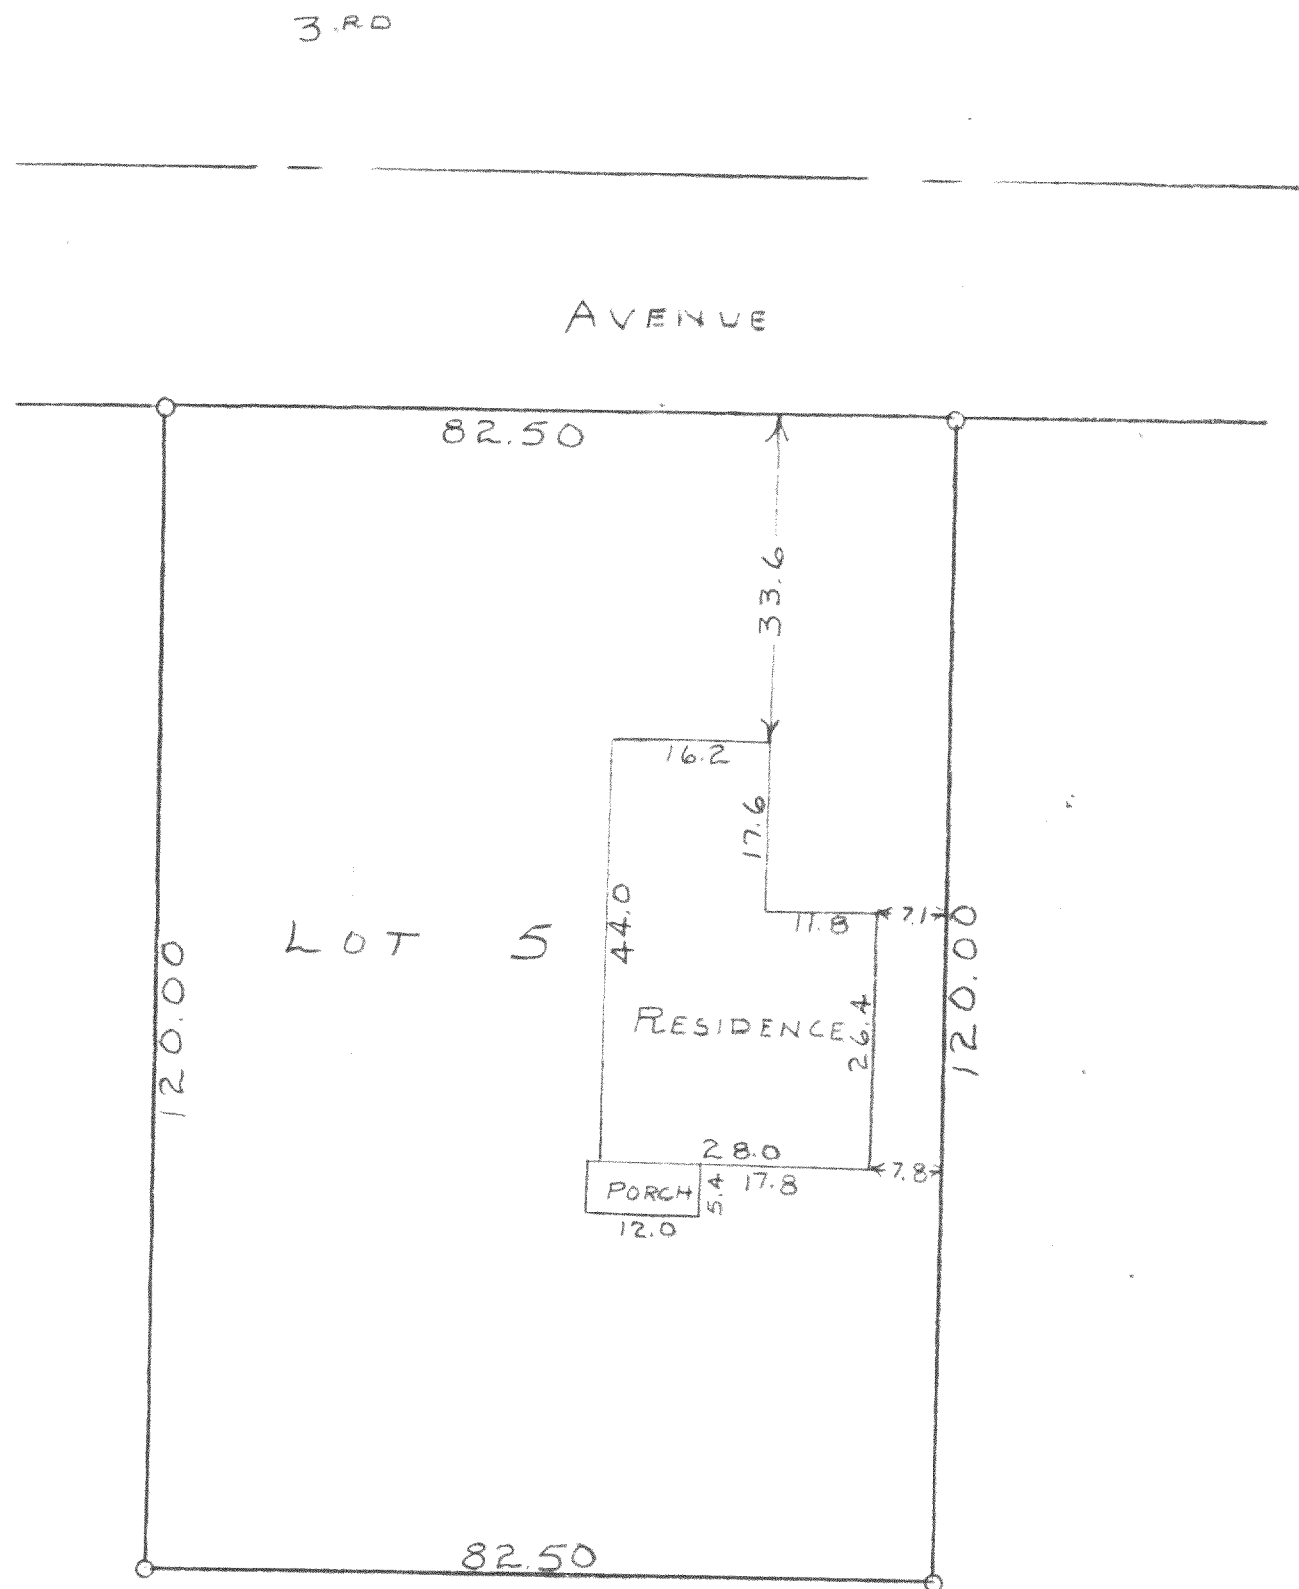

STATE OF WISCONSIN)  
WALWORTH COUNTY)

I, GEORGE T. DUNHAM, DO HEREBY CERTIFY THAT I HAVE SURVEYED THE  
PROPERTY DESCRIBED AS FOLLOWS:

LOT 5, BLOCK 9 OF THE ORIGINAL PLAT IN THE VILLAGE OF  
FONTANA ON GENEVA LAKE, WALWORTH COUNTY, WISCONSIN  
AND THAT THE PLAT SHOWN ABOVE IS A CORRECT REPRESENTATION OF THE  
PROPERTY LINES AND OF THE IMPROVEMENTS LOCATED THEREON  
DEC. 31, 1959

50P-42

*George T. Dunham*

GEORGE T. DUNHAM, SURVEYOR  
DELAVER, WISCONSIN

E-32