

WORK ORDERED BY:
GENEVA LAKE DREAM HOMES
908 S. WELLS STREET
LAKE GENEVA, WI 53147

FARRIS, HANSEN & ASSOCIATES, INC.
Engineering, Architecture, Surveying
7 Ridgway Court P.O. Box 437
ELKHORN, WISCONSIN 53121
Office: (262) 723-2098
Fax: (262) 723-5886

REVISIONS

PROJECT NO.
3997.27.06



DATE:
08/01/02

SHEET NO.
1 OF 1

PLAT OF SURVEY



LOT 27 OF PHEASANT RIDGE SUBDIVISION

LOCATED IN THE SE 1/4 OF NE 1/4 SECTION 23, TOWN 1 NORTH, RANGE 16 EAST
VILLAGE OF FONTANA-ON-GENEVA LAKE, WALWORTH COUNTY, WISCONSIN

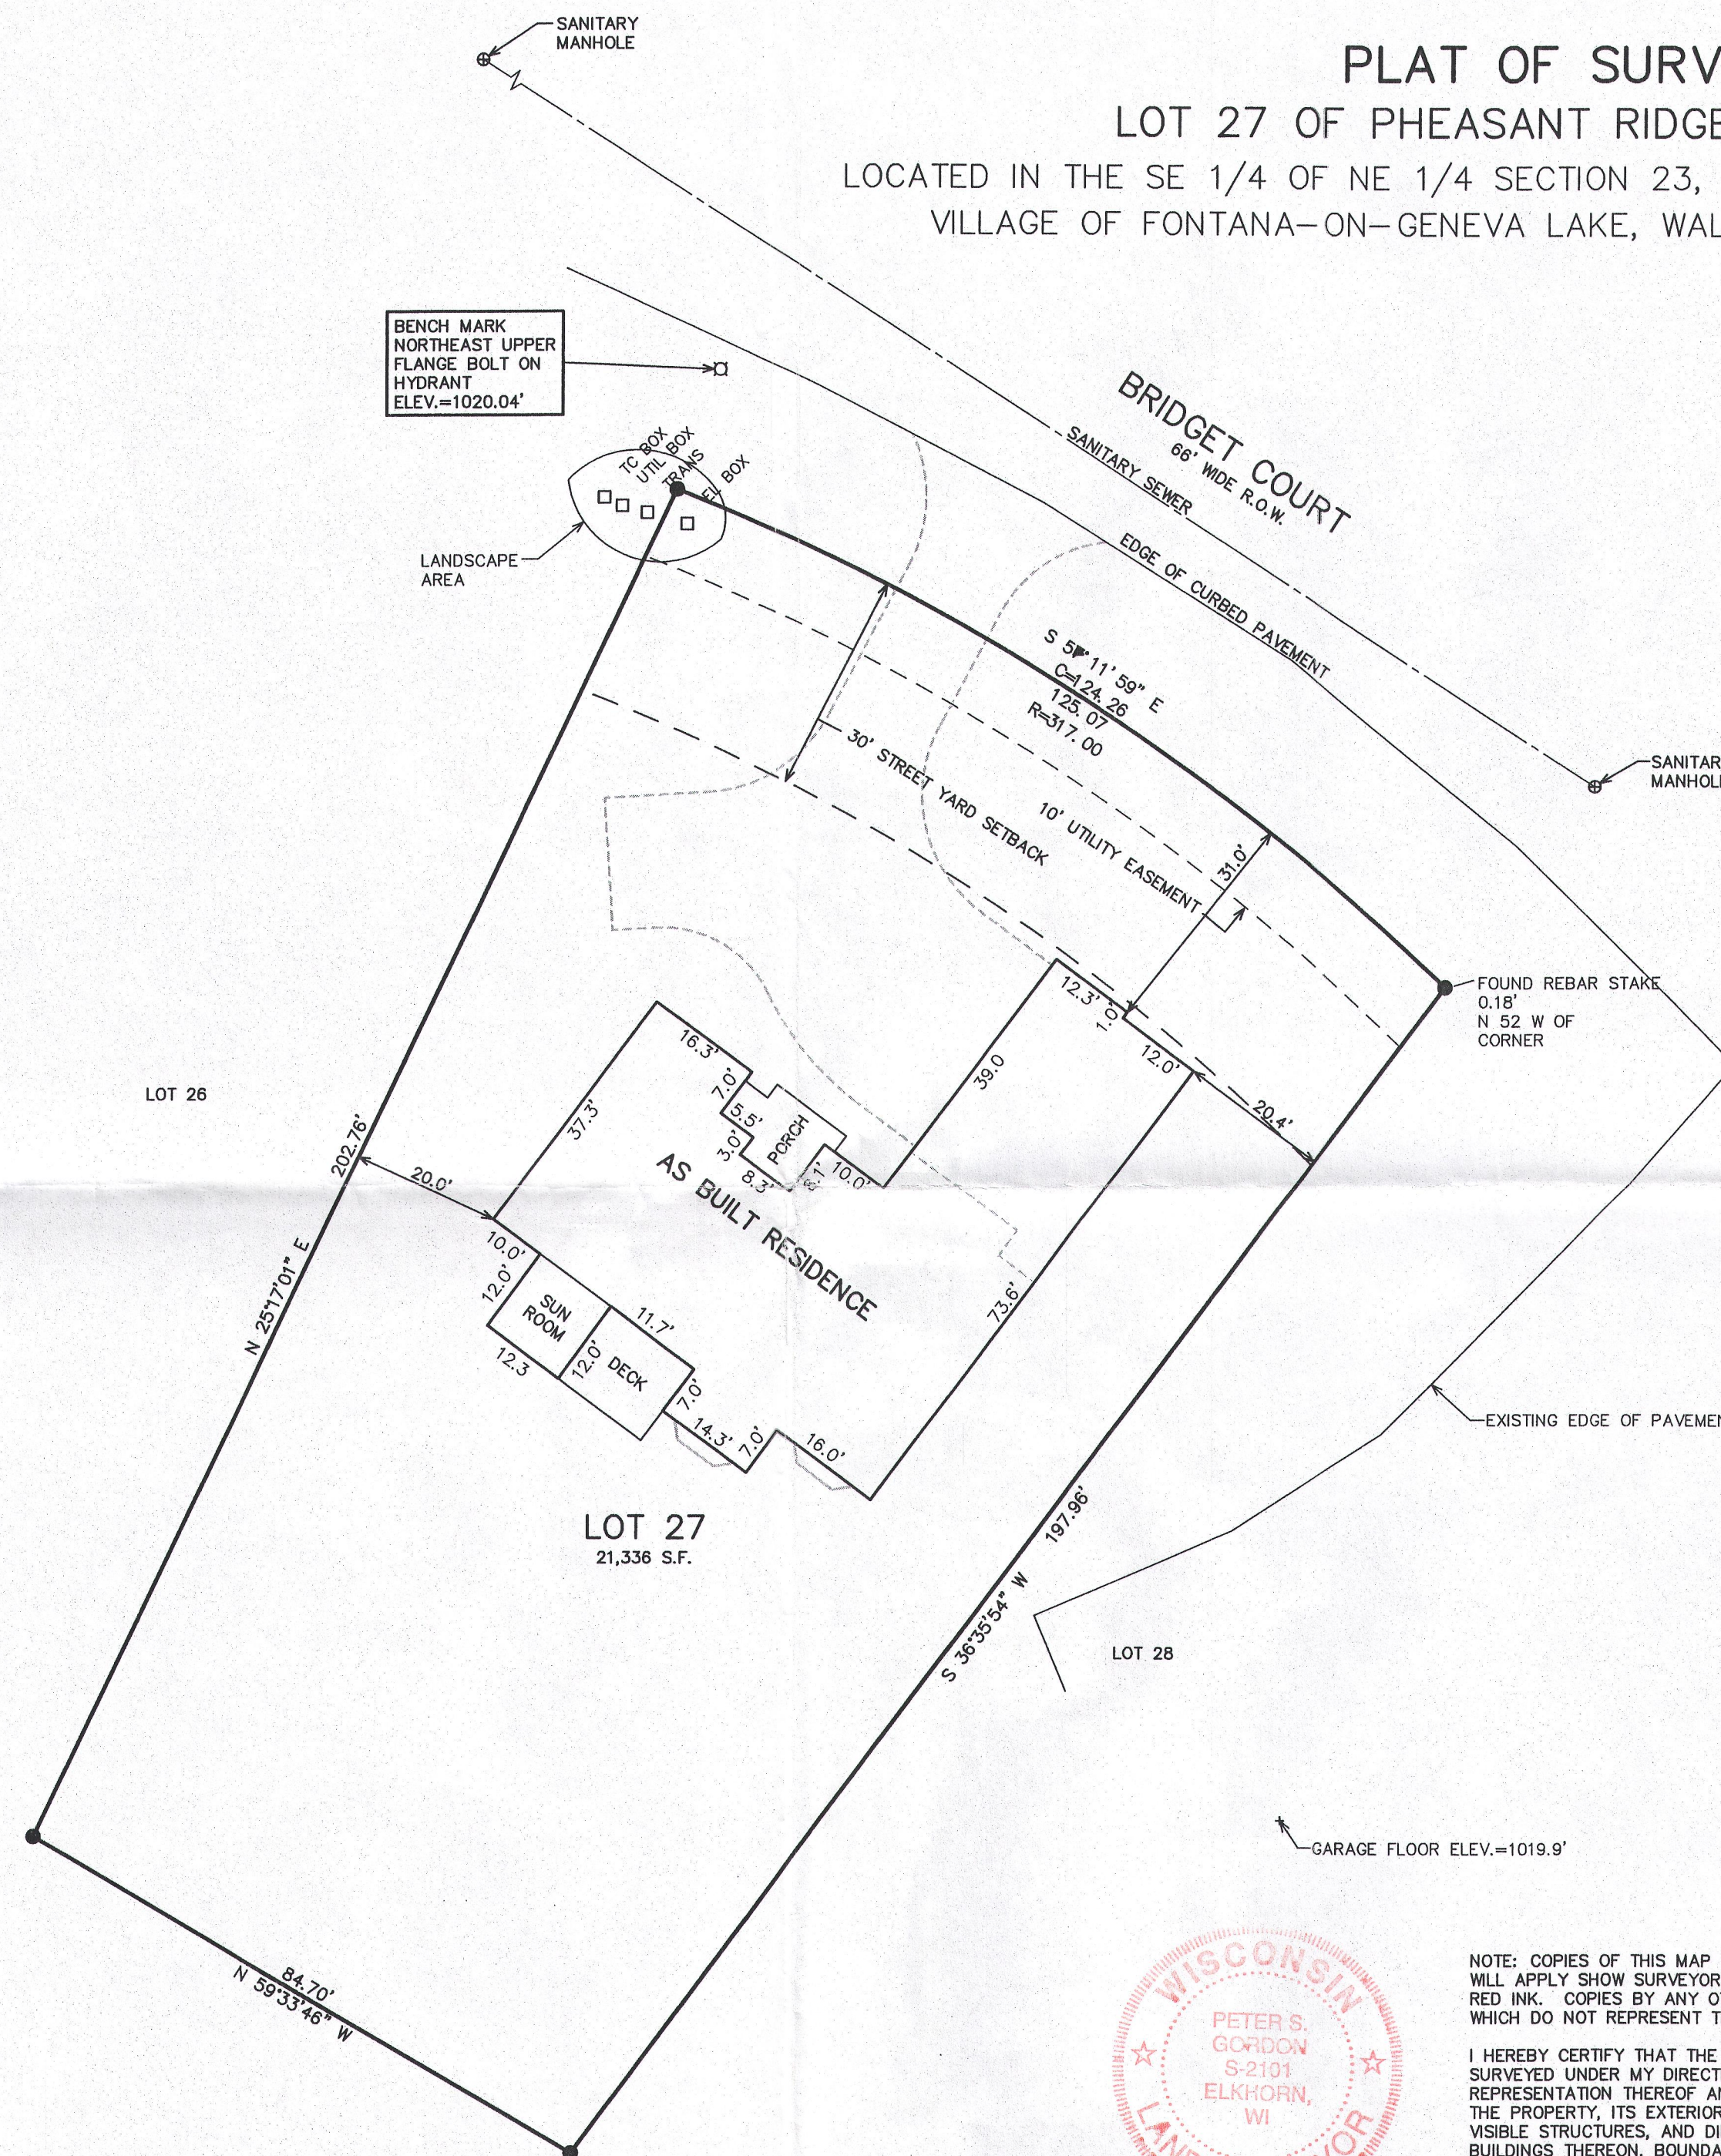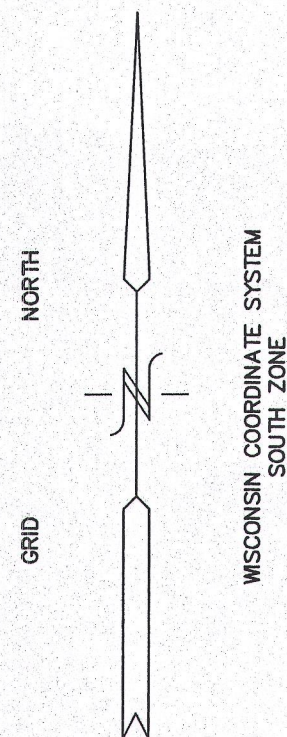

LEGEND

● = FOUND IRON REBAR STAKE

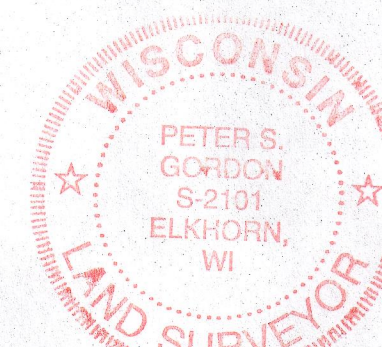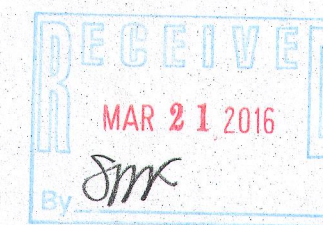

REVISED 02-02-2016
TO SHOW SIZE & LOCATION OF
AS BUILT RESIDENCE

NOTE: COPIES OF THIS MAP TO WHICH THE FOLLOWING CERTIFICATE
WILL APPLY SHOW SURVEYOR'S ORIGINAL SEAL AND SIGNATURE IN
RED INK. COPIES BY ANY OTHER MEANS MAY HAVE ALTERATIONS
WHICH DO NOT REPRESENT THE SURVEYOR'S WORK PRODUCT.

I HEREBY CERTIFY THAT THE ABOVE DESCRIBED PROPERTY HAS BEEN
SURVEYED UNDER MY DIRECTION AND THAT THE ABOVE MAP IS A TRUE
REPRESENTATION THEREOF AND SHOWS THE SIZE AND LOCATION OF
THE PROPERTY, ITS EXTERIOR BOUNDARIES, THE LOCATION OF ALL
VISIBLE STRUCTURES, AND DIMENSIONS OF ALL PRINCIPLE
BUILDINGS THEREON, BOUNDARY FENCES, APPARENT EASEMENTS,
ROADWAYS, AND VISIBLE ENCROACHMENTS, IF ANY. THIS SURVEY IS
MADE FOR THE USE OF THE PRESENT OWNERS OF THE PROPERTY, AND
ALSO THOSE WHO PURCHASE, MORTGAGE, OR GUARANTEE THE TITLE
THERE TO WITHIN ONE YEAR FROM THE DATE HEREOF.

DATED: MAY 12, 2006


Peter S. Gordon
PETER S. GORDON R.L.S. 2101

REVISED 8/27/2013-KB
TO SHOW TOPOGRAPHICAL INFORMATION

REVISED 9/6/2013-KB
TO SHOW SIZE & LOCATION OF
PROPOSED RESIDENCE

05-06-2015

REVISED 6/10/2015-KB
TO SHOW ADJUSTED LOCATION OF RES.

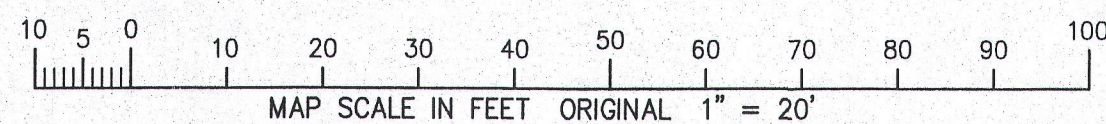

FEB 02 2016

SPHR-27

005-3218