

FARRIS, HANSEN & ASSOCIATES, INC.

ENGINEERING — ARCHITECTURE — SURVEYING
7 RIDGWAY COURT — P.O. BOX 437 — ELKHORN, WISCONSIN 53121
PHONE: (262) 723-2098 FAX: (262) 723-5886

PLAT OF SURVEY

LOT 1 OF BLOCK 12 OF THE ORIGINAL PLAT OF
THE VILLAGE OF FONTANA
LOCATED IN THE NW 1/4 SECTION 14
TOWN 1 NORTH, RANGE 16 EAST
WALWORTH COUNTY, WI.


— WORK ORDERED BY —
MARK SCHNEIDER
203 VERNON STREET
WILLIAMS BAY, WI.

ASSIGNED EAST LINE LOT 1 BL. 12
S 00°00'00" E

FIFTH AVE
(49.5' WIDE)

FOUND PIPE DISTURBED
LEANS N'LY
0.37' NORTH &
0.19' EAST OF CORNER

NORTH LAKESHORE DRIVE
(66' WIDE)

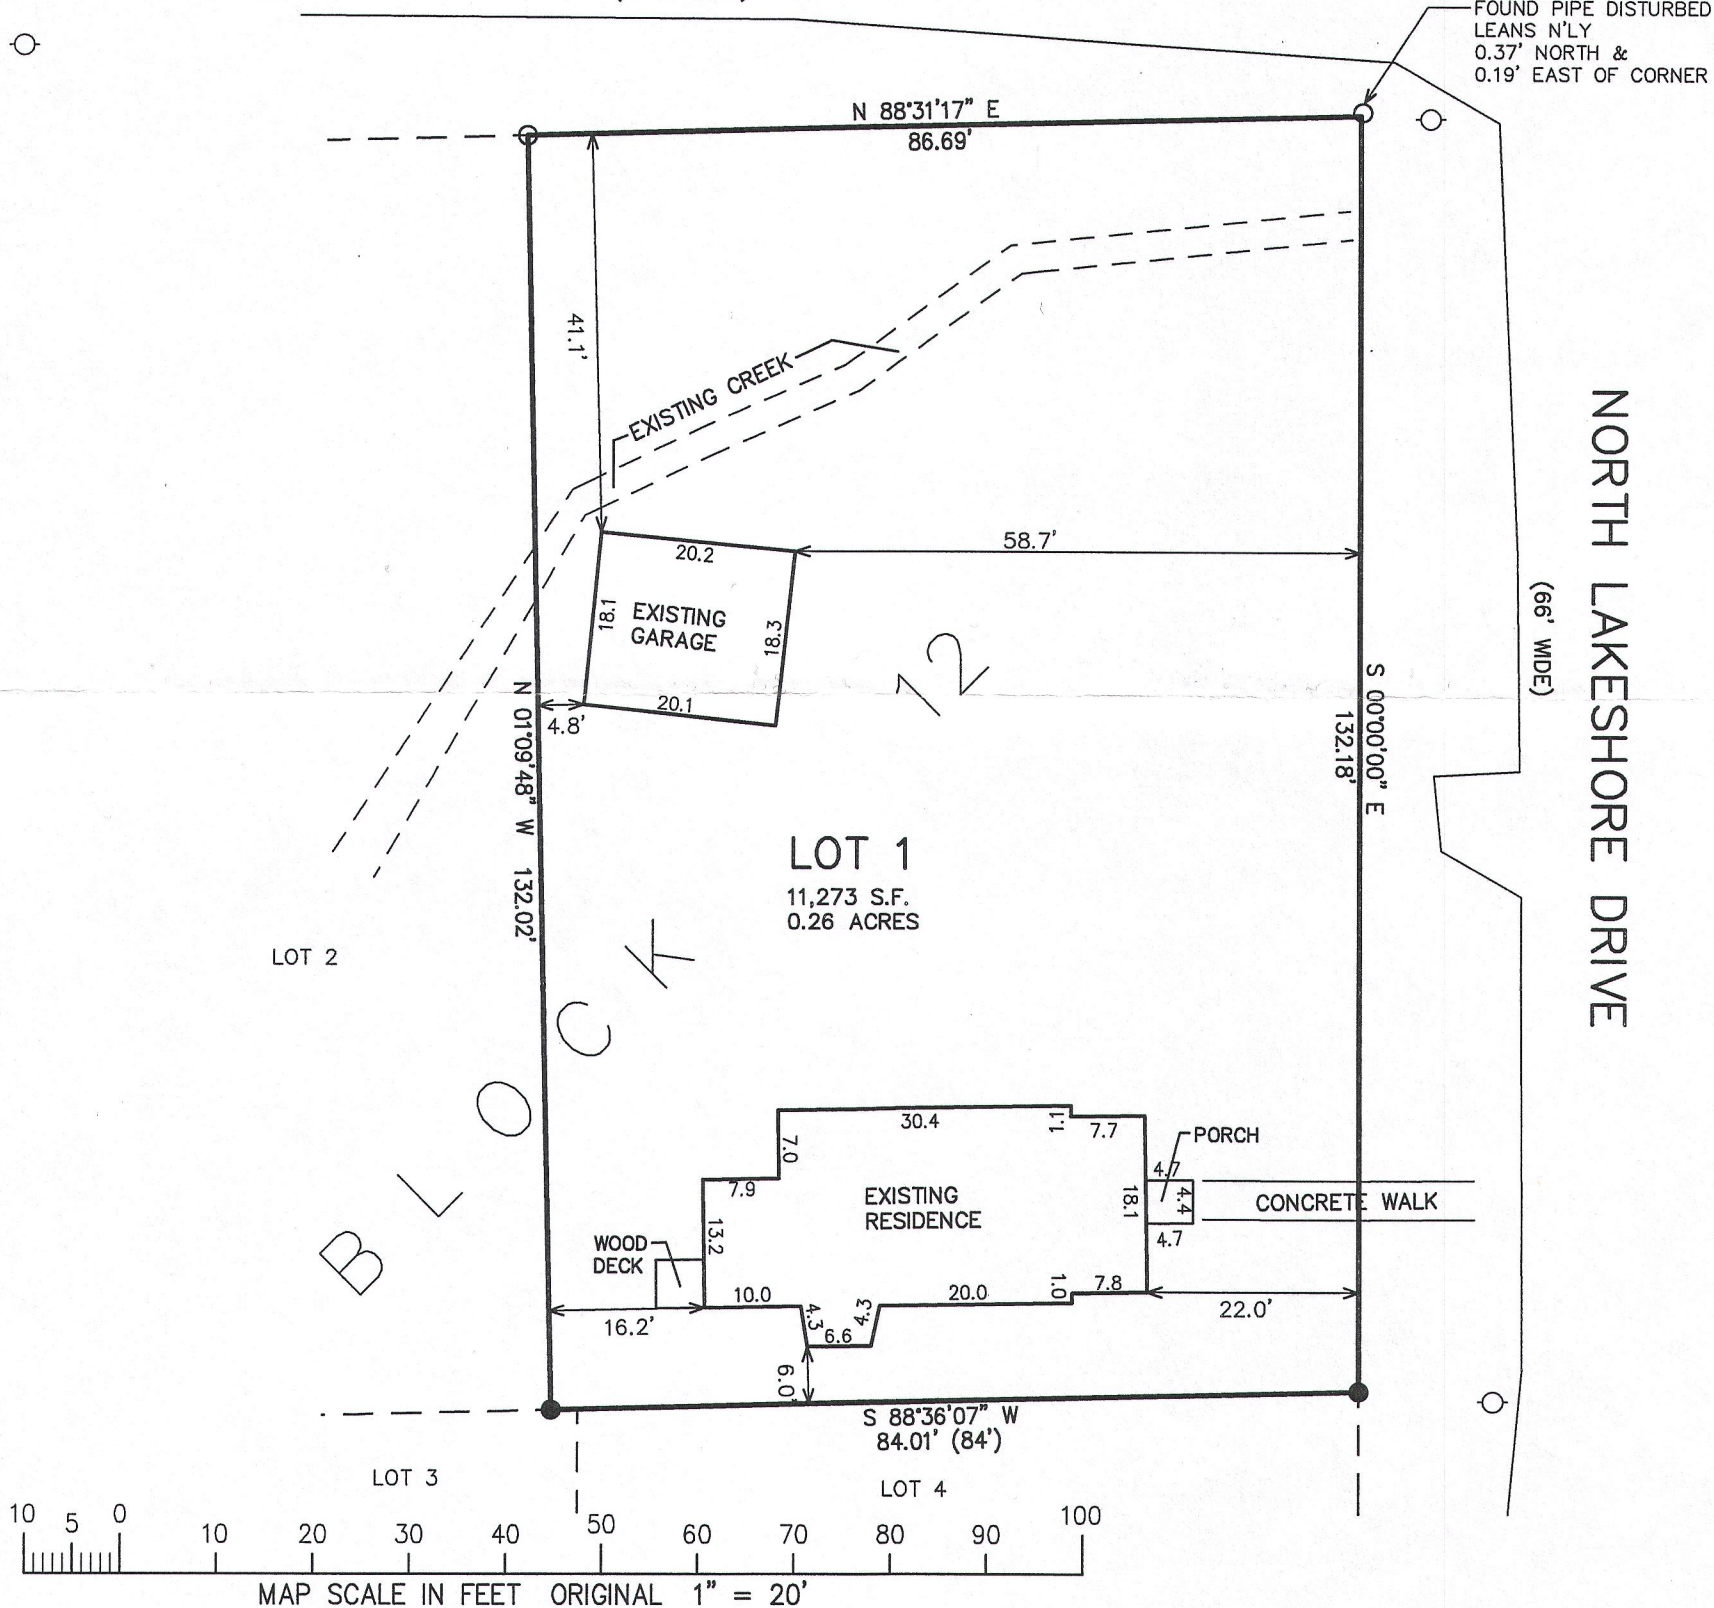

NOTE: COPIES OF THIS MAP TO WHICH THE FOLLOWING CERTIFICATE
WILL APPLY SHOW THE SURVEYOR'S ORIGINAL SEAL AND SIGNATURE
IN RED INK. COPIES BY ANY OTHER MEANS MAY HAVE ALTERATIONS
WHICH DO NOT REPRESENT THE SURVEYOR'S WORK PRODUCT.



I HEREBY CERTIFY THAT THE ABOVE DESCRIBED PROPERTY HAS BEEN
SURVEYED UNDER MY DIRECTION AND THAT THE ABOVE MAP IS A TRUE
REPRESENTATION THEREOF AND SHOWS THE SIZE AND LOCATION OF
THE PROPERTY AND ITS EXTERIOR BOUNDARIES. THIS SURVEY IS
MADE FOR THE USE OF THE PRESENT OWNERS OF THE PROPERTY, AND
ALSO THOSE WHO PURCHASE, MORTGAGE, OR GUARANTEE THE TITLE
THERE TO WITHIN ONE YEAR FROM THE DATE HEREOF.

DATED: MAY 13, 2016

Peter S. Gordon
PETER S. GORDON P.L.S. 2101

LEGEND

- = FOUND IRON PIPE STAKE
- = FOUND IRON REBAR STAKE
- (XXX) = RECORDED AS

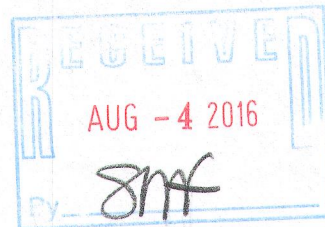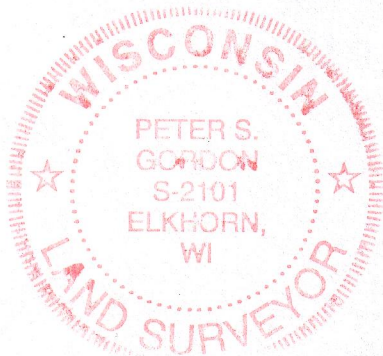

PROJECT: 9514
DATE: 05-13-2016
SHEET 1 OF 1