


GEORGE T. DUNHAM
SURVEYING & SUBDIVIDING
DELAVAN, WISCONSIN

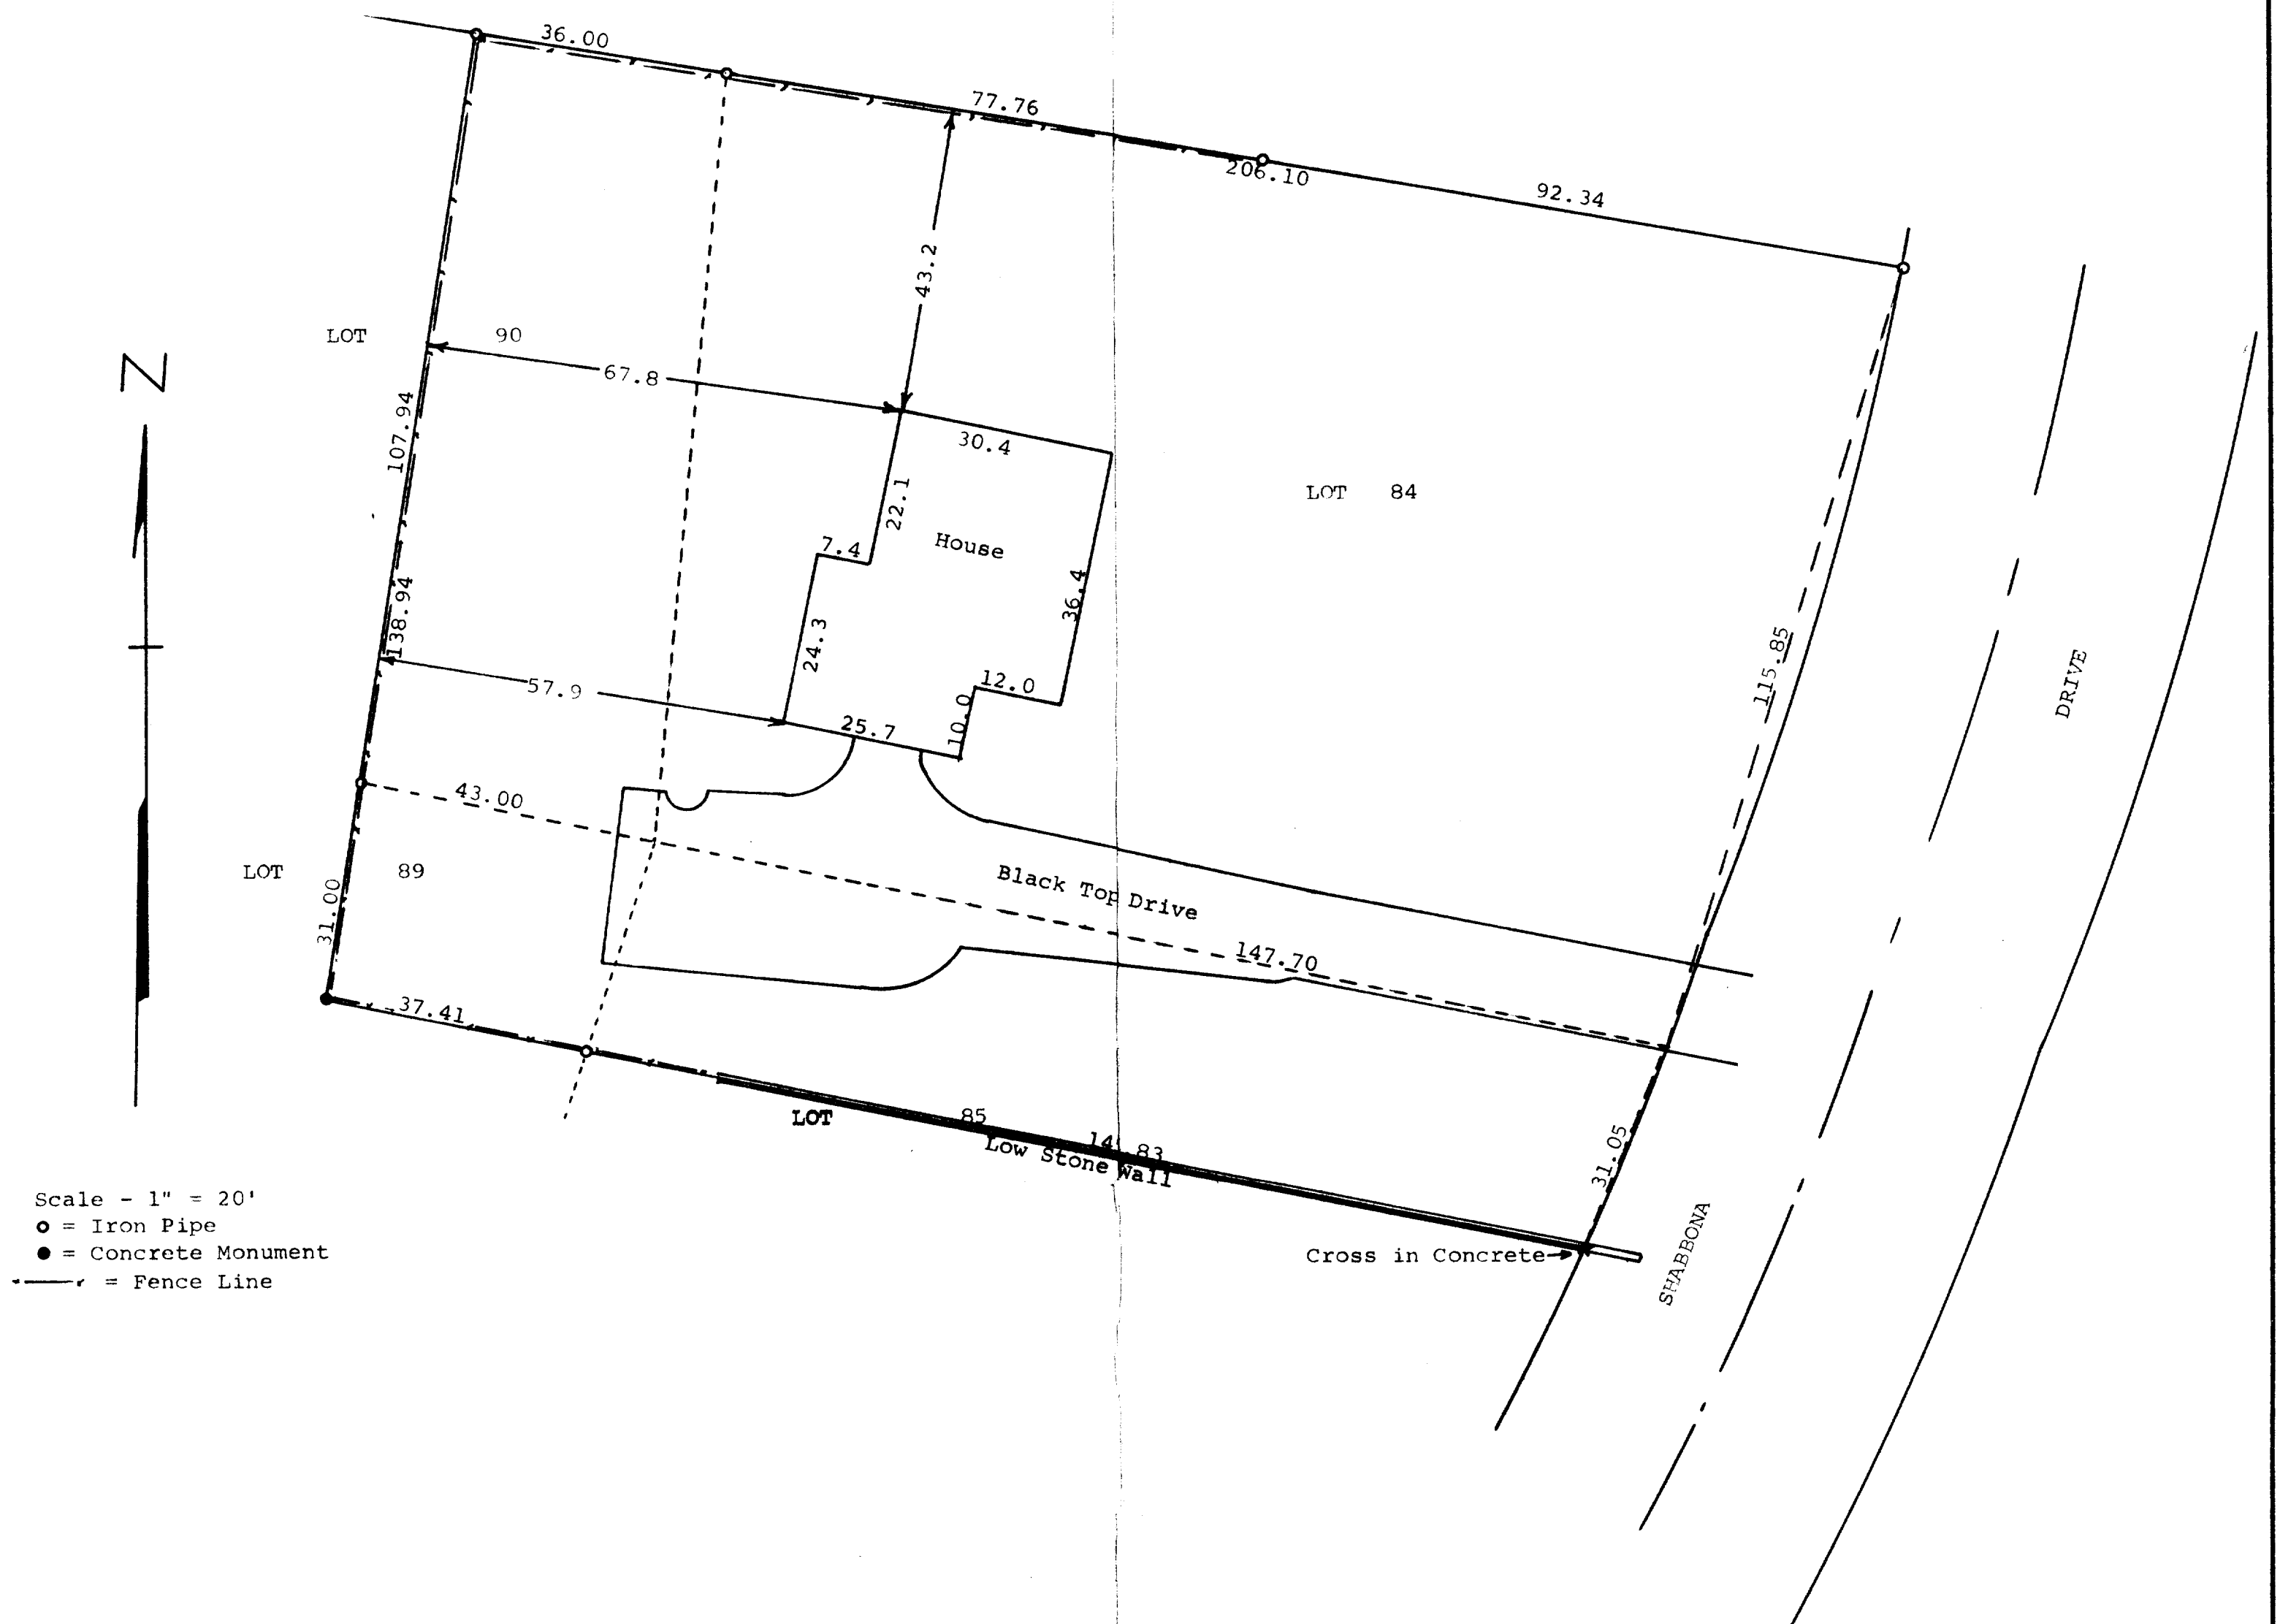

Plat of survey of Lot 84 and parts of Lot 85, 89 and 90 of
Unit No. 2 of Country Club Estates, Village of Fontana on
Geneva Lake, Walworth County, Wisconsin.
May 3, 1974

George T. Dunham
George T. Dunham, Surveyor

